


21707102000

U. S. PUBLIC LAND SURVEY MONUMENT RECORD

SECTION 11 T 17 N, R 7 W, TOWN OF ONALASKA

LA CROSSE COUNTY

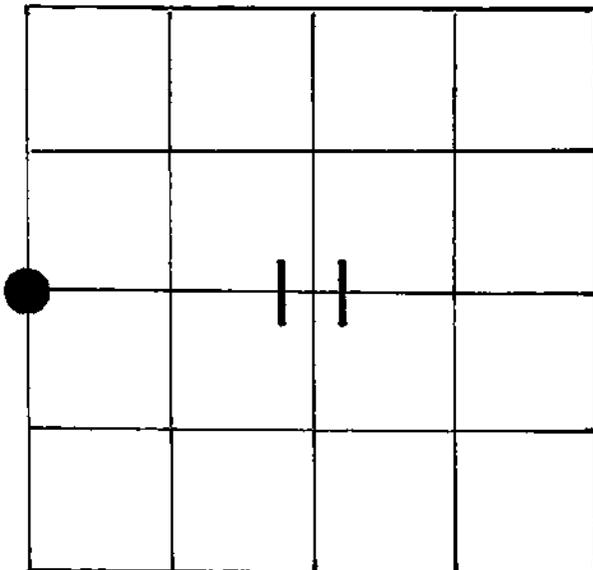

LOCATION OF LANDMARK

Crew: WILLIAM C. JUNG

Date: 5/28/1993

Describe any record evidence, monument evidence, testimonial evidence or any other material evidence you considered and whether the monument was found or restored through acceptance of an obliterated evidence location.

I set this corner at a computed location: on line with the section corners North and South, and on line with a line with the West 1/4 corner and occupied Center 1/4 corner of Section 10 extended East. I believe that what appears to be an error of one chain from the original survey belongs in the 1/2 mile to the North. I set a brass capped Lunde marker at the corner.

Describe or show any material discrepancy between the location of the restored corner and that of the corner previously restored or reestablished.

I totally disagree with Murphy's previously computed corner location.

WISCONSIN COORDINATE SYSTEM

North

East

Theta Angle

Horiz. Order

Vert. Order

TYPE OF LANDMARK


Set brass cap Lunde marker.

BEARINGS ARE REFERENCED TO


True North

RECORD OF DURABLE WITNESS MONUMENTS

NO	DESCRIPTION	BEARING	DISTANCE
1	Set P.K. Nail in NW-side 9" Hickory	S 86° W	Sl.= 20.68'
2	Set P.K. Nail in W.-side 5" Tree(unidentified)	N 26° W	3.51 Ft.
3	Measurement to center of 24" Burr Oak	N 20° W	Sl.= 47.55'
4	Set P.K. NAIL IN 3½" Hickory-south side	S 80° E	9.71 Ft.

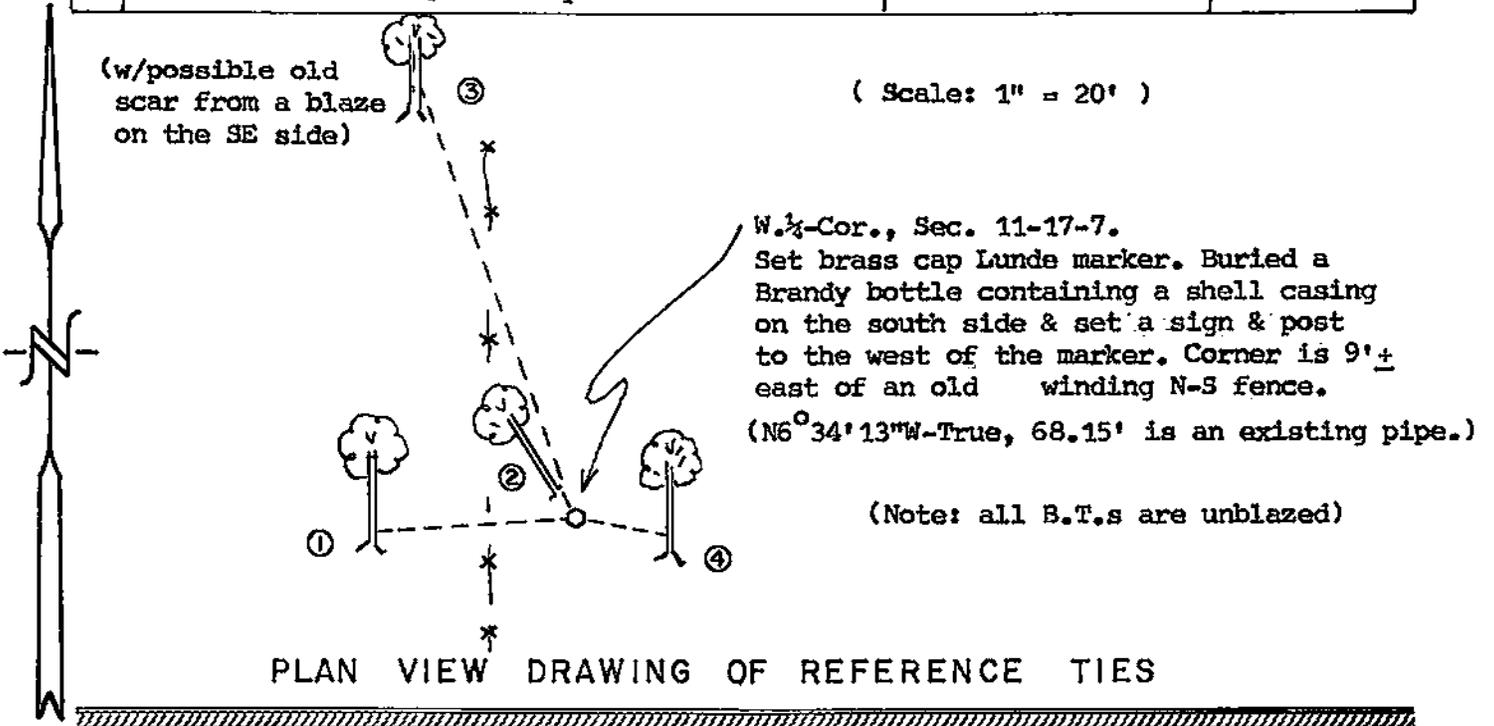

MAP SHOWING DISTANCE AND DIRECTION TO OTHER PUBLIC LAND SURVEY CORNERS USED FOR REESTABLISHING THE CORNER

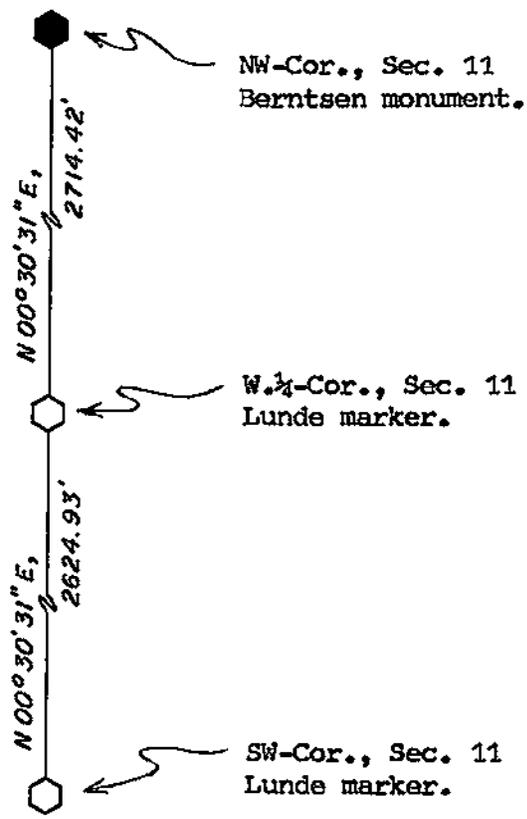

I, William C. Jung, County Surveyor
HEREBY CERTIFY THAT THE CORNER LOCATION SHOWN ON THIS RECORD WAS DETERMINED BY ME OR UNDER MY DIRECTION AND CONTROL AND THAT THIS U. S. PUBLIC LAND SURVEY MONUMENT RECORD IS CORRECT AND COMPLETE TO THE BEST OF MY KNOWLEDGE AND BELIEF.

William C. Jung 2/11/94
Signature Date

