


21707110000

## U. S. PUBLIC LAND SURVEY MONUMENT RECORD

SECTION 11 T 17 N, R 7 W, TOWN OF ONALASKA

LA CROSSE COUNTY

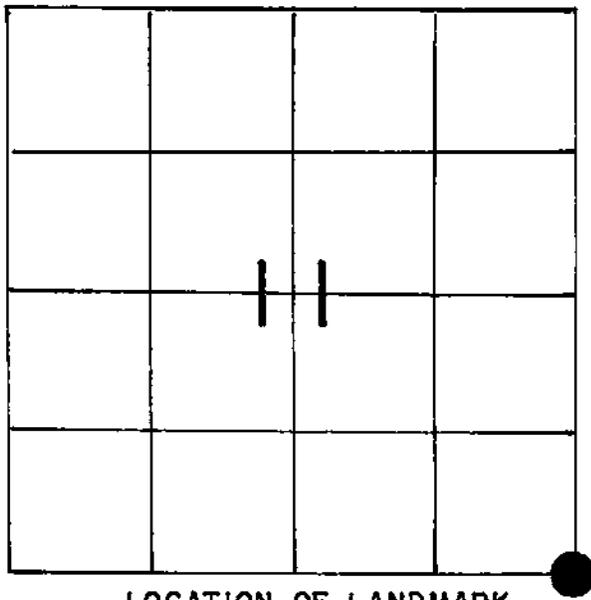

LOCATION OF LANDMARK

## WISCONSIN COORDINATE SYSTEM

North

East

Theta Angle

Horiz. Order

Vert. Order

## TYPE OF LANDMARK

Set brass cap Lunde marker.

## BEARINGS ARE REFERENCED TO

True North

Crew: WILLIAM C. JUNG

Date: 5/06/1993

Describe any record evidence, monument evidence, testimonial evidence or any other material evidence you considered and whether the monument was found or restored through acceptance of an obliterated evidence location.


I was able to re-establish the old occupied corner location by pushing the old downed line to the South up to the North and by pushing the old downed line to the West back to the East. I accepted the projection of these old line fences as the best available evidence of the original government corner position and monumented it with a brass capped Lunde marker.

Describe or show any material discrepancy between the location of the restored corner and that of the corner previously restored or reestablished.

I totally disagree with Murphy's previously computed corner location.


RECORD OF DURABLE WITNESS MONUMENTS

NO	DESCRIPTION	MAGNETIC	SLOPE
		BEARING	DISTANCE
1	Set P.K. Nail in N.-side 11" Oak	S 89° W	95.06 Ft.
2	Set P.K. Nail in SE-side 10" Oak	S 65° W	54.90 Ft.
3	Set P.K. Nail in SE-side 7" Oak	S 46° W	51.62 Ft.
4	Set P.K. Nail in SE-side 4½" Oak	S 25° W	58.51 Ft.

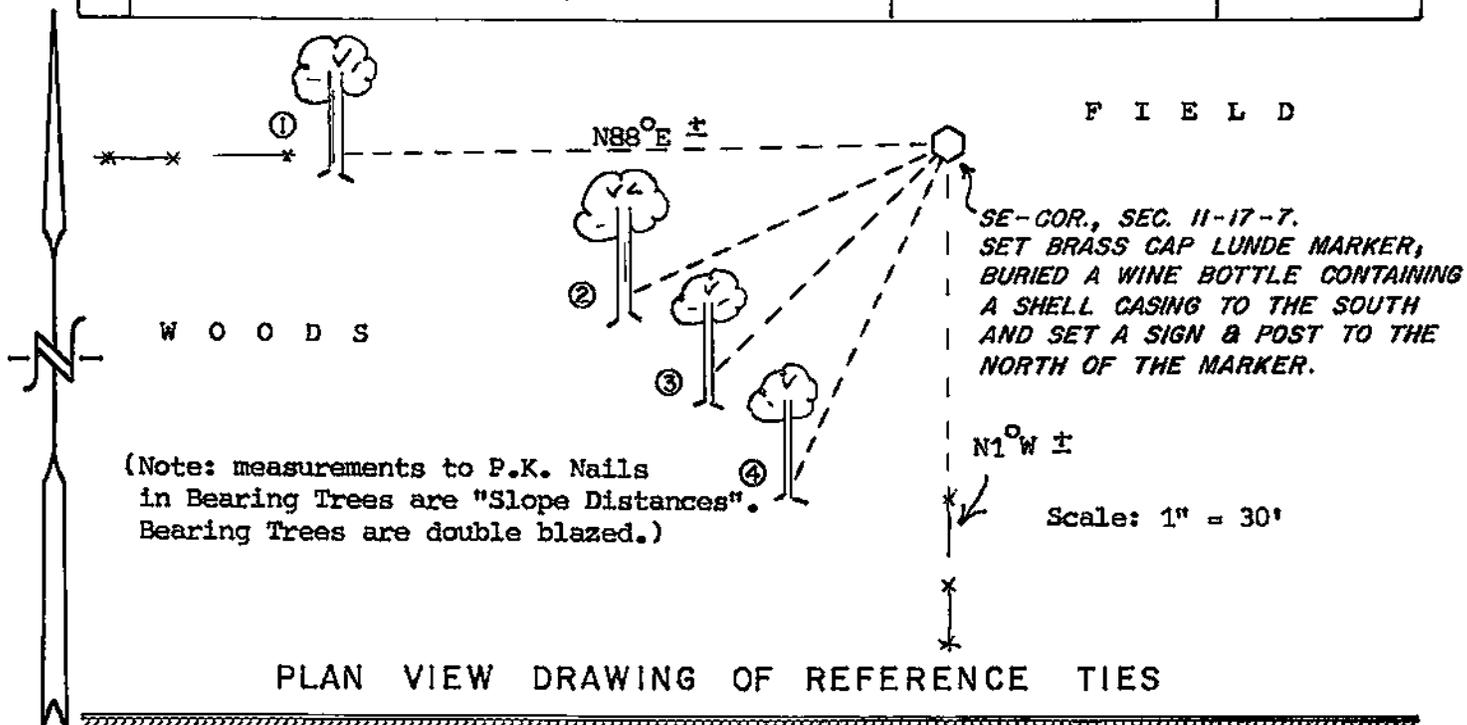

MAP SHOWING DISTANCE AND DIRECTION TO OTHER PUBLIC LAND SURVEY CORNERS USED FOR REESTABLISHING THE CORNER

(not to scale)

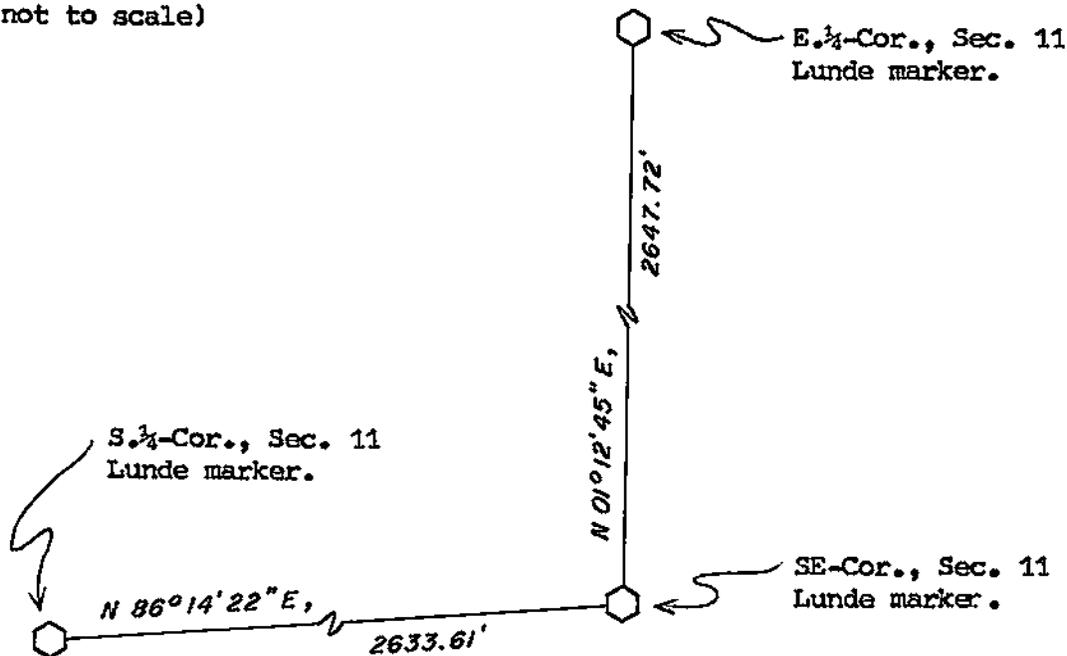

I, William C. Jung, County Surveyor  
 HEREBY CERTIFY THAT THE CORNER LOCATION SHOWN ON THIS RECORD  
 WAS DETERMINED BY ME OR UNDER MY DIRECTION AND CONTROL AND  
 THAT THIS U. S. PUBLIC LAND SURVEY MONUMENT RECORD IS CORRECT  
 AND COMPLETE TO THE BEST OF MY KNOWLEDGE AND BELIEF.

William C. Jung                      2/11/94  
 Signature                                      Date

