


U. S. PUBLIC LAND SURVEY MONUMENT RECORD

SECTION 11 T 17 N, R 7 W, TOWN OF ONALASKA

LA CROSSE COUNTY

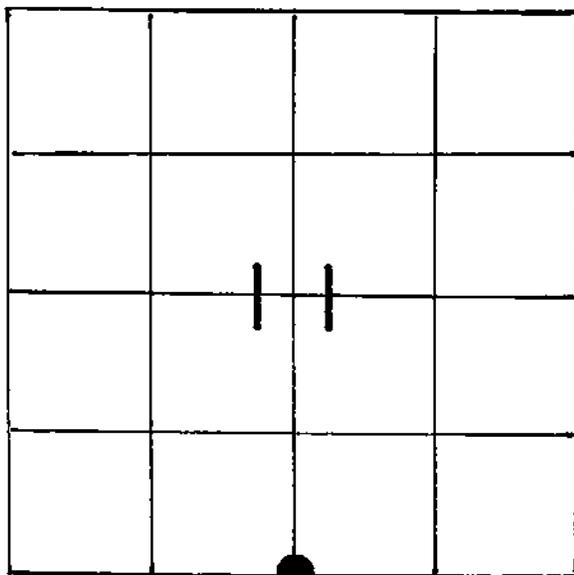

LOCATION OF LANDMARK

WISCONSIN COORDINATE SYSTEM

North

East

Theta Angle

Horiz. Order

Vert. Order

TYPE OF LANDMARK

Set brass cap Lunde marker.

BEARINGS ARE REFERENCED TO

True North

Crew: WILLIAM C. JUNG

Date: 5/18/1993

Describe any record evidence, monument evidence, testimonial evidence or any other material evidence you considered and whether the monument was found or restored through acceptance of an obliterated evidence location.

I set the corner off of what I believe to be the remains of an original witness/bearing tree. I set a brass capped Lunde marker at the corner.

Describe or show any material discrepancy between the location of the restored corner and that of the corner previously restored or reestablished.

N18°E, 24.75 feet is an existing iron bar used in previous survey work. I did not accept this as the corner.

