


21707120000

U. S. PUBLIC LAND SURVEY MONUMENT RECORD

SECTION 12 T 17 N, R 7 W, TOWN OF Onalaska

LA CROSSE COUNTY

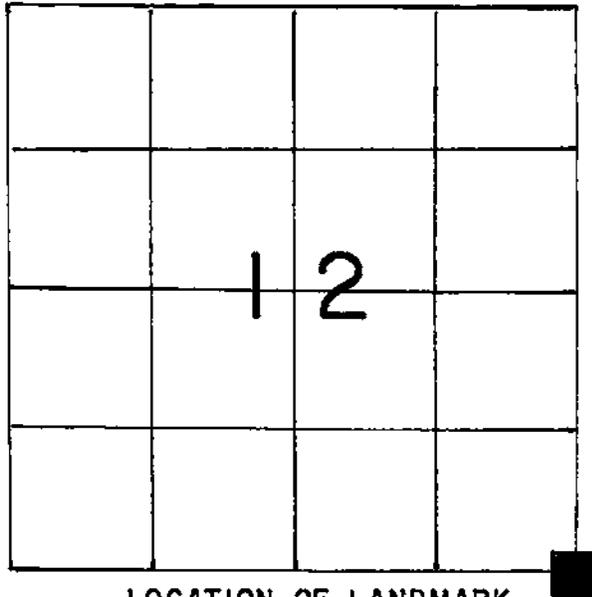

LOCATION OF LANDMARK

Crew: William C. Jung

Date: 5/3/93

Describe any record evidence, monument evidence, testimonial evidence or any other material evidence you considered and whether the monument was found or restored through acceptance of an obliterated evidence location.

I found a stone that had been used in previous survey work and accepted it as the best available evidence of the original government corner position. The stone has a deep cross, measures 9"x12", and is up 8". To the Northeast I set a sign and post.

Describe or show any material discrepancy between the location of the restored corner and that of the corner previously restored or reestablished.

None known.

WISCONSIN COORDINATE SYSTEM

North

East

Theta Angle

Horiz. Order

Vert. Order

TYPE OF LANDMARK

Stone

BEARINGS ARE REFERENCED TO

