


U. S. PUBLIC LAND SURVEY MONUMENT RECORD

SECTION 13 T 17 N, R 7 W, TOWN OF Onalaska
La Crosse COUNTY

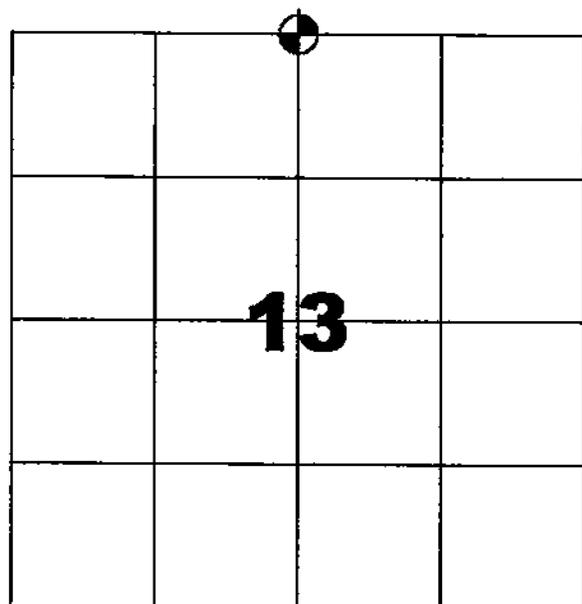

WISCONSIN COORDINATE SYSTEM
North
East
Theta Angle
Horiz. Order
Vert. Order
TYPE OF LANDMARK
3/4" x 24" Iron Bar
BEARINGS ARE REFERENCED TO
La Crosse County Coordinate System

LOCATION OF LANDMARK

CREW: MICHAEL HARDING
 JAKE SPEES
 JOHN GAINOR


DATE: 1-17-2007

Describe any record evidence, monument evidence, testimonial evidence, or any other material evidence you considered and whether the monument was found or restored through acceptance of an obliterated evidence location.


Remnant fence corners near the forty corners to the East and West were considered, but not used, per a consult with Bill Jung. Mr. Jung and I agree on my single proportionate method in reestablishing this corner.

Describe or show any material discrepancy between the location of the restored corner and that of the corner previously restored or reestablished.

This corner had only a calculated position by Steve Solberg. His corner position would fall approximately two feet North and East of my single proportionate position. I disagree with Steve Solberg's previous position.

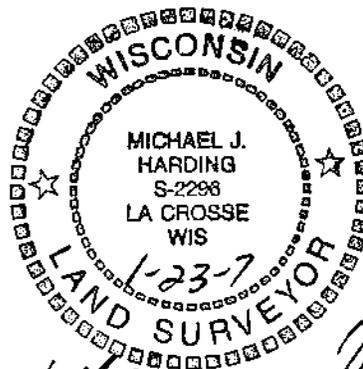


Michael J. Harding

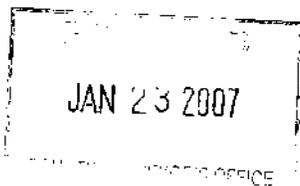


RECORD OF DURABLE WITNESS MONUMENTS

NO	DESCRIPTION	BEARING	DISTANCE
1	MAG NAIL IN A. MILLER RD.	N 02°48'22" E	300.08'
2	3/4" x 24" IRON BAR	S 88°29'46" E	320.00'
3	3/4" x 24" IRON BAR	S 00°00'12" W	320.00'
4	3/4" x 24" IRON BAR	N 88°29'46" W	250.00'

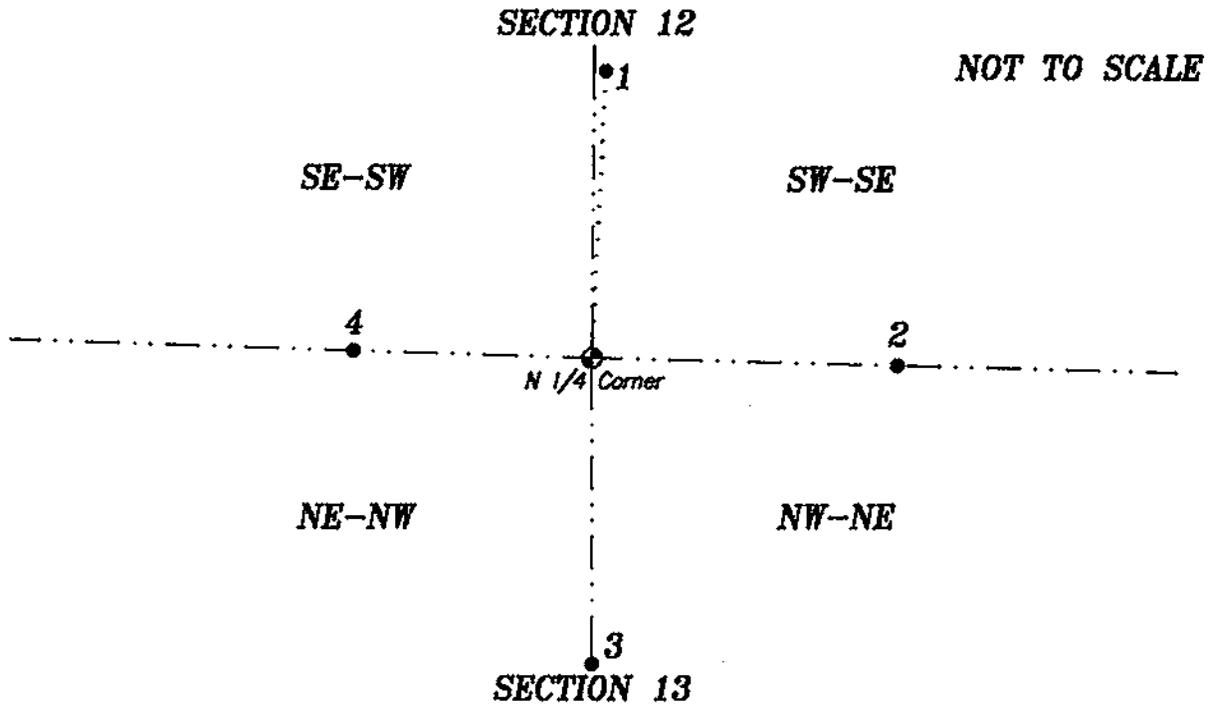

PLAN VIEW DRAWING OF REFERENCE TIES

MAP SHOWING DISTANCE AND DIRECTION TO OTHER PUBLIC LAND SURVEY CORNERS USED FOR REESTABLISHING THE CORNER

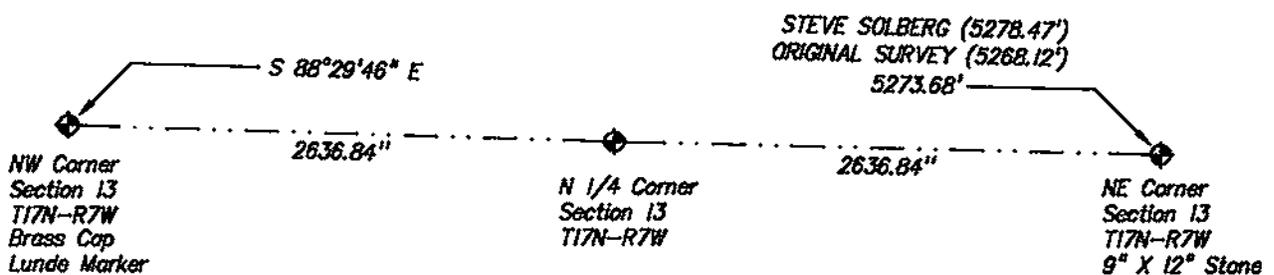

I, MICHAEL J. HARDING REGISTERED LAND SURVEYOR, #2296
 HEREBY CERTIFY THAT THE CORNER LOCATION SHOWN ON THIS RECORD
 WAS DETERMINED BY ME OR UNDER MY DIRECTION AND CONTROL AND
 THAT THIS U. S. PUBLIC LAND SURVEY MONUMENT RECORD IS CORRECT
 AND COMPLETE TO THE BEST OF MY KNOWLEDGE AND BELIEF.



Michael J. Harding
 Signature

1-23-7
 Date

Seal