


21707122000

## U. S. PUBLIC LAND SURVEY MONUMENT RECORD

SECTION 12 T 17 N, R 7 W, TOWN OF ONALASKA/HAMILTON  
 LA CROSSE COUNTY

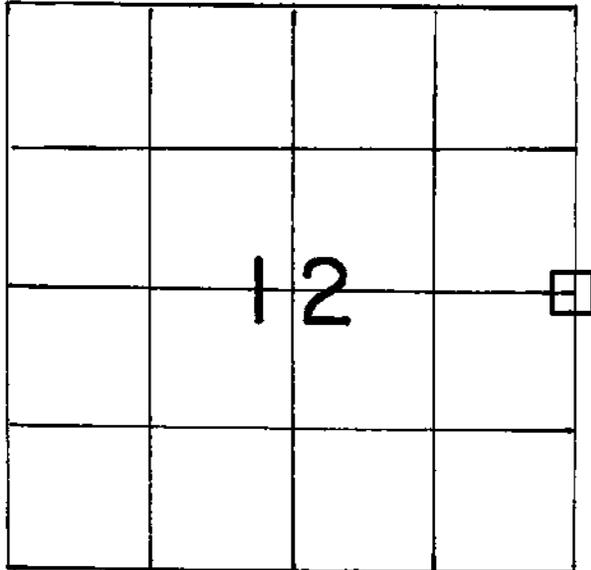

LOCATION OF LANDMARK

Crew: Jung &amp; Sutton

Date: 7/07/1993

Describe any record evidence, monument evidence, testimonial evidence or any other material evidence you considered and whether the monument was found or restored through acceptance of an obliterated evidence location.

Steve Solberg, RLS, found an unrecorded stone at this corner. We have found other unrecorded stones in the Town of Onalaska that have proven to be the actual corner. This stone appears to be another such case. If we could find the missing County Surveyor books, the history of this stone could be confirmed. I accepted the location of this stone as the best available evidence of the original government corner position. This is one of the largest stones that this surveyor has ever found. Describe or show any material discrepancy between the location of the restored corner and that of the corner previously restored or reestablished.

None known.

## WISCONSIN COORDINATE SYSTEM

North

East

Theta Angle

Horiz. Order

Vert. Order

## TYPE OF LANDMARK


Existing 14" x 9" Stone

BEARINGS ARE REFERENCED TO

RECORD OF DURABLE WITNESS MONUMENTS  
Magnetic

NO	DESCRIPTION	BEARING	DISTANCE
1	Set Nail in S.-side 32" Oak (unblazed)	Westerly $\pm$	Sl. = 47.03'
2	Set P.K. Nail in SE-side 5" Hickory	N 22° E	17.94 Ft.
3	Set P.K. Nail in SE-side 9" Hickory	N 70° E	24.63 Ft.
4	Set P.K. Nail in N.-side 8" Hickory in fence	S 85° E	11.10 Ft.

( Scale: 1" = 15' )

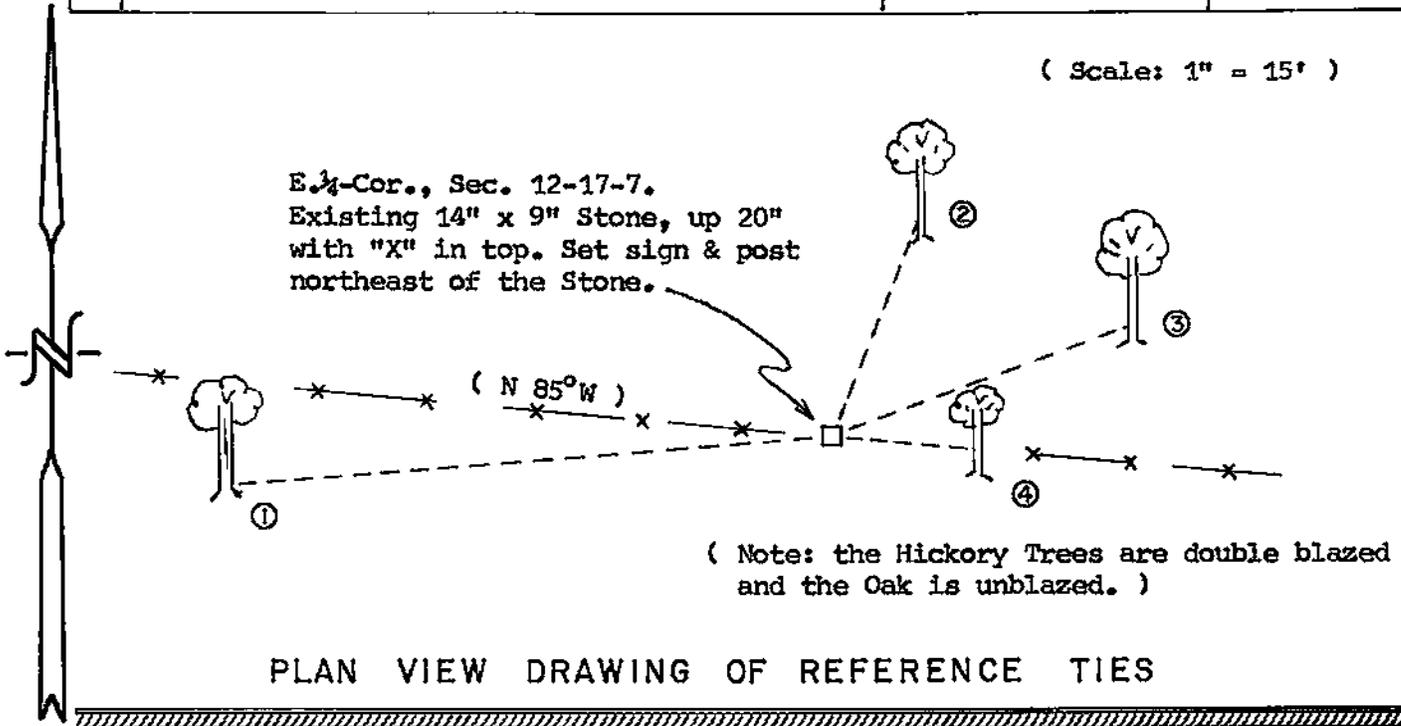


MAP SHOWING DISTANCE AND DIRECTION TO OTHER PUBLIC LAND SURVEY CORNERS USED FOR REESTABLISHING THE CORNER

No section measurements made by me at this time. Steve Solberg's section data confirmed the location of this corner.

I, William C. Jung, County Surveyor  
HEREBY CERTIFY THAT THE CORNER LOCATION SHOWN ON THIS RECORD  
WAS DETERMINED BY ME OR UNDER MY DIRECTION AND CONTROL AND  
THAT THIS U. S. PUBLIC LAND SURVEY MONUMENT RECORD IS CORRECT  
AND COMPLETE TO THE BEST OF MY KNOWLEDGE AND BELIEF.

William C. Jung                      1/25/94  
Signature                                      Date

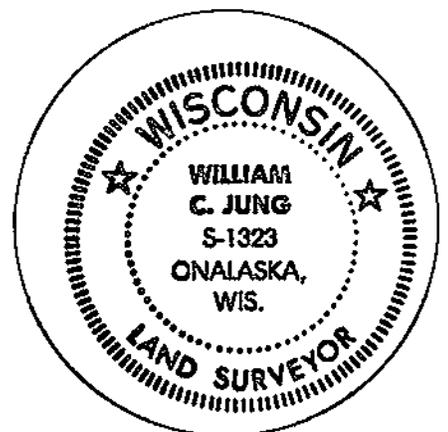

Seal