


21707140020

U. S. PUBLIC LAND SURVEY MONUMENT RECORD

SECTION 23 T 17 N, R 7 W, TOWN OF ONALASKA/HAMILTON
 LA CROSSE COUNTY

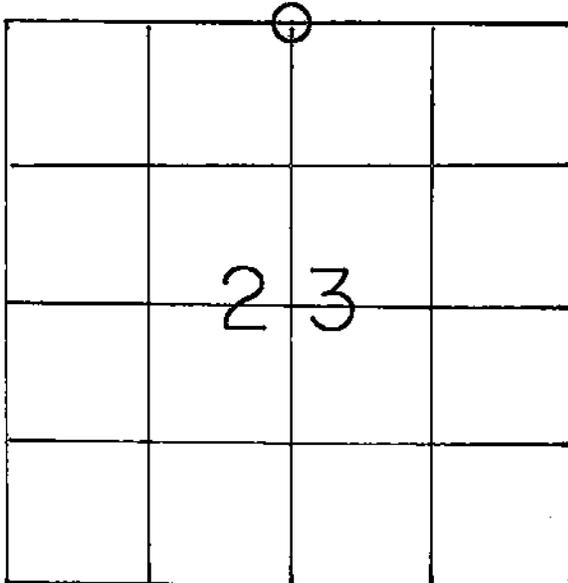

LOCATION OF LANDMARK

Crew: WILLIAM C. JUNG
 PETER F. FOLLANSBEE
 Date: 9/24/1996

Describe any record evidence, monument evidence, testimonial evidence or any other material evidence you considered and whether the monument was found or restored through acceptance of an obliterated evidence location.

I set the corner equidistant between the section corners and in the old East-West fence. The corner was monumented with an iron pipe.

Describe or show any material discrepancy between the location of the restored corner and that of the corner previously restored or reestablished.

Bob Chalsma set a railroad spike at this corner in 1984. I could not find it.

WISCONSIN COORDINATE SYSTEM

North

East

Theta Angle

Horiz. Order

Vert. Order

TYPE OF LANDMARK

Set 1" x 30" Iron Pipe.

BEARINGS ARE REFERENCED TO

GRID NORTH.

