


21707150020

U. S. PUBLIC LAND SURVEY MONUMENT RECORD

SECTION 15 T 17 N, R 7 W, TOWN OF ONALASKA

LA CROSSE COUNTY

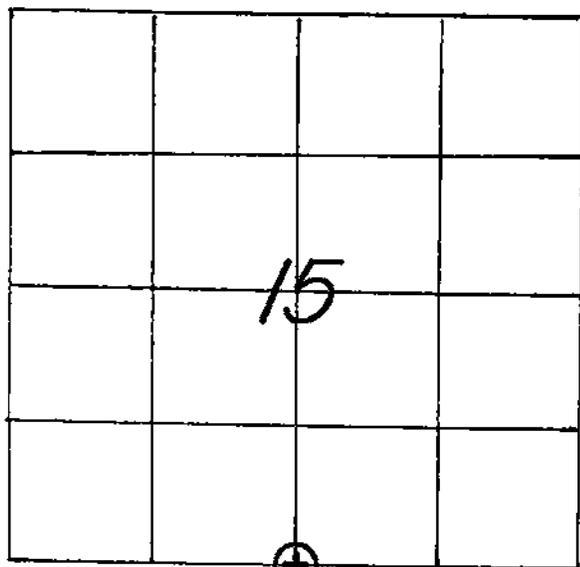

LOCATION OF LANDMARK

CREW: WILLIAM C. JUNG
 PETER F. FOLLANSBEE
 DATE: 8/26/2004

WISCONSIN COORDINATE SYSTEM

North

East

Theta Angle

Horiz. Order

Vert. Order

TYPE OF LANDMARK

3/4" x 30" IRON BAR WITH AN ALUMINUM CAP.

BEARINGS ARE REFERENCED TO

Describe any record evidence, monument evidence, testimonial evidence or any other material evidence you considered and whether the monument was found or restored through acceptance of an obliterated evidence location.

Paul Fairchild and I accepted the old occupied corner as the best available evidence of the original government corner position. Sherman Witte, a longtime resident of this area, said that this corner has been occupied as such "100 years". I set an iron bar with a cap at the corner and mounded it with rocks. The corner is on top of the ridgetop.

Describe or show any material discrepancy between the location of the restored corner and that of the corner previously restored or reestablished.

NONE KNOWN.

