


21707160000

U. S. PUBLIC LAND SURVEY MONUMENT RECORD

SECTION 16 T 17 N, R 7 W, TOWN OF ONALASKA
 LA CROSSE COUNTY

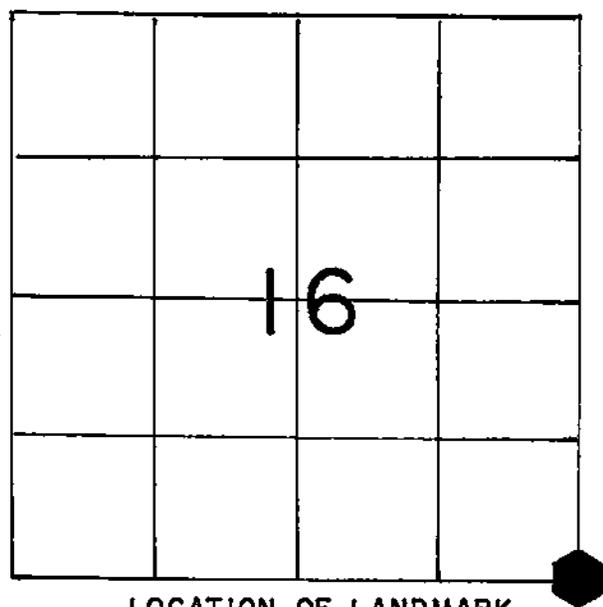

LOCATION OF LANDMARK

Crew: WILLIAM C. JUNG
 PETER F. FOLLANSBEE

Date: 11/02/1993

Describe any record evidence, monument evidence, testimonial evidence or any other material evidence you considered and whether the monument was found or restored through acceptance of an obliterated evidence location.

In the Town of Onalaska I have found a number of unrecorded "field" stones at corners which have proven to be at the actual corner locations. Paul Fairchild, RLS, and I found such a stone at this corner. We agree that the stone is at the section corner. The stone was replaced with a Berntsen top in an I.P.

Describe or show any material discrepancy between the location of the restored corner and that of the corner previously restored or reestablished.

None Known.

WISCONSIN COORDINATE SYSTEM

North

East

Theta Angle

Horiz. Order

Vert. Order

TYPE OF LANDMARK

Set 1-5/8" x 30" I.P. w/Berntsen Top.

BEARINGS ARE REFERENCED TO

