


## U. S. PUBLIC LAND SURVEY MONUMENT RECORD

SECTION 16 T 17 N, R 7 W, TOWN OF ONALASKA  
 LA CROSSE COUNTY

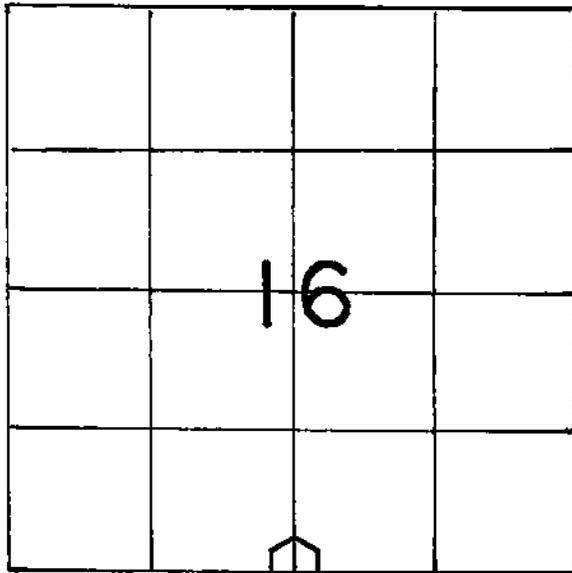

LOCATION OF LANDMARK

## WISCONSIN COORDINATE SYSTEM

North

East

Theta Angle

Horiz. Order

Vert. Order

## TYPE OF LANDMARK

Set brass cap Lunde marker.

BEARINGS ARE REFERENCED TO

Crew: WILLIAM C. JUNG  
 PETER F. FOLLANSBEE

Date: 10/29/1993

Describe any record evidence, monument evidence, testimonial evidence or any other material evidence you considered and whether the monument was found or restored through acceptance of an obliterated evidence location.

Paul Fairchild, RLS, set an I.P. at this corner. The corner was set by single proportionate measurement. The I.P. was removed and replaced by a Lunde marker.


Describe or show any material discrepancy between the location of the restored corner and that of the corner previously restored or reestablished.

None Known.

RECORD OF DURABLE WITNESS MONUMENTS

NO	DESCRIPTION	MAGNETIC	
		BEARING	DISTANCE
1	Set P.K. Nail in NE-side 9" Hickory	N 65°W	Sl.=38.05'
2	Set P.K. Nail in NE-side 10" White Oak	N 18°W	Sl.=33.91'
3	Set P.K. Nail in SE-side 5½" Hickory	N 39°E	41.60 Ft.
4	Set P.K. Nail in NE-side 9½" Cherry	S 57°E	42.17 Ft.

(Note: Distances are measured to P.K. Nails set in double blazed Bearing Trees.)

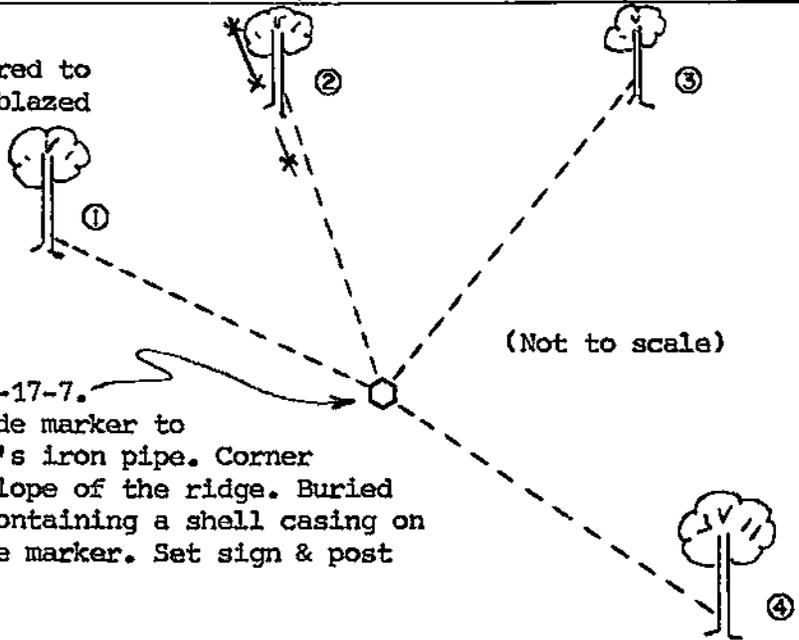

S.¼-Cor., Sec. 16-17-7.  
 Set brass cap Lunde marker to replace Fairchild's iron pipe. Corner is on the North slope of the ridge. Buried a liquor bottle containing a shell casing on the N.-side of the marker. Set sign & post to the southeast.

PLAN VIEW DRAWING OF REFERENCE TIES


MAP SHOWING DISTANCE AND DIRECTION TO OTHER PUBLIC LAND SURVEY CORNERS USED FOR REESTABLISHING THE CORNER

No section measurements were made by me at this time. Section measurements were made by Paul Fairchild, RLS, and reviewed by both of us. I agreed with his final section "break down".

I, William C. Jung, County Surveyor  
 HEREBY CERTIFY THAT THE CORNER LOCATION SHOWN ON THIS RECORD WAS DETERMINED BY ME OR UNDER MY DIRECTION AND CONTROL AND THAT THIS U. S. PUBLIC LAND SURVEY MONUMENT RECORD IS CORRECT AND COMPLETE TO THE BEST OF MY KNOWLEDGE AND BELIEF.

William C. Jung  
 Signature

12/28/93  
 Date

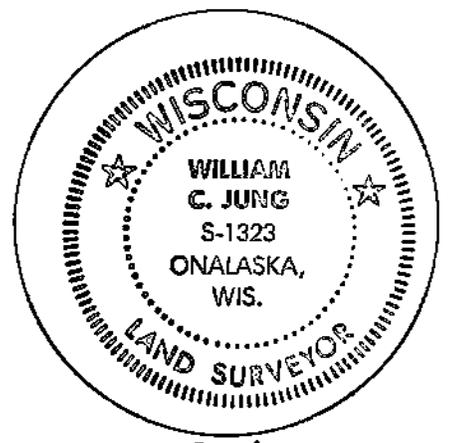

Seal