


21707170000

U. S. PUBLIC LAND SURVEY MONUMENT RECORD

SECTION 21 T 17 N, R 7 W, TOWN OF ONALASKA

LA CROSSE COUNTY

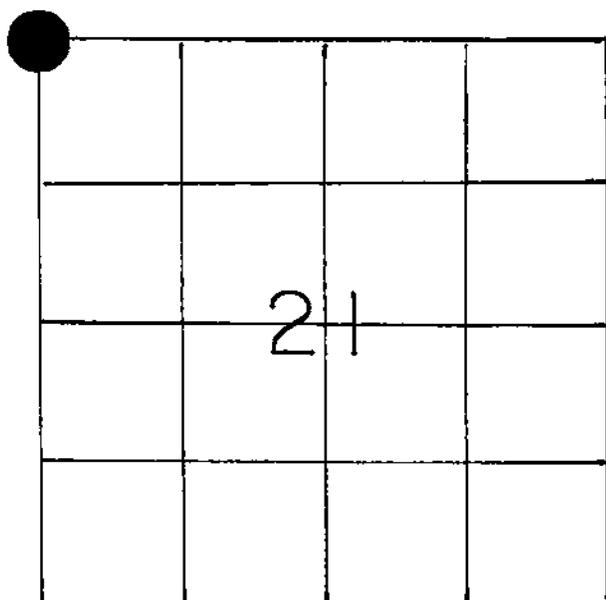

LOCATION OF LANDMARK

WISCONSIN COORDINATE SYSTEM
North
East
Theta Angle
Horiz. Order
Vert. Order

TYPE OF LANDMARK  
 SET BRASS CAP LUNDE MARKER ( FLUSH )  
 BEARINGS ARE REFERENCED TO  
 ASSUMED BEARINGS

CREW: WILLIAM C. JUNG  
 PETER F. FOLLANSBEE

11-30-1987

Describe any record evidence, monument evidence, testimonial evidence or any other material evidence you considered and whether the monument was found or restored through acceptance of an obliterated evidence location.


In his plat of Apple Valley Estates II, Dick Berg shows a 2" iron pipe at this corner. This pipe was apparently knocked out during construction. The pipe was also used in other surveys as the corner. I computed out the location of Berg's old corner and set a Brass Capped Lunde Marker at the corner.

Describe or show any material discrepancy between the location of the restored corner and that of the corner previously restored or reestablished.

NONE KNOWN

**RECORD OF DURABLE WITNESS MONUMENTS**  
MAGNETIC


NO	DESCRIPTION	BEARING	DISTANCE
1	SET P.K. NAIL IN OLD BLAZE IN 20" BURR OAK	N 24°E	48.44 FT.
2	EXISTING 1 1/4" IRON PIPE	S 81°E	101.25 FT.
3	CENTER OF VENT PIPE	S 18°E	3.00 FT.
4	EXISTING IRON PIPE	N 22°E	155.28 FT.

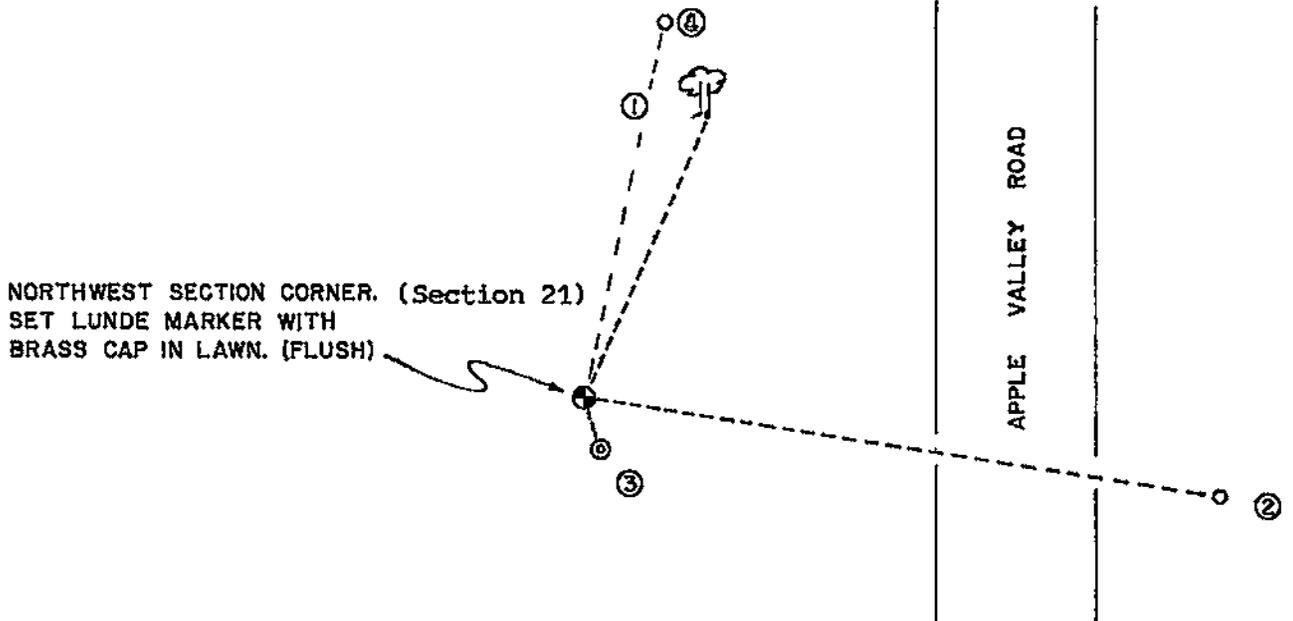

PLAN VIEW DRAWING OF REFERENCE TIES

**MAP SHOWING DISTANCE AND DIRECTION TO OTHER PUBLIC LAND SURVEY CORNERS USED FOR REESTABLISHING THE CORNER**

( NOT TO SCALE )

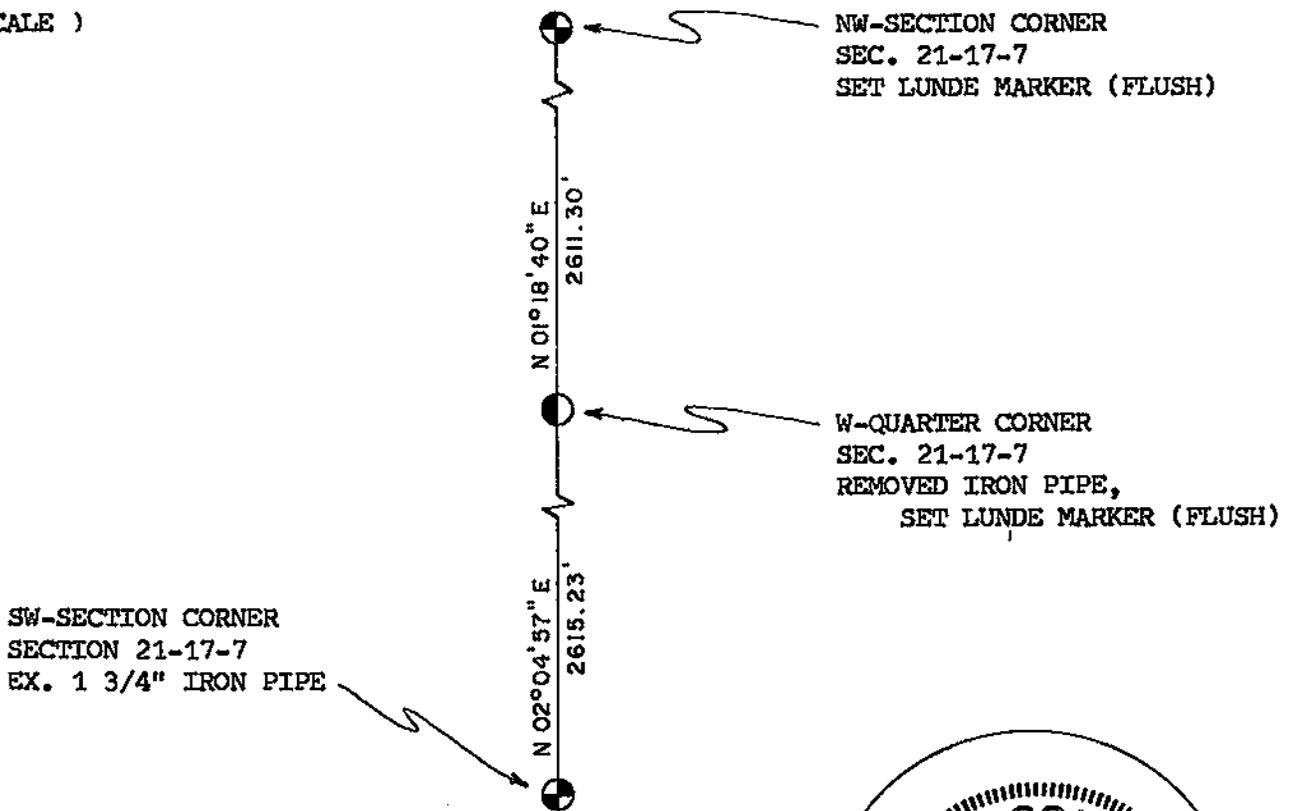

I, WILLIAM C. JUNG  
HEREBY CERTIFY THAT THE CORNER LOCATION SHOWN ON THIS RECORD WAS DETERMINED BY ME OR UNDER MY DIRECTION AND CONTROL AND THAT THIS U. S. PUBLIC LAND SURVEY MONUMENT RECORD IS CORRECT AND COMPLETE TO THE BEST OF MY KNOWLEDGE AND BELIEF.

*William C. Jung* Deputy County Surveyor, January 5, 1988  
Signature Date



Seal