


21707170020

U. S. PUBLIC LAND SURVEY MONUMENT RECORD

SECTION 20 T 17 N, R 7 W, TOWN OF ONALASKA

LA CROSSE COUNTY

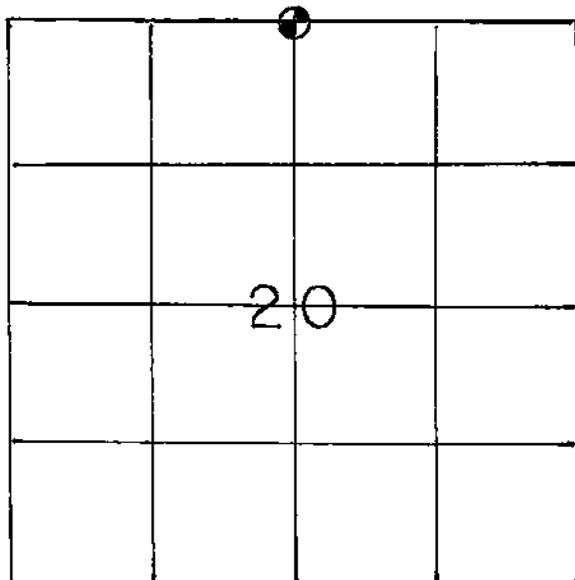

LOCATION OF LANDMARK

WISCONSIN COORDINATE SYSTEM
North
East
Theta Angle
Horiz. Order
Vert. Order
TYPE OF LANDMARK
2.375" O.D. X 30" IRON PIPE
BEARINGS ARE REFERENCED TO ASSUMED

Corner Set By:
Richard A. Berg &
Dustin B. Berg
10-20-2002

Describe any record evidence, monument evidence, testimonial evidence or any other material evidence you considered and whether the monument was found or restored through acceptance of an obliterated evidence location.

A search of the area revealed no occupation or other physical evidence at or near the corner location. We used iron rods set by Tom Buck and Chris Fechner for the N-S 1/4 line of Section 17, and the relative bearing of the north line of the NW1/4 of Section 20, as per surveys by Tom Buck and Chris Fechner. (This also coincides with iron pipes set by Clayton Connell on the same line.) We set the North Quarter Corner of Section 20 at the intersection of these N-S and E-W lines.

Describe or show any material discrepancy between the location of the restored corner and that of the corner previously restored or reestablished.

None Known


RECORD OF DURABLE WITNESS MONUMENTS

Magnetic

NO	DESCRIPTION	BEARING	DISTANCE
1	Set a Mag Nail in the West side of an unblazed white oak (12")	N20°E	38.32 Ft
2	Set a Mag Nail in the South side of an unblazed 10" Hickory.	N89°E	17.50 Ft
3	Set a Mag Nail in the East side of an unblazed 6" Elm.	S19°W	24.41 Ft
4	Set a Mag Nail in the Southeast side of an unblazed 6" Elm.	S80°W	20.66 Ft

Note: The bearing trees are not blazed.

The area is wooded on all sides of the corner.

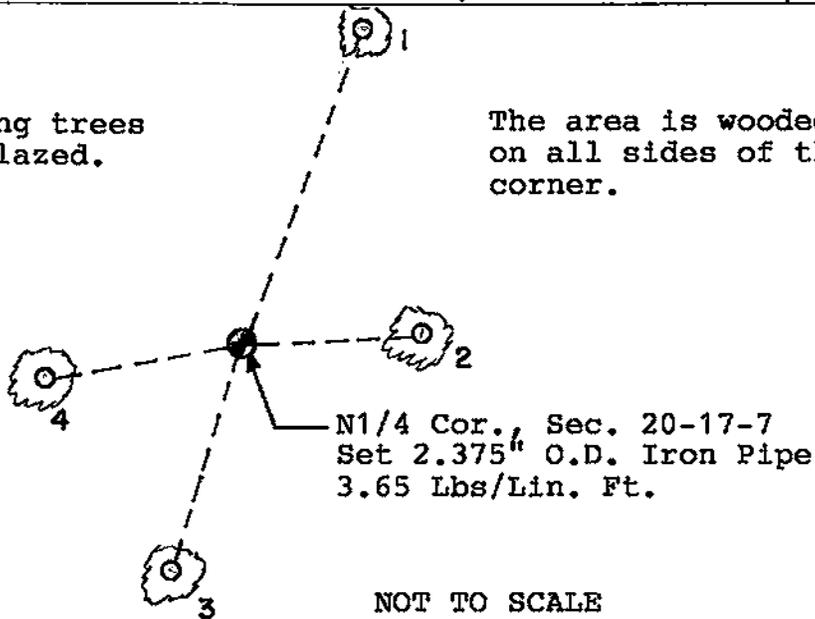


NOT TO SCALE

PLAN VIEW DRAWING OF REFERENCE TIES

MAP SHOWING DISTANCE AND DIRECTION TO OTHER PUBLIC LAND SURVEY CORNERS USED FOR REESTABLISHING THE CORNER


NOT TO SCALE

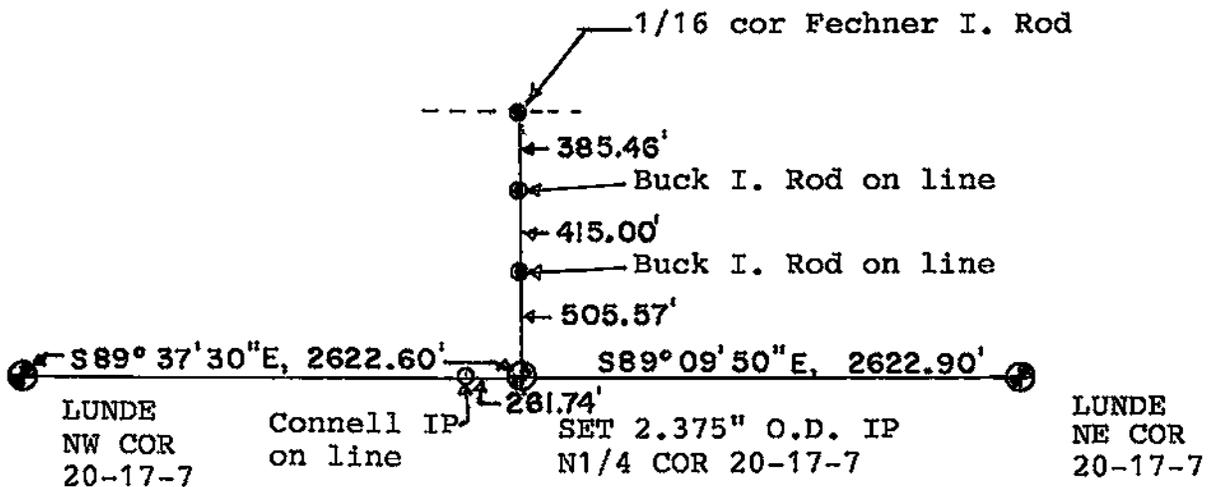

I, RICHARD A. BERG, REGISTERED LAND SURVEYOR,
 HEREBY CERTIFY THAT THE CORNER LOCATION SHOWN ON THIS RECORD
 WAS DETERMINED BY ME OR UNDER MY DIRECTION AND CONTROL AND
 THAT THIS U. S. PUBLIC LAND SURVEY MONUMENT RECORD IS CORRECT
 AND COMPLETE TO THE BEST OF MY KNOWLEDGE AND BELIEF.

Richard A. Berg
 Signature

3-31-2003
 Date

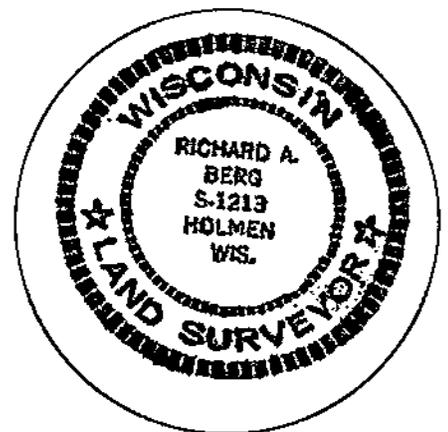

Seal