


21707180020

## U. S. PUBLIC LAND SURVEY MONUMENT RECORD

SECTION 18 T 17 N, R 7 W, TOWN OF ONALASKA  
LA CROSSE COUNTY

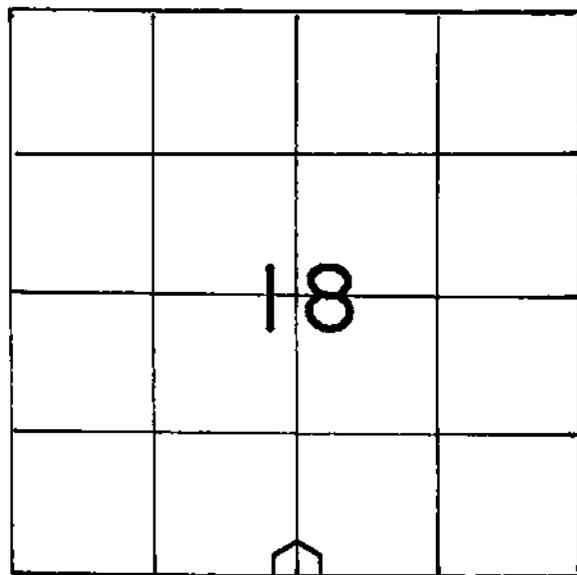

LOCATION OF LANDMARK

## WISCONSIN COORDINATE SYSTEM

North 710,086.558 (D.O.T.) (1927)

East 1,668,162.689 (D.O.T.)

Theta Angle

Horiz. Order

Vert. Order

## TYPE OF LANDMARK

Reset brass cap Lunde marker.

BEARINGS ARE REFERENCED TO

Crew: WILLIAM C. JUNG  
PETER F. FOLLANSBEE

11/3/93

Describe any record evidence, monument evidence, testimonial evidence or any other material evidence you considered and whether the monument was found or restored through acceptance of an obliterated evidence location.

A P.K. Nail was found at the occupied corner. On June 23, 1988 the crew of Ron Hayden, Peter Follansbee and I removed the P.K. Nail and replaced it with a brass cap Lunde marker. I accepted this location as the best available evidence of the original government corner position. The P.K. Nail has been used as the corner in previous surveys. The 1932 Corps of Engineers' notes support this location as the correct corner.


Due to road construction the Lunde was removed and later reset on 11/03/1993 by me, Peter Follansbee and Phil Scholze.

Describe or show any material discrepancy between the location of the restored corner and that of the corner previously restored or reestablished.

None Known.

RECORD OF DURABLE WITNESS MONUMENTS

NO	DESCRIPTION	BEARING	DISTANCE
1	Fnd. Iron Bar w/Plastic Cap (D.O.T. R/W)	East	32.89 Ft.
2	Existing R.R. Spike set by Phil Scholze	S 49°W ±	51.17 Ft.
3	NE-Corner of Single Story House Foundation	S 75°W ±	92.06 Ft.
4	Existing P.K. Nail in 24" Maple (East side)	N 28°W ±	106.33 Ft.

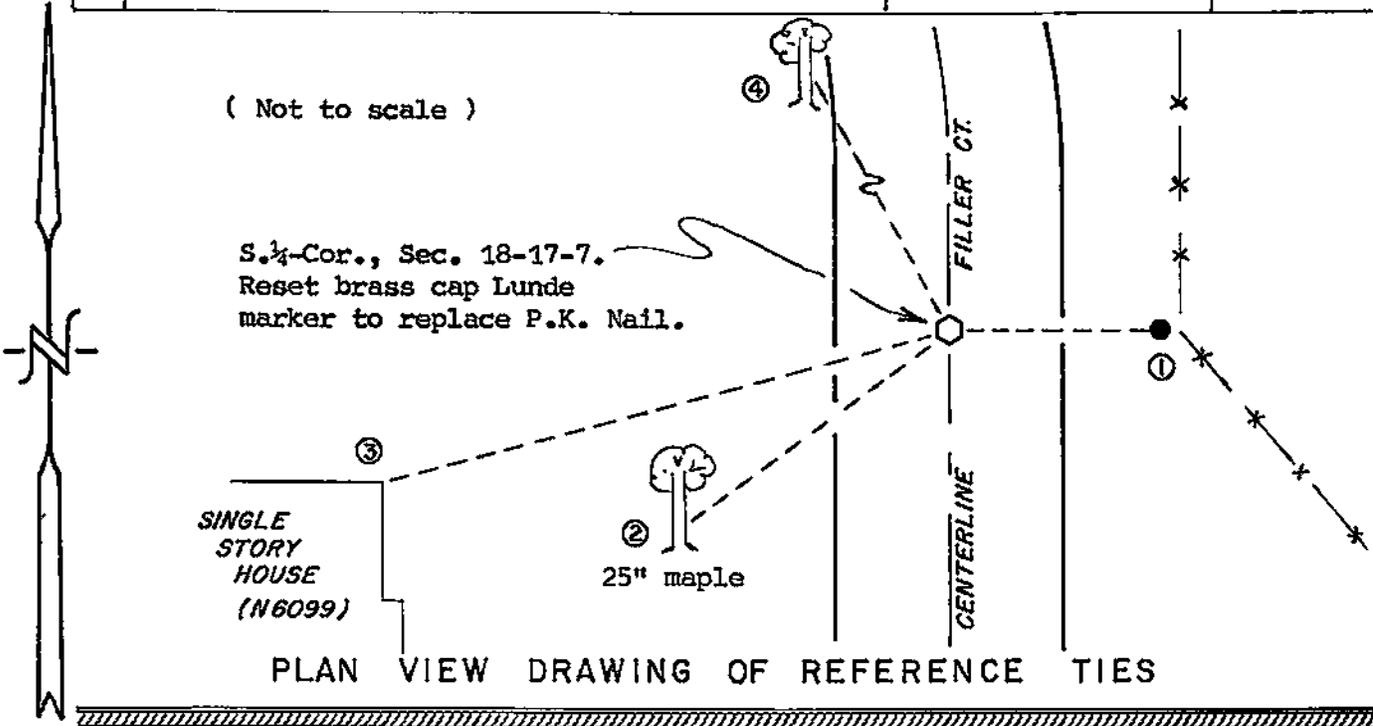

MAP SHOWING DISTANCE AND DIRECTION TO OTHER PUBLIC LAND SURVEY CORNERS USED FOR REESTABLISHING THE CORNER

No measurements were made by me at this time, although previous measurements made by others confirm the corner location.

I, William C. Jung, County Surveyor  
 HEREBY CERTIFY THAT THE CORNER LOCATION SHOWN ON THIS RECORD  
 WAS DETERMINED BY ME OR UNDER MY DIRECTION AND CONTROL AND  
 THAT THIS U. S. PUBLIC LAND SURVEY MONUMENT RECORD IS CORRECT  
 AND COMPLETE TO THE BEST OF MY KNOWLEDGE AND BELIEF.


William C. Jung                      1/7/94  
 Signature                                      Date



Seal

U. S. PUBLIC LAND SURVEY MONUMENT RECORD

SECTION 18 T 17 N, R 7 W, TOWN OF ONALASKA  
 LA CROSSE COUNTY

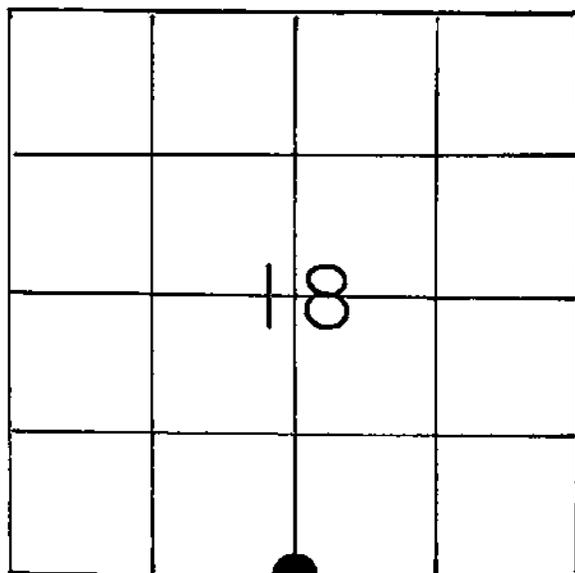

LOCATION OF LANDMARK

Crew: WILLIAM C. JUNG  
 RON HAYDEN  
 PETER F. FOLLANSBEE

Date: 6/23/1988

Describe any record evidence, monument evidence, testimonial evidence or any other material evidence you considered and whether the monument was found or restored through acceptance of an obliterated evidence location.

I found a P.K. nail at the occupied corner, removed the P.K. nail, and replaced it with a brass capped Lunde marker. I accepted this location as the best available evidence of the original government corner position. The P.K. nail had been used as the corner in previous surveys. The 1932 Corps of Engineers' notes support this location as the correct corner.

Describe or show any material discrepancy between the location of the restored corner and that of the corner previously restored or reestablished.

None known.


WISCONSIN COORDINATE SYSTEM	
North	710,086.558
East	1,668,162.689
Theta Angle	
Horiz. Order	
Vert. Order	
TYPE OF LANDMARK	
SET BRASS CAP LUNDE MARKER	
BEARINGS ARE REFERENCED TO	

(as per D.O.T.)

**VOID**

RECORD OF DURABLE WITNESS MONUMENTS

NO	DESCRIPTION	MAGNETIC	
		BEARING	DISTANCE
1	Fnd. Iron Bar w/Plastic Cap(D.O.T. R/W)	EAST	32.89 Ft.
2	Set P.K. Nail in 25" Silver Maple(N-side)	S 54° W 1"	53.12 Ft.
3	NE-Corner of Single Story House(N6099)	S 75° W	92.02 Ft.
4	Found 1" Iron Pipe(Lot Corner & R.O.W.)	WEST	32.98 Ft.

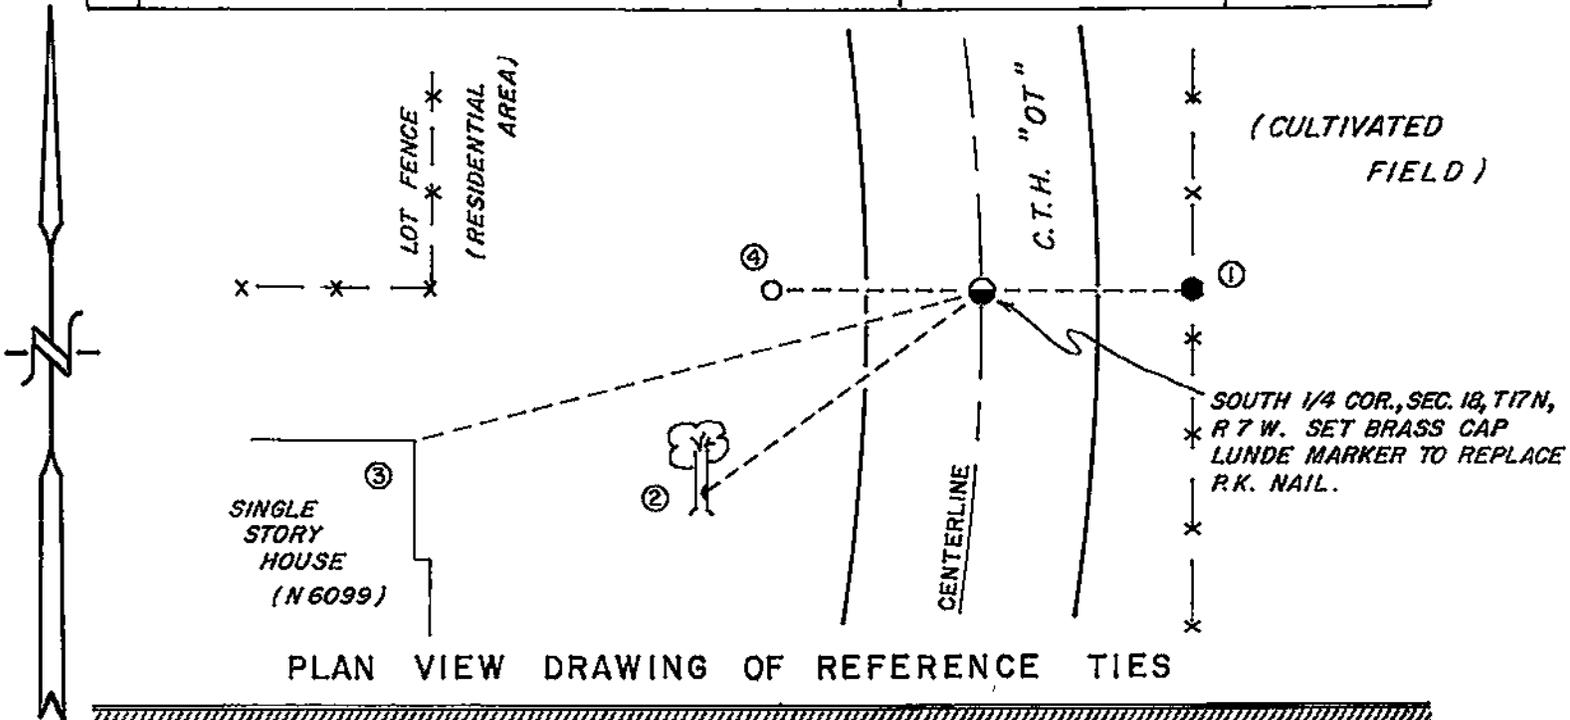

MAP SHOWING DISTANCE AND DIRECTION TO OTHER PUBLIC LAND SURVEY CORNERS USED FOR REESTABLISHING THE CORNER

No measurements were made by me at this time, although previous measurements made by others confirm the corner location.

I, William C. Jung, Deputy County Surveyor  
 HEREBY CERTIFY THAT THE CORNER LOCATION SHOWN ON THIS RECORD  
 WAS DETERMINED BY ME OR UNDER MY DIRECTION AND CONTROL AND  
 THAT THIS U. S. PUBLIC LAND SURVEY MONUMENT RECORD IS CORRECT  
 AND COMPLETE TO THE BEST OF MY KNOWLEDGE AND BELIEF.

William C. Jung  
 Signature

August 5, 1988  
 Date




Seal


STA. 16 + 00 P.I.  
Assumed Coordinate  
3000.00 E  
3000.00 N

SURVEY FOR REFERENCE  
TIE TO GOV'T SURVEY  
CORNER  
C.T.H. XX BRIDGE OVER  
HALFWAY CREEK, TOWN  
OF ONALASKA, LA CROSSE  
COUNTY, WISCONSIN

Scale 1" = 400'

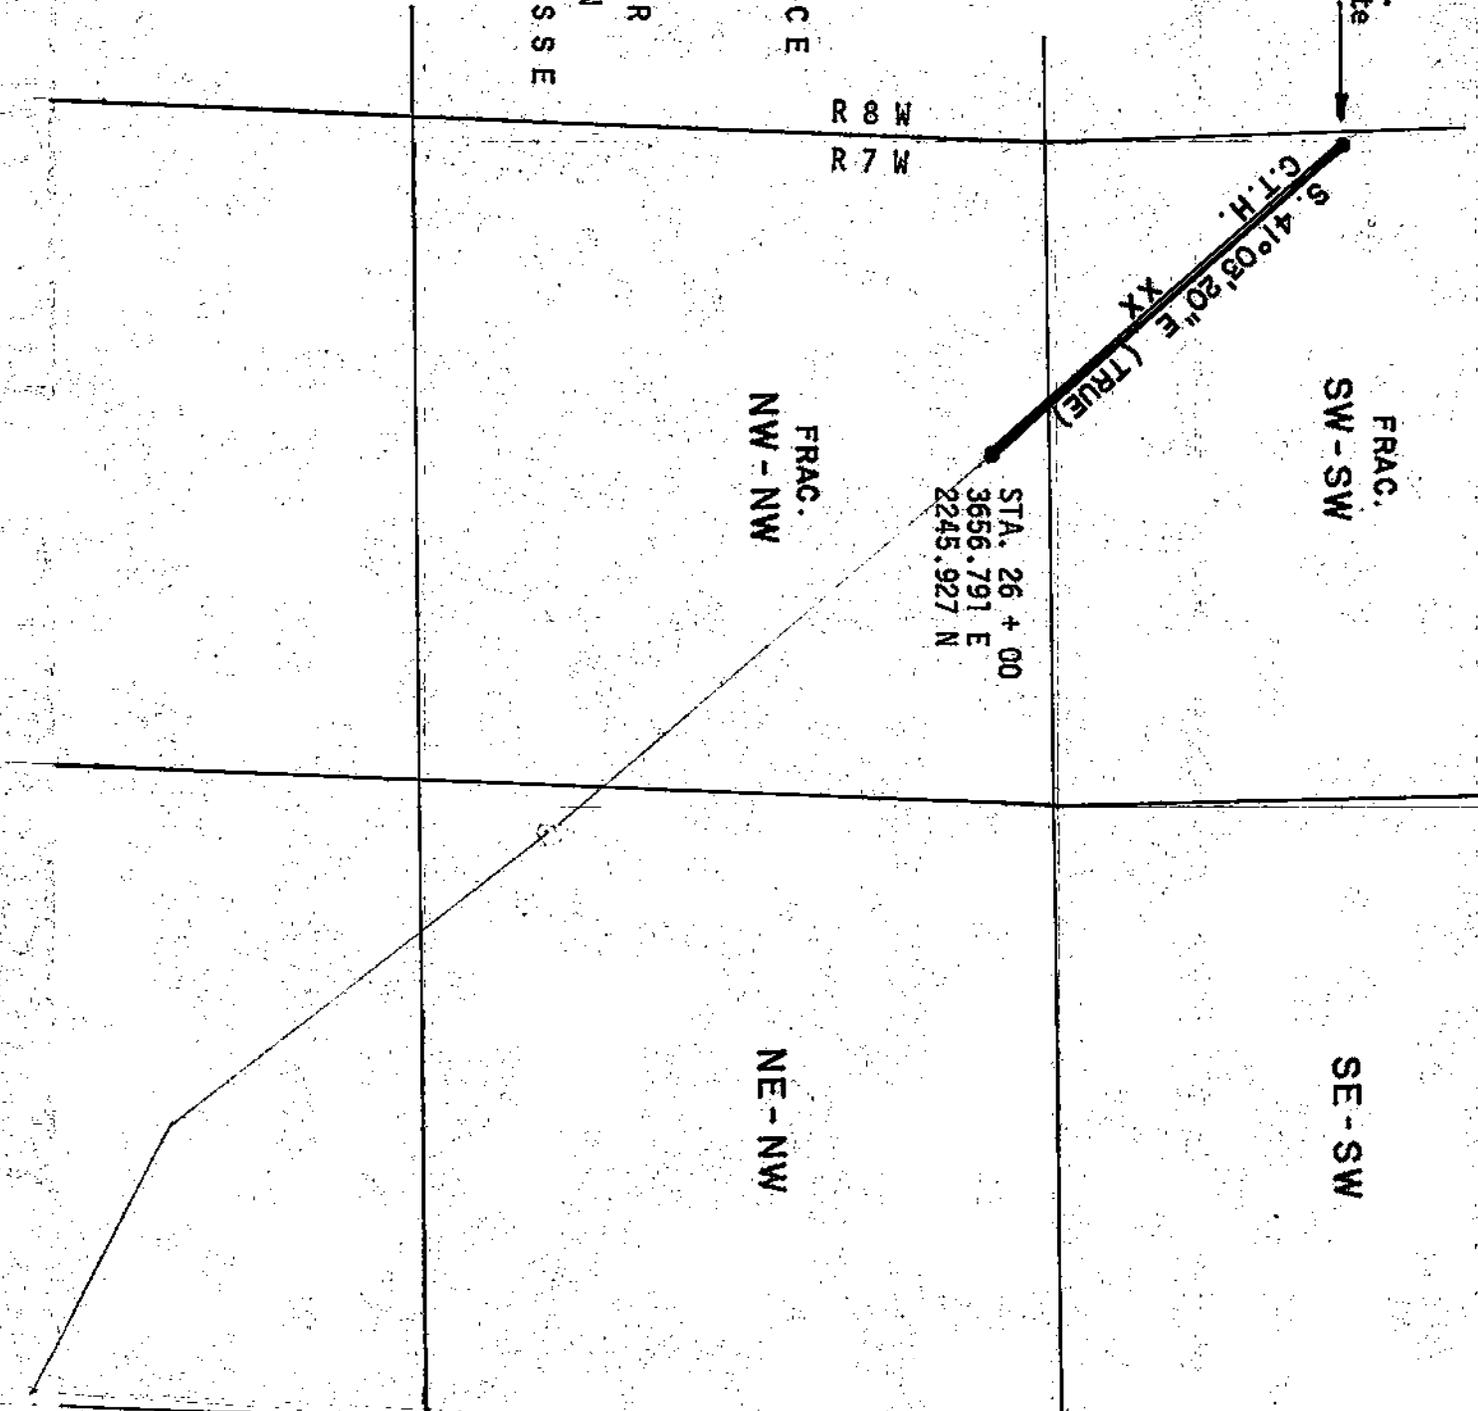

SOUTH 1/4 CORNER  
SECTION 18 T 17 N R 7 W  
5723.394 E  
2383.097 N

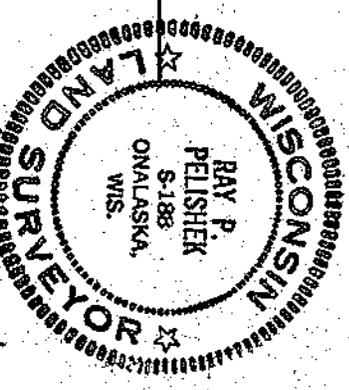

*Ray P. Pelishek*  
2-21-78

La Crosse County  
Zoning & Planning Dept.  
Room 105 Court House  
La Crosse, Wis. 54601