


## U. S. PUBLIC LAND SURVEY MONUMENT RECORD

SECTION 18 T 17 N, R 7 W, TOWN OF Onalaska

LA CROSSE COUNTY

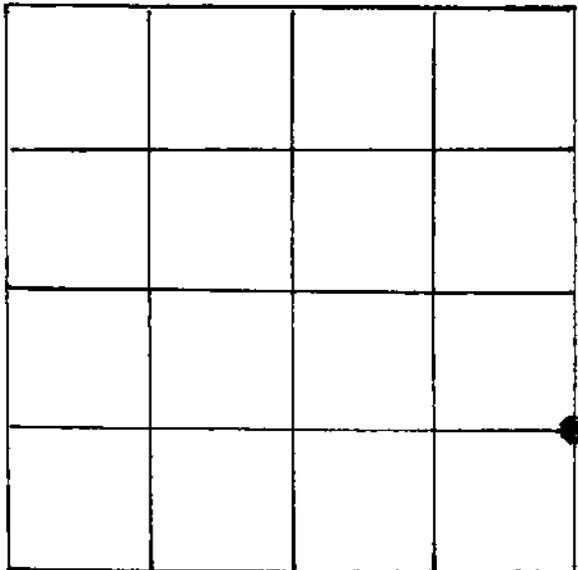

LOCATION OF LANDMARK

## WISCONSIN COORDINATE SYSTEM

North

East

Theta Angle

Horiz. Order

Vert. Order

## TYPE OF LANDMARK

3/4" X 30" round iron bar

## BEARINGS ARE REFERENCED TO

Magnetic


Describe any record evidence, monument evidence, testimonial evidence or any other material evidence you considered and whether the monument was found or restored through acceptance of an obliterated evidence location.

Found no existing record of corner ever having been established.  
Set a 3/4" X 30" round iron bar on line and between the E $\frac{1}{2}$  Corner and the Southeast Corner.

Describe or show any material discrepancy between the location of the restored corner and that of the corner previously restored or reestablished.

RECORD OF DURABLE WITNESS MONUMENTS


NO	DESCRIPTION	BEARING	DISTANCE
1	PK Nail set in the south side of a power pole.	N 66° E	34.30'
2	Found 1" iron pipe set at lot corner west side of County Trunk "SN"	S 63° W	32.90'
3	The top of a power pedestal. Lot corner has been removed.	N 28° W	75.62'
4	See below for ties to the E½ Corner and the SE Corner of Section 18.		

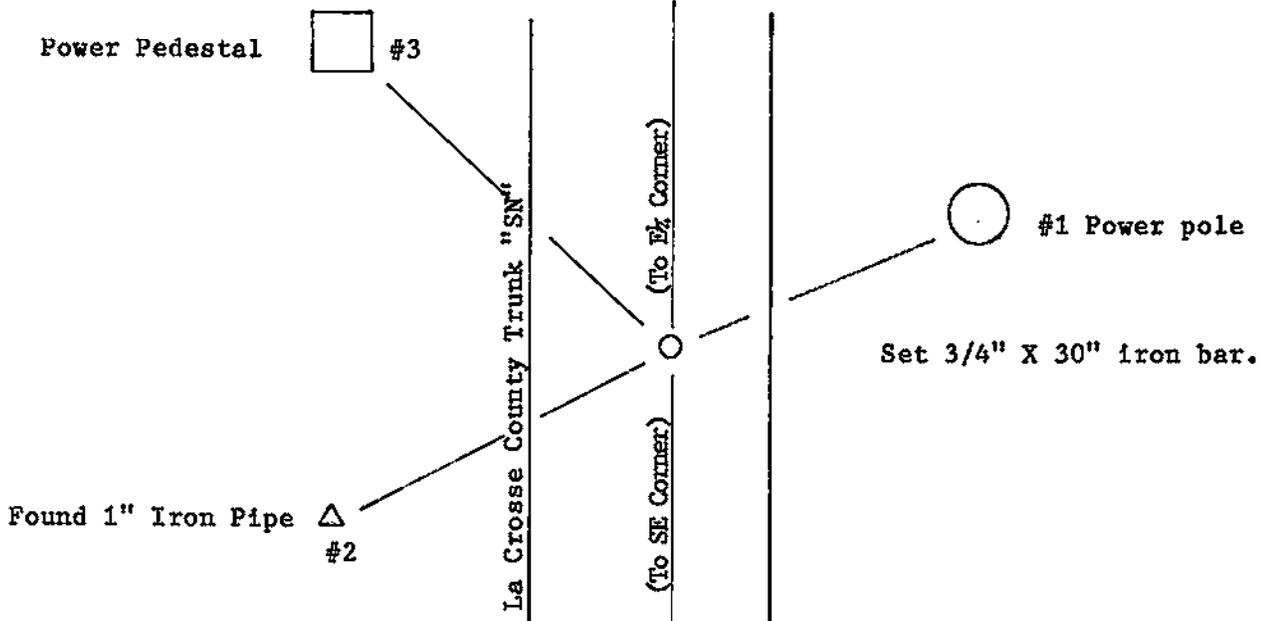

PLAN VIEW DRAWING OF REFERENCE TIES


MAP SHOWING DISTANCE AND DIRECTION TO OTHER PUBLIC LAND SURVEY CORNERS USED FOR REESTABLISHING THE CORNER

Note: bearings are based on Grid North from State Plane Coordinates for the Wisconsin Department of Transportation.

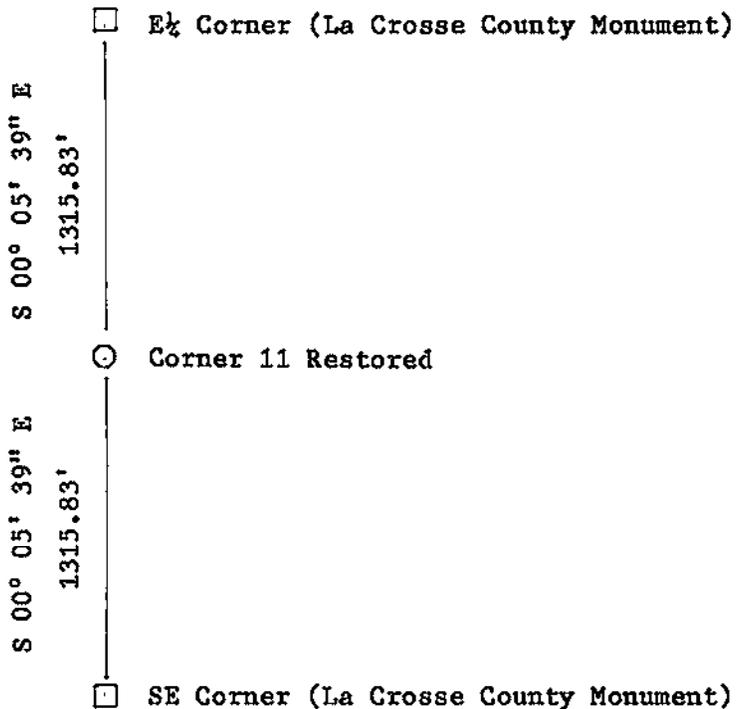

I, Ronald R. Hayden  
 HEREBY CERTIFY THAT THE CORNER LOCATION SHOWN ON THIS RECORD  
 WAS DETERMINED BY ME OR UNDER MY DIRECTION AND CONTROL AND  
 THAT THIS U. S. PUBLIC LAND SURVEY MONUMENT RECORD IS CORRECT  
 AND COMPLETE TO THE BEST OF MY KNOWLEDGE AND BELIEF.

Ronald R. Hayden 7/12/88  
 Signature Date

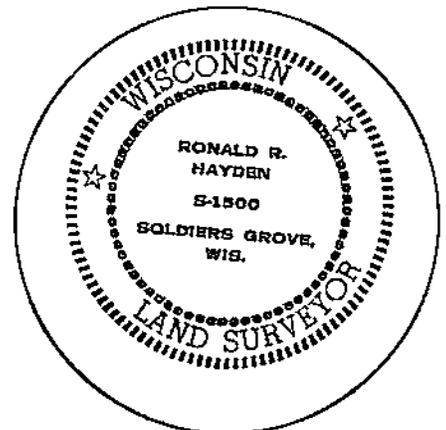

Seal