


U. S. PUBLIC LAND SURVEY MONUMENT RECORD

SECTION 18 T 17 N, R 7 W, TOWN OF Onalaska

LA CROSSE COUNTY

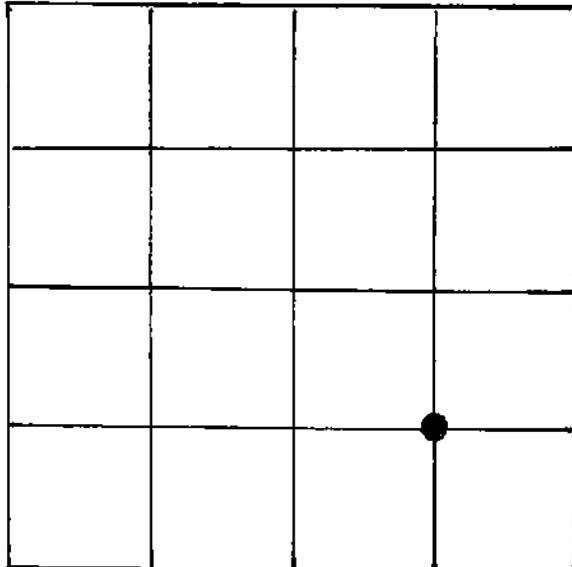

LOCATION OF LANDMARK

WISCONSIN COORDINATE SYSTEM

North

East

Theta Angle

Horiz. Order

Vert. Order

TYPE OF LANDMARK

Set 3/4" X 30" round iron bar

BEARINGS ARE REFERENCED TO

Magnetic North

Describe any record evidence, monument evidence, testimonial evidence or any other material evidence you considered and whether the monument was found or restored through acceptance of an obliterated evidence location.

Found no evidence of the corner being established. Found remains of an old fence line, occupational evidence. Set a 3/4" X 30" round iron bar at the intersection of the north, south, east and west forty lines.

Describe or show any material discrepancy between the location of the restored corner and that of the corner previously restored or reestablished.

