


## U. S. PUBLIC LAND SURVEY MONUMENT RECORD

SECTION 18 T 17 N, R 7 W, TOWN OF Onalaska

LA CROSSE COUNTY

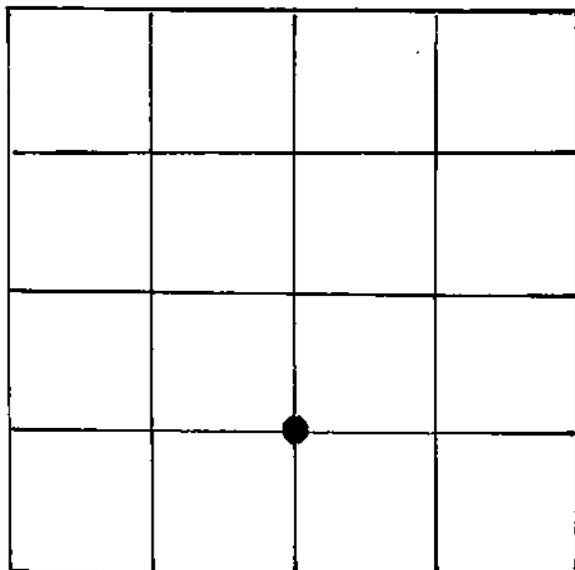

LOCATION OF LANDMARK

## WISCONSIN COORDINATE SYSTEM

North

East

Theta Angle

Horiz. Order

Vert. Order

## TYPE OF LANDMARK

Set 3/4" X 30" round iron bar

## BEARINGS ARE REFERENCED TO

Grid North

Describe any record evidence, monument evidence, testimonial evidence or any other material evidence you considered and whether the monument was found or restored through acceptance of an obliterated evidence location.

Found no evidence that corner had ever been established. Found an existing iron bolt and nail in County Trunk "OT". Established corner half way between and on line between the S $\frac{1}{2}$  Corner and the C $\frac{1}{2}$  Corner. Fits occupational evidence.

Describe or show any material discrepancy between the location of the restored corner and that of the corner previously restored or reestablished.

Found iron bolt which bears: S 25° 13' 19" W 3.03'

Found nail in pavement and bears: S 85° 35' 56" W 0.44'

