


21707182000

U. S. PUBLIC LAND SURVEY MONUMENT RECORD

SECTION 18 T 17 N, R 7 W, ~~TOWN OF~~ VILLAGE OF HOLMEN

LA CROSSE COUNTY

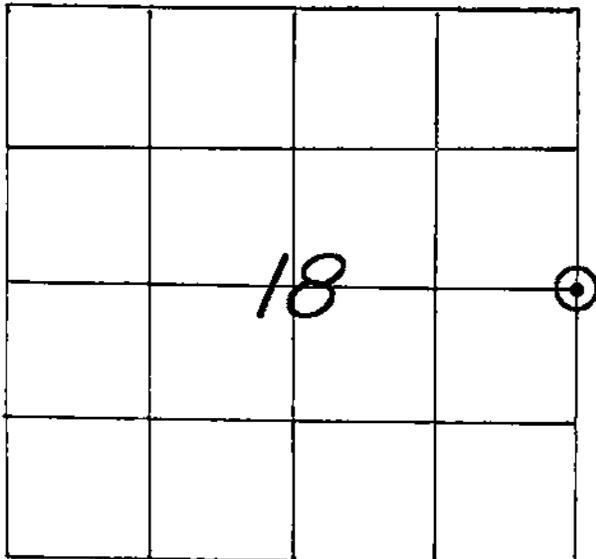

WISCONSIN COORDINATE SYSTEM

North

East

Theta Angle

Horiz. Order

Vert. Order

TYPE OF LANDMARK

P.K. NAIL IN PAVEMENT.

BEARINGS ARE REFERENCED TO

LOCATION OF LANDMARK

CREW: WILLIAM C. JUNG
 PETER F. FOLLANSBEE
 DATE: 9/27/2004

Describe any record evidence, monument evidence, testimonial evidence or any other material evidence you considered and whether the monument was found or restored through acceptance of an obliterated evidence location.


Pete and I removed the Lunde marker on 5/6/04 because of highway construction. The new highway asphalt mix laid down during this construction was very hard. We set a P.K. nail and washer at the corner and took six ties. Since I tied off this corner back in 1988 this corner location has been used repeatedly in more surveys.

Describe or show any material discrepancy between the location of the restored corner and that of the corner previously restored or reestablished.

NONE KNOWN.

RECORD OF DURABLE WITNESS MONUMENTS

NO	DESCRIPTION	BEARING	DISTANCE
1	N. EAST COR. AT TOP OF PLANTER AROUND LIGHT POST	S.-WESTERLY ±	52.43 FT.
2	CENTER OF CAP FOR WATER SHUT-OFF	N.-WESTERLY ±	55.16 FT.
3	EXISTING 2" IRON PIPE BURIED IN THE LAWN	N.-WESTERLY ±	74.23 FT.
4	CENTER OF THE MANHOLE COVER AT ROAD INTER'S'N	NORTH ±	34.21 FT.

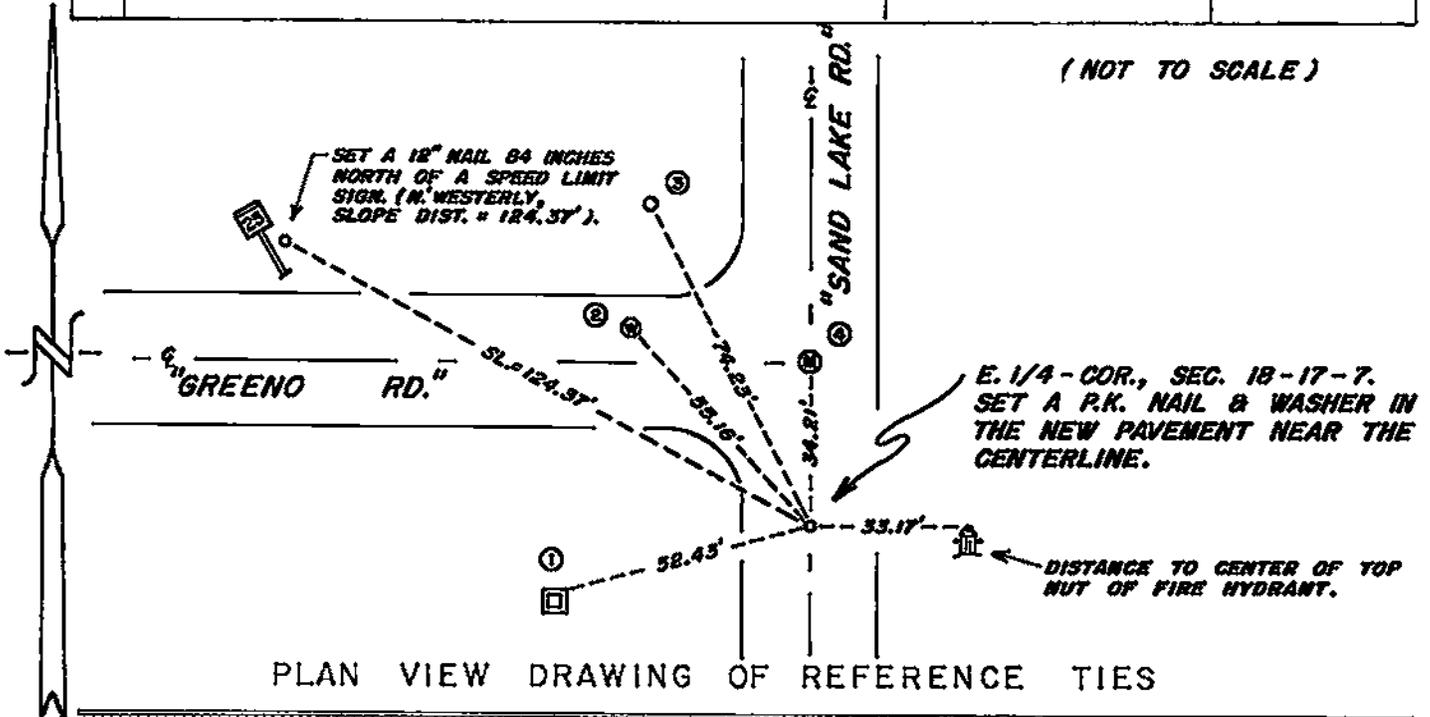

MAP SHOWING DISTANCE AND DIRECTION TO OTHER PUBLIC LAND SURVEY CORNERS USED FOR REESTABLISHING THE CORNER

No more section measurements were made by me at this time. I do intend to conduct a GPS mission this year that will include this corner.

I, WILLIAM C. JUNG, COUNTY SURVEYOR
 HEREBY CERTIFY THAT THE CORNER LOCATION SHOWN ON THIS RECORD
 WAS DETERMINED BY ME OR UNDER MY DIRECTION AND CONTROL AND
 THAT THIS U. S. PUBLIC LAND SURVEY MONUMENT RECORD IS CORRECT
 AND COMPLETE TO THE BEST OF MY KNOWLEDGE AND BELIEF.


William C. Jung 2/16/05
 Signature Date



Seal

U. S. PUBLIC LAND SURVEY MONUMENT RECORD

SECTION 18 T 17 N, R 7 W, TOWN OF ONALASKA
 LA CROSSE COUNTY

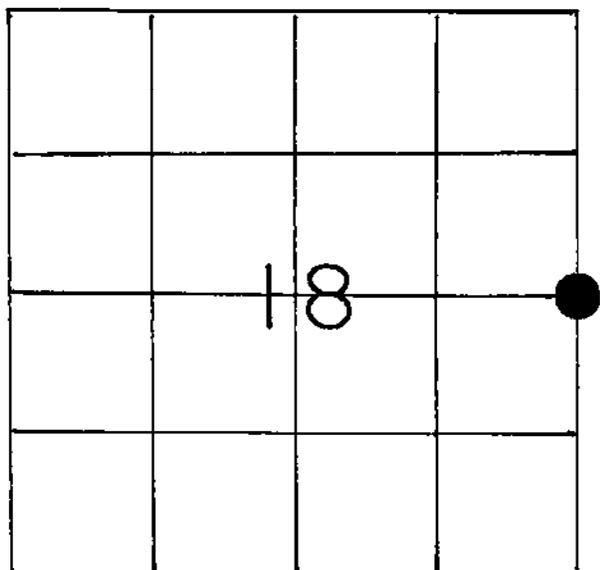

LOCATION OF LANDMARK

WISCONSIN COORDINATE SYSTEM
North
East
Theta Angle
Horiz. Order
Vert. Order
TYPE OF LANDMARK
SET BRASS CAP LUNDE MARKER
BEARINGS ARE REFERENCED TO

Crew: WILLIAM C. JUNG
 RON HAYDEN
 PETER F. FOLLANSBEE

Date: 6/23/1988

Describe any record evidence, monument evidence, testimonial evidence or any other material evidence you considered and whether the monument was found or restored through acceptance of an obliterated evidence location.

I found a railroad spike at the corner, removed the railroad spike, and replaced it with a brass capped Lunde marker. I accepted this corner as the best available evidence of the original government corner position. The railroad spike had been used as the corner in previous surveys.

Describe or show any material discrepancy between the location of the restored corner and that of the corner previously restored or reestablished.

None known.

