


U. S. PUBLIC LAND SURVEY MONUMENT RECORD

SECTION 18 T 17 N, R 7 W, TOWN OF Onalaska

LA CROSSE COUNTY

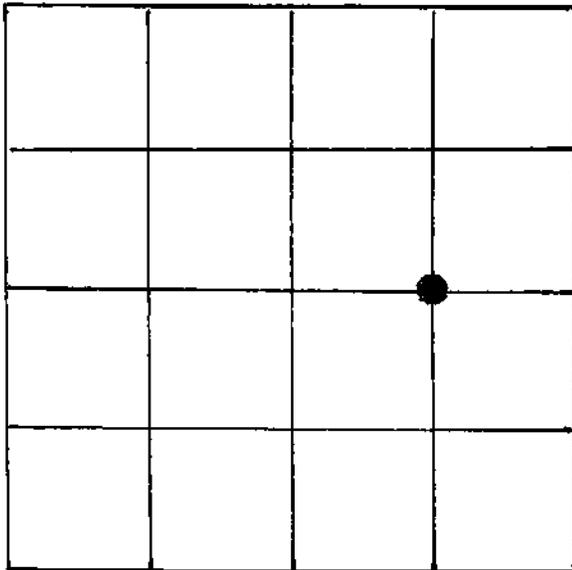

LOCATION OF LANDMARK

WISCONSIN COORDINATE SYSTEM

North

East

Theta Angle

Horiz. Order

Vert. Order

TYPE OF LANDMARK

None set (see back)

BEARINGS ARE REFERENCED TO

Grid North

Describe any record evidence, monument evidence, testimonial evidence or any other material evidence you considered and whether the monument was found or restored through acceptance of an obliterated evidence location.


Found no evidence that the corner was established. Determined corner location to be half way, on line, between the C $\frac{1}{2}$ Corner and the E $\frac{1}{2}$ Corner. Found a 2" iron pipe bearing N 40° 37' 03" E 1.07', from the corner established. To avoid confusion I did not set a monument. All corners shown on my survey for the Wisconsin Department of Transportation were tied into their coordinate system and a copy of this information is filed with the County Surveyor.

Describe or show any material discrepancy between the location of the restored corner and that of the corner previously restored or reestablished.

Found a 2" iron pipe 1.07 feet away from the corner established by me. I was unable to locate its origin. Pipe bears N 40° 37' 03" E from the corner position established by me.


RECORD OF DURABLE WITNESS MONUMENTS

NO	DESCRIPTION	BEARING	DISTANCE
1	Found 1" iron pipe at a lot corner in Cliffview Estates.	N 10° 40' 53" E	68.67'
2	Found 2" iron pipe near the corner established.	N 40° 37' 03" E	1.07'
3	Found 2" iron pipe at the northwest corner of an area used as a park.	N 87° 45' 35" E	16.76'
4	Found 3/4" rebar with cap set by Wis. Dot. for survey control point.	S 81° 10' 03" W	930.57'

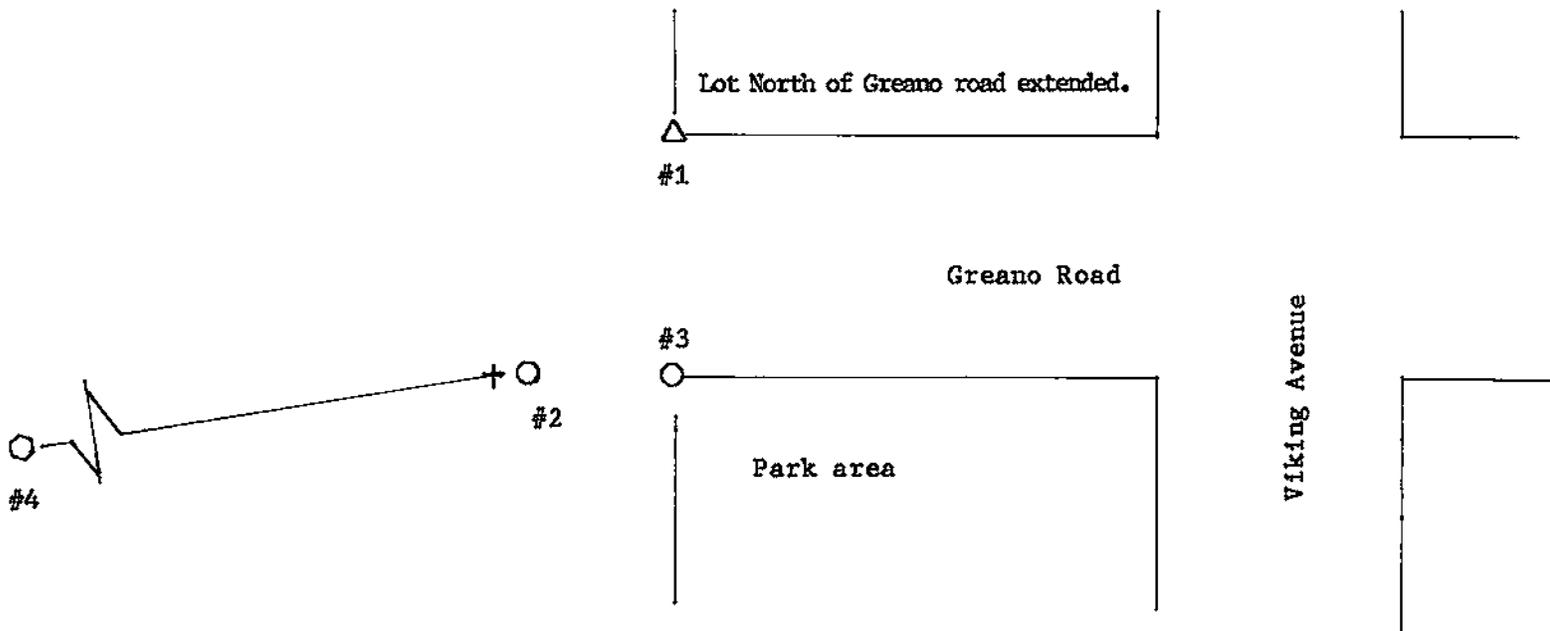

PLAN VIEW DRAWING OF REFERENCE TIES

MAP SHOWING DISTANCE AND DIRECTION TO OTHER PUBLIC LAND SURVEY CORNERS USED FOR REESTABLISHING THE CORNER

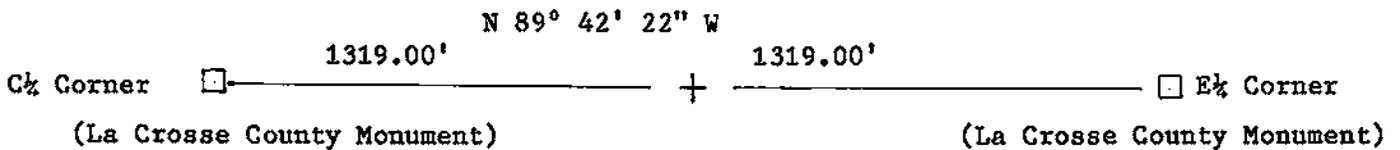

I, Ronald R. Hayden
 HEREBY CERTIFY THAT THE CORNER LOCATION SHOWN ON THIS RECORD
 WAS DETERMINED BY ME OR UNDER MY DIRECTION AND CONTROL AND
 THAT THIS U. S. PUBLIC LAND SURVEY MONUMENT RECORD IS CORRECT
 AND COMPLETE TO THE BEST OF MY KNOWLEDGE AND BELIEF.

Ronald R. Hayden 7/12/88
 Signature Date

