


21707190000

## U. S. PUBLIC LAND SURVEY MONUMENT RECORD

SECTION 29 T 17 N, R 7 W, TOWN OF ONALASKA

LA CROSSE COUNTY

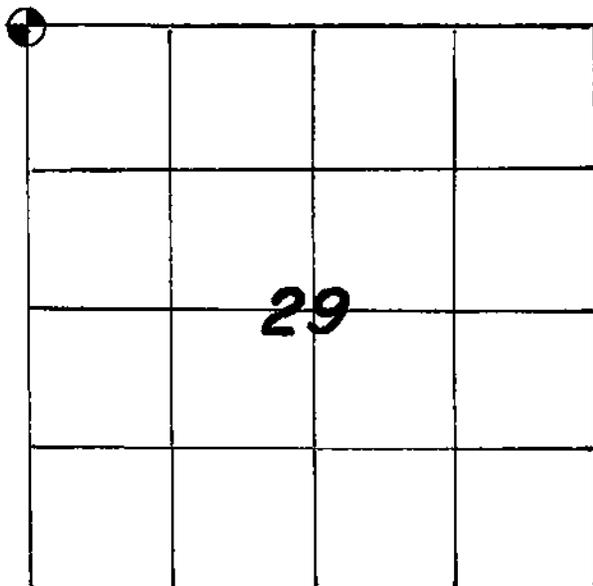

LOCATION OF LANDMARK

CREW: BILL JUNG, PERRY DAHL

DATE: 3-16-87

## WISCONSIN COORDINATE SYSTEM

North

East

Theta Angle

Horiz. Order

Vert. Order

## TYPE OF LANDMARK

BRASS CAPPED LUNDE MARKER

## BEARINGS ARE REFERENCED TO

Assumed

Describe any record evidence, monument evidence, testimonial evidence or any other material evidence you considered and whether the monument was found or restored through acceptance of an obliterated evidence location.


I found a 2" iron pipe at the corner, removed it, and replaced it with a brass capped Lunde marker. The iron pipe had been used as the corner in many previous surveys. I accepted its location as the best available evidence of the original government corner position.

Describe or show any material discrepancy between the location of the restored corner and that of the corner previously restored or reestablished.

None known.

RECORD OF DURABLE WITNESS MONUMENTS


NO	DESCRIPTION	BEARING	DISTANCE
1	SOUTHEAST CORNER OF HOUSE	---	74.56'
2	P.K. NAIL IN UNBLAZED 21" OAK TREE	---	75.65'
3	2" IRON PIPE (set)	SOUTH <sub>+</sub>	29.17'
4	1" IRON PIPE (existing)	NORTH <sub>+</sub>	162.72'

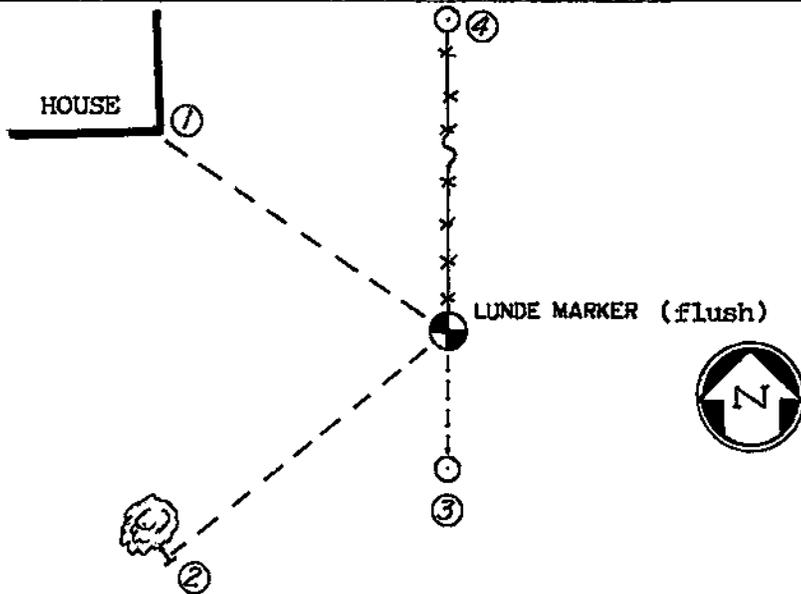

PLAN VIEW DRAWING OF REFERENCE TIES

MAP SHOWING DISTANCE AND DIRECTION TO OTHER PUBLIC LAND SURVEY CORNERS USED FOR REESTABLISHING THE CORNER


(not to scale)

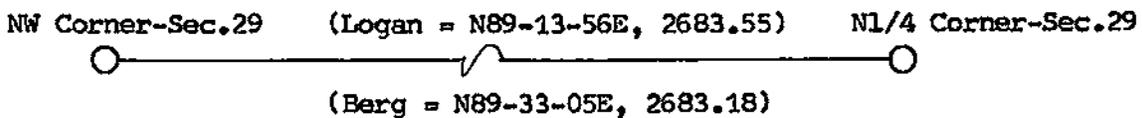

I, WILLIAM C. JUNG, Deputy County Surveyor,  
 HEREBY CERTIFY THAT THE CORNER LOCATION SHOWN ON THIS RECORD  
 WAS DETERMINED BY ME OR UNDER MY DIRECTION AND CONTROL AND  
 THAT THIS U. S. PUBLIC LAND SURVEY MONUMENT RECORD IS CORRECT  
 AND COMPLETE TO THE BEST OF MY KNOWLEDGE AND BELIEF.

*William C. Jung*  
 Signature

April 22, 1987  
 Date

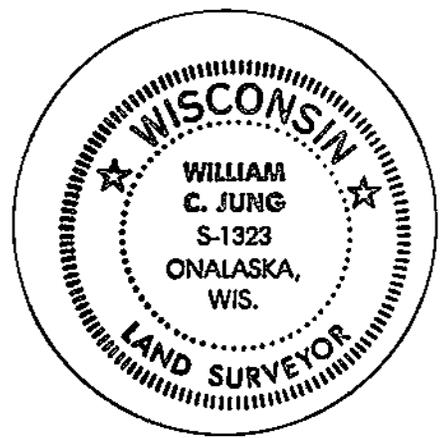

Seal