


U. S. PUBLIC LAND SURVEY MONUMENT RECORD

SECTION 19 T 17 N, R 7 W, TOWN OF Onalaska

LA CROSSE COUNTY

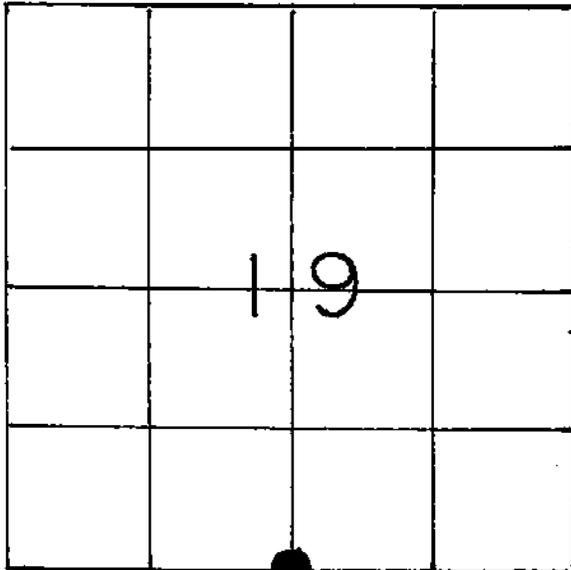

LOCATION OF LANDMARK

Crew: William C. Jung
Peter Follansbee

Dates: 5/19/88, 8/29/88, 9/6/88 , 6/26/91

Describe any record evidence, monument evidence, testimonial evidence or any other material evidence you considered and whether the monument was found or restored through acceptance of an obliterated evidence location.

I found a 6" buried bolt at the corner. This point had been used as the corner in many previous surveys. I accepted this point as the best available evidence of the original government corner position. I removed the bolt and replaced it with a brass capped Lunde marker. I found nothing else while digging. It was very hard digging. I dug a deep hole. The Schonstedt was ringing at the bottom of the hole. I could dig no further.

Describe or show any material discrepancy between the location of the restored corner and that of the corner previously restored or reestablished.

3.04' East was an existing railroad spike. Clayton Connell used this as the corner in 1977 as did Keith Graham in 1985. Graham's tie sheet is on record. I do not agree with his opinion. This road has been rebuilt and filled since 1931. There is no way that this railroad spike was there in 1931. I do not agree with Connell or Graham.

9/12/91 - Pete removed the Lunde on 5/28/91 because of highway paving. We reset the corner on 6/26/91 and checked the ties.

WISCONSIN COORDINATE SYSTEM

North

East

Theta Angle

Horiz. Order

Vert. Order


TYPE OF LANDMARK

Brass capped Lunde marker

BEARINGS ARE REFERENCED TO

RECORD OF DURABLE WITNESS MONUMENTS


NO	DESCRIPTION	BEARING	DISTANCE
1	Set 2½" iron pipe 2' West of the fence	-----	32.97
2	Existing railroad spike, down ¾" (GONE!)	-----	3.04
3	6/26/91-To base of broken off standpipe. To the center of the cap on top of standpipe	Magnetic = N34°W	40.22
4	Bolt	-----	26.66

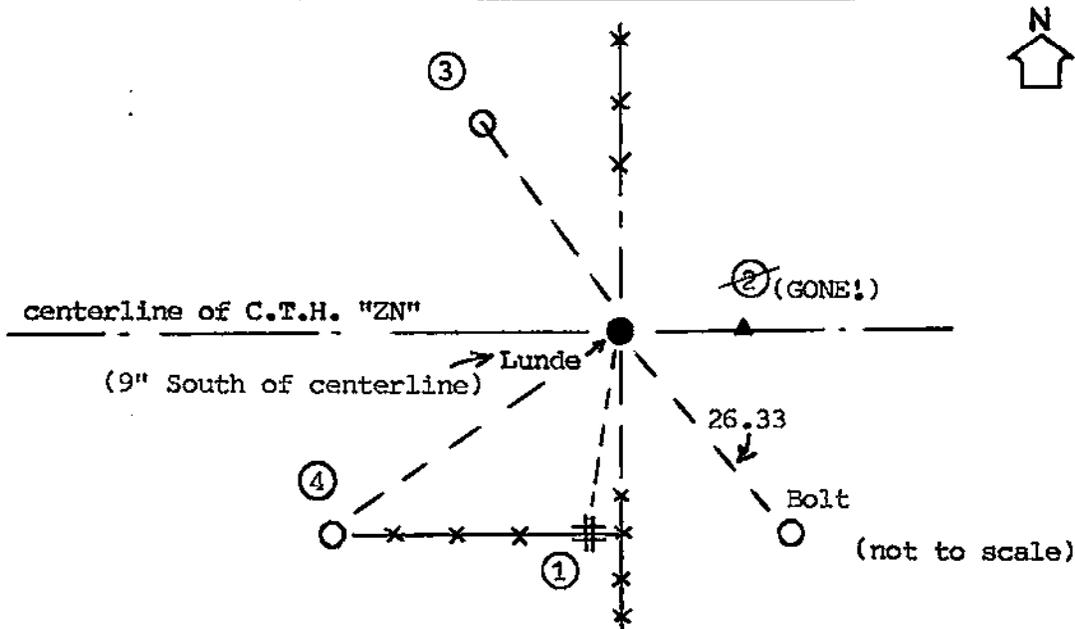

PLAN VIEW DRAWING OF REFERENCE TIES

MAP SHOWING DISTANCE AND DIRECTION TO OTHER PUBLIC LAND SURVEY CORNERS USED FOR REESTABLISHING THE CORNER

(not to scale)

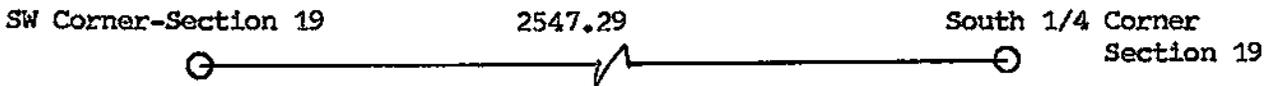

I, William C. Jung, Deputy County Surveyor,
 HEREBY CERTIFY THAT THE CORNER LOCATION SHOWN ON THIS RECORD
 WAS DETERMINED BY ME OR UNDER MY DIRECTION AND CONTROL AND
 THAT THIS U. S. PUBLIC LAND SURVEY MONUMENT RECORD IS CORRECT
 AND COMPLETE TO THE BEST OF MY KNOWLEDGE AND BELIEF.

William C. Jung 1/17/89
 Signature Date



Seal

Revised: 9/12/91

U. S. PUBLIC LAND SURVEY MONUMENT RECORD


INSTRUCTIONS :

This record shall show the location of the corner and shall include all of the following nine elements (a through i).

(a) Identify the corner by reference to the U.S. public land survey system.

○ = Corner monument restored.

*South 1/4 CORNER,
SEC. 19, T. 17N., R. 7W.,
4th P.M.,
LACROSSE COUNTY, Wisc.*

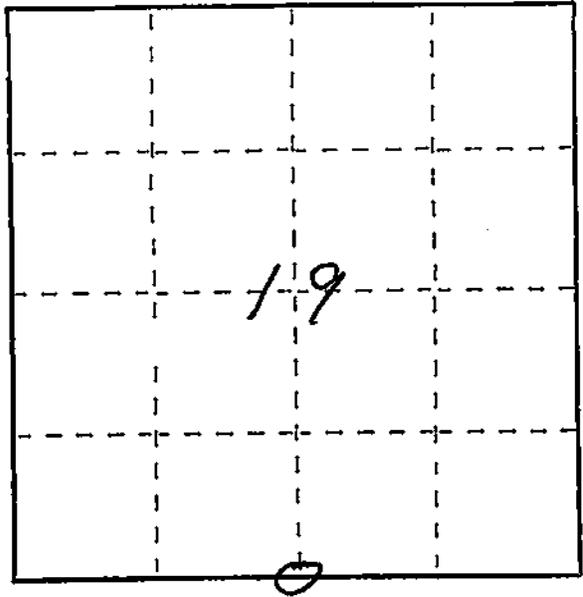


(b) Describe any record evidence, monument evidence, occupational evidence, testimonial evidence or any other material evidence you considered, and whether the monument was found or placed.

The Railroad Spike found was described in a 1931 Corps of ENGINEERS LAND LINE SURVEY, AND FITS THE DIMENSIONS AND CALLS OF THAT SURVEY.

(c) In the plan view drawing below, provide reference ties to at least 4 witness monuments, or, if the location is within a municipality, to at least 2 witness monuments. (Witness monuments shall be made of concrete, natural stone, iron or other equally durable material.) Describe witness monuments.

(d) Show a plan view drawing depicting the relevant monuments and reference ties which is sufficient in detail to enable accurate relocation of the corner monument if the corner monument is disturbed. Indicate north.

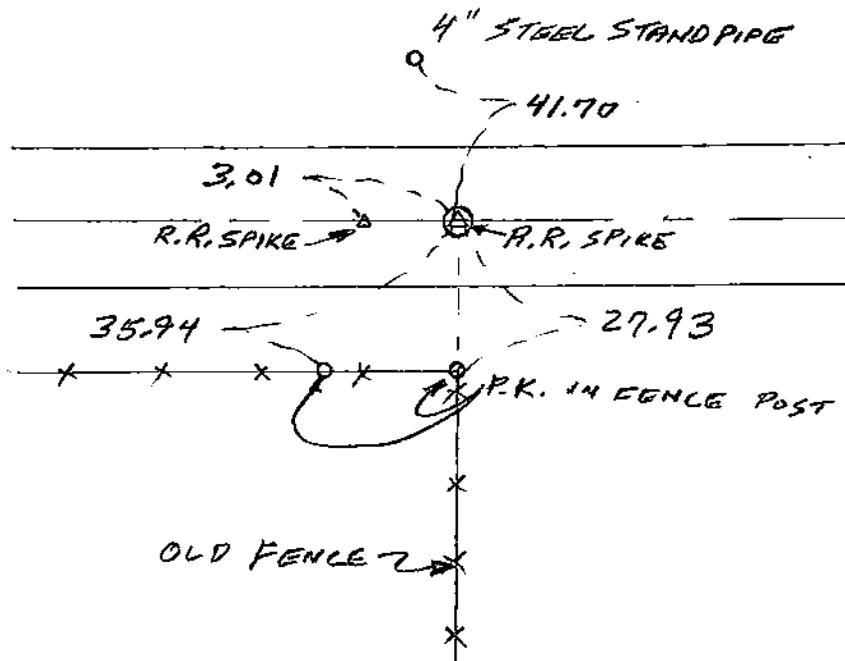

(e) Describe any material discrepancy between the location of the corner as restored or reestablished and the location of that corner as previously restored or reestablished by distance and direction. Show the discrepancy on the plan view drawing under (d), above. Show the distances between the corner as previously restored or reestablished and (1) the corner as restored or reestablished, and (2) to at least 2 of the witness monuments shown on the drawing in (d), above.

NONE

(f) Was the corner restored through acceptance of (1) an obliterated evidence location, or, (2) a found perpetuated location?


(g&h) Was the corner reestablished through lost corner proportionate methods? If so, show the method, including the directions and distances to other public land survey corners used as evidence or used for proportioning in determining the corner location?

No.

(i) I, KEITH M. GRAHAM
(type or print name) certify that the corner location shown on this record was determined by me or under my direction and control and that this U.S. Public Land Survey Monument Record is correct and complete to the best of my knowledge and belief.

Signature

Date

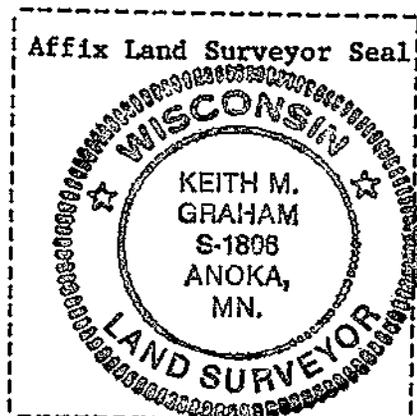

Keith M. Graham

2/1/85