


U. S. PUBLIC LAND SURVEY MONUMENT RECORD

SECTION 19 T 17 N, R 7 W, TOWN OF Onalaska
 LA CROSSE COUNTY

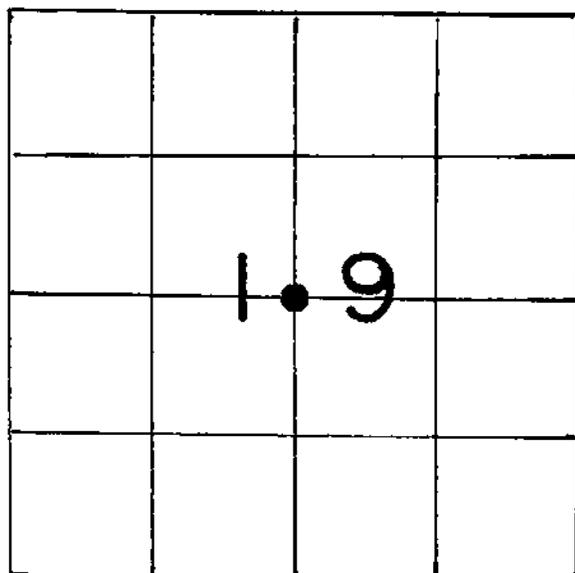

LOCATION OF LANDMARK

Crew: William C. Jung
 Peter Follansbee

Date: 12/5/88

Describe any record evidence, monument evidence, testimonial evidence or any other material evidence you considered and whether the monument was found or restored through acceptance of an obliterated evidence location.

Phil Scholze set an iron pipe at the corner at the intersection of the 1/4 lines.
 I removed the iron pipe and replaced it with a brass capped Lunde marker.

Describe or show any material discrepancy between the location of the restored corner and that of the corner previously restored or reestablished.

None known.

WISCONSIN COORDINATE SYSTEM
North
East
Theta Angle
Horiz. Order
Vert. Order
TYPE OF LANDMARK
Brass capped Lunde marker
BEARINGS ARE REFERENCED TO

*9/20/00
 Phil Scholze
 said that he
 also fd. an
 unrecorded I.P. @
 this corner.*

