


21707200000

U. S. PUBLIC LAND SURVEY MONUMENT RECORD

SECTION 28 T 17 N, R 7 W, TOWN OF ONALASKA

LA CROSSE COUNTY

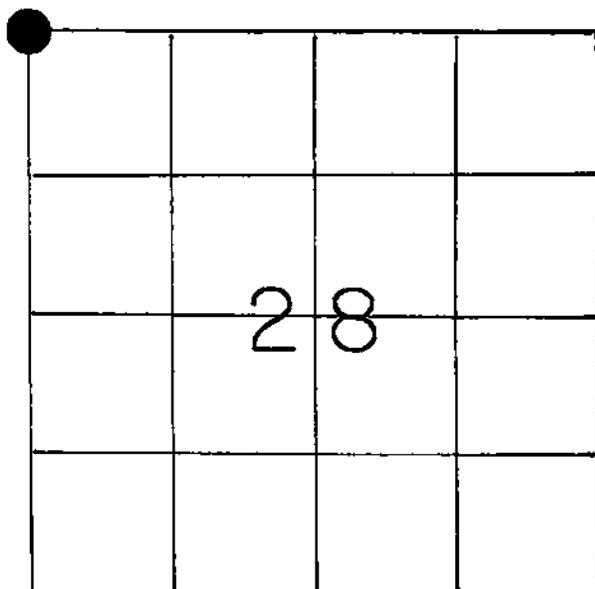

LOCATION OF LANDMARK

WISCONSIN COORDINATE SYSTEM

North

East

Theta Angle

Horiz. Order

Vert. Order

TYPE OF LANDMARK

EXIST. 1 3/4" IRON PIPE

BEARINGS ARE REFERENCED TO

ASSUMED BEARINGS

CREW: WILLIAM JUNG
PETER FOLLANSEHEE

8/11/87

Describe any record evidence, monument evidence, testimonial evidence or any other material evidence you considered and whether the monument was found or restored through acceptance of an obliterated evidence location.


I found an iron pipe that had been used as the corner in previous surveys and accepted it as the best available evidence of the original government corner position. This corner also falls at the old occupied fence corner.

Describe or show any material discrepancy between the location of the restored corner and that of the corner previously restored or reestablished.

NONE KNOWN

RECORD OF DURABLE WITNESS MONUMENTS


NO	DESCRIPTION	MAGNETIC BEARING	DISTANCE
1	SET P.K. NAIL IN HACK, 11" HICKORY, DEL.-BLZD.	N 01°E	16.59 Ft.
2	SET P.K. NAIL IN HACK, 7" WHT. OAK, DEL.-BLZD.	N 62°E	28.27 Ft.
3	SET P.K. NAIL IN HACK, 13" WHT. OAK, DEL.-BLZD.	N 77°E	17.87 Ft.
4	SET P.K. NAIL IN HACK, 6" HICKORY, DEL.-BLZD.	S 49°W	24.48 Ft.

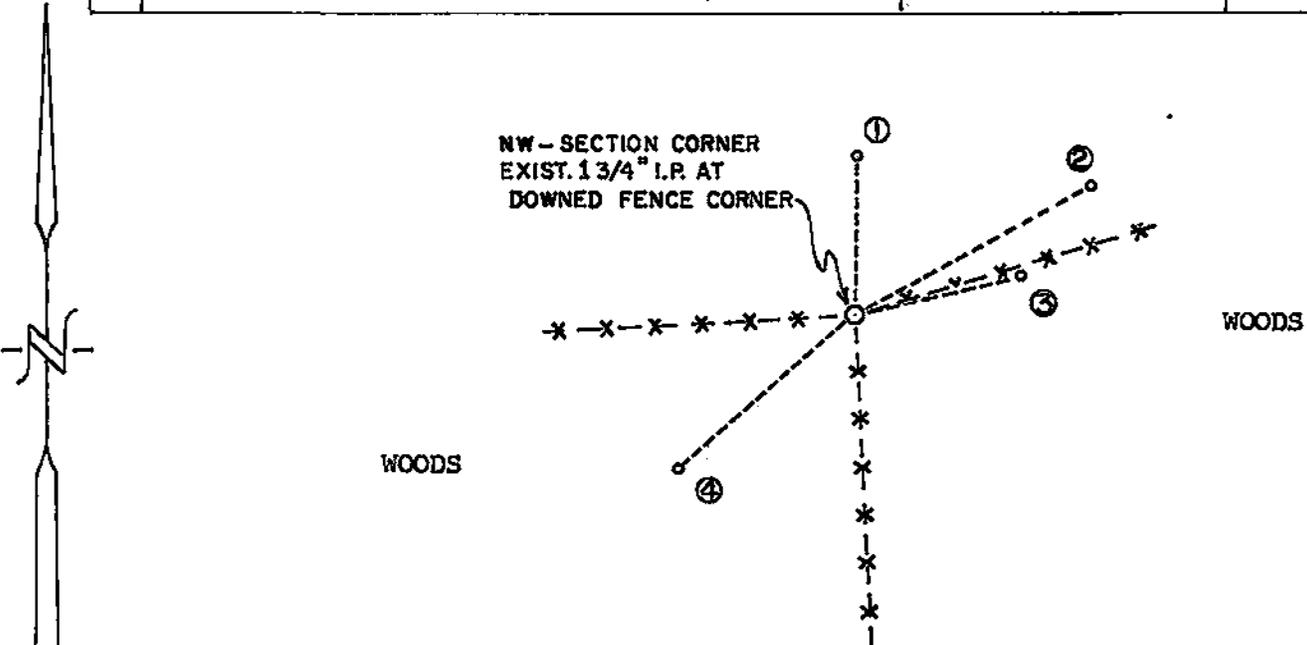

PLAN VIEW DRAWING OF REFERENCE TIES

MAP SHOWING DISTANCE AND DIRECTION TO OTHER PUBLIC LAND SURVEY CORNERS USED FOR REESTABLISHING THE CORNER

(NOT TO SCALE)

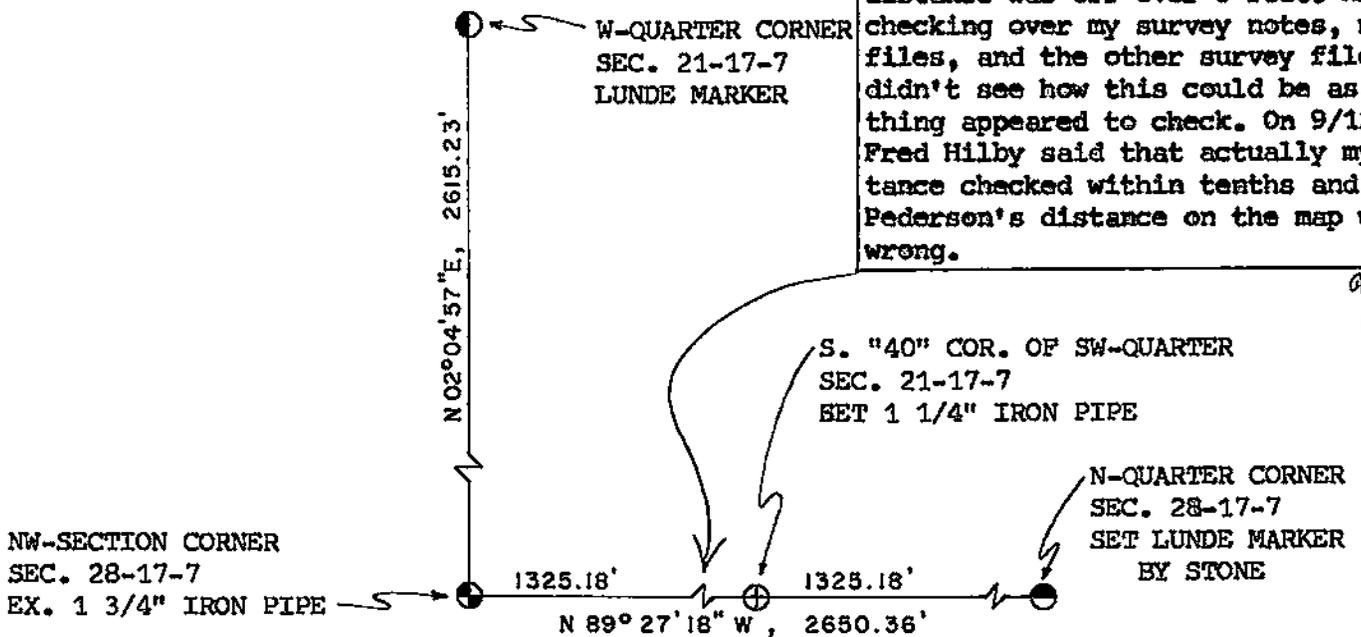

On 9/6/07 K. Don Pederson filed a plat of survey indicating that my 1/2 mile distance was off over 6 feet. After checking over my survey notes, my files, and the other survey files, I didn't see how this could be as everything appeared to check. On 9/12/07 Fred Hilby said that actually my distance checked within tenths and that Pederson's distance on the map was wrong.

awef
1/23/08

I, WILLIAM C. JUNG
HEREBY CERTIFY THAT THE CORNER LOCATION SHOWN ON THIS RECORD WAS DETERMINED BY ME OR UNDER MY DIRECTION AND CONTROL AND THAT THIS U. S. PUBLIC LAND SURVEY MONUMENT RECORD IS CORRECT AND COMPLETE TO THE BEST OF MY KNOWLEDGE AND BELIEF.

William C. Jung Deputy County Surveyor, December 18, 1987
Signature Date



Seal