


21707200020

U. S. PUBLIC LAND SURVEY MONUMENT RECORD

SECTION 29 T 17 N, R 7 W, TOWN OF ONALASKA

LA CROSSE COUNTY

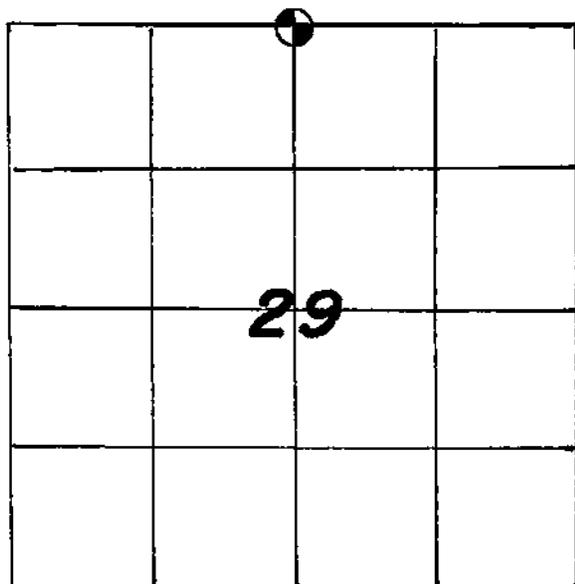

LOCATION OF LANDMARK

CREW: BILL JUNG, PERRY DAHL

DATE: 3-13-87

Describe any record evidence, monument evidence, testimonial evidence or any other material evidence you considered and whether the monument was found or restored through acceptance of an obliterated evidence location.

Dick Berg set an iron pipe at this corner in 1978. I found the iron pipe, removed it, and replaced it with a brass capped Lunde marker. I accepted Berg's location as the best available evidence of the original government corner position. The monument is only 1' South of an old East-West line fence.

Describe or show any material discrepancy between the location of the restored corner and that of the corner previously restored or reestablished.

None known.

WISCONSIN COORDINATE SYSTEM

North

East

Theta Angle

Horiz. Order

Vert. Order

TYPE OF LANDMARK


BRASS CAPPED LUNDE MARKER

BEARINGS ARE REFERENCED TO

Assumed


RECORD OF DURABLE WITNESS MONUMENTS

NO	DESCRIPTION	BEARING	DISTANCE
1	NORTHEAST CORNER OF POWER BOX	---	90.48'
2	NORTHEAST CORNER OF HOUSE	---	81.3'
3	1" IRON PIPE (existing) Plat = 204.37	---	204.24'
4	1" IRON PIPE (existing) Plat = 125.04	---	124.88'

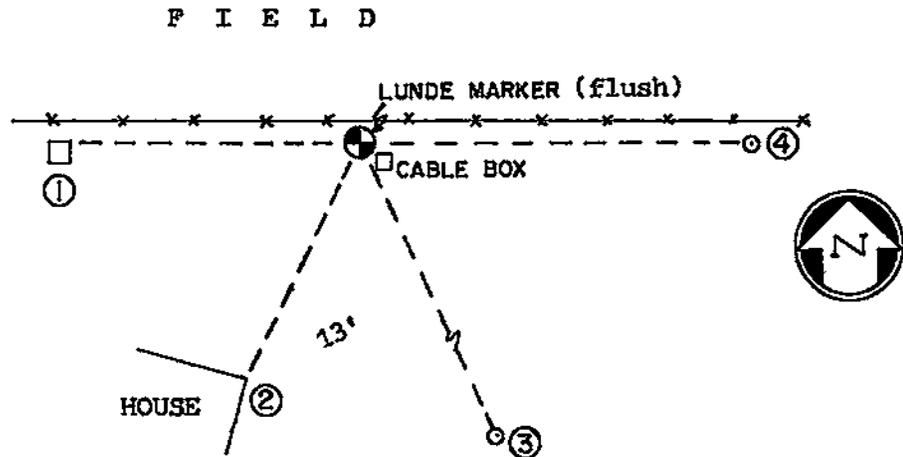

MAP SHOWING DISTANCE AND DIRECTION TO OTHER PUBLIC LAND SURVEY CORNERS USED FOR REESTABLISHING THE CORNER


(not to scale)

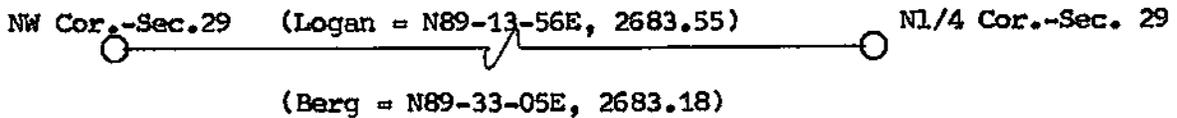

I, WILLIAM C. JUNG , Deputy County Surveyor,
 HEREBY CERTIFY THAT THE CORNER LOCATION SHOWN ON THIS RECORD
 WAS DETERMINED BY ME OR UNDER MY DIRECTION AND CONTROL AND
 THAT THIS U. S. PUBLIC LAND SURVEY MONUMENT RECORD IS CORRECT
 AND COMPLETE TO THE BEST OF MY KNOWLEDGE AND BELIEF.

William C. Jung
 Signature

April 22, 1987
 Date

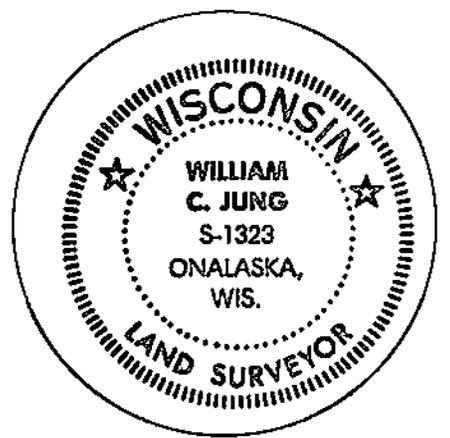

Seal