


21707210020

U. S. PUBLIC LAND SURVEY MONUMENT RECORD

SECTION 28 T 17 N, R 7 W, TOWN OF ONALASKA

LA CROSSE COUNTY

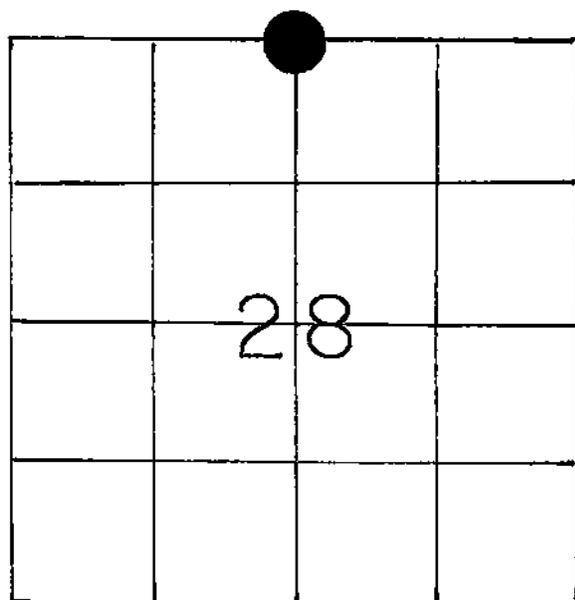

LOCATION OF LANDMARK

WISCONSIN COORDINATE SYSTEM

North

East

Theta Angle

Horiz. Order

Vert. Order

TYPE OF LANDMARK

SET BRASS CAP LUNDE MARKER NEAR STONE

BEARINGS ARE REFERENCED TO

ASSUMED BEARINGS

CREW: WILLIAM C. JUNG
PETER F. FOLLANSBEE

12-01-1987

Describe any record evidence, monument evidence, testimonial evidence or any other material evidence you considered and whether the monument was found or restored through acceptance of an obliterated evidence location.

I found a stone at the 1/4 corner which I feel was set by a surveyor in an unrecorded survey. Ray Pelishek (County Surveyor) inspected the site and agrees with this opinion. This location fits other evidence found in the section. I accepted the location of the stone as the best available evidence of the original government corner position, removed it, and replaced it with brass capped Lunde Marker. The stone was reset to the Northeast of the Lunde as a witness marker only. Based on my experience, I am convinced that the stone was definitely set at the old 1/4 corner position.

Describe or show any material discrepancy between the location of the restored corner and that of the corner previously restored or reestablished.

Dick Berg surveyed to the West and Southwest and used a 1/4 corner position for his descriptions and surveys that does not agree with my 1/4 corner location. LaCrosse Engineering also had a computed 1/4 corner position for descriptions and surveys that does not agree with my location.

Note: Chalsma and Logan do not object to my corner location and are using it for the subdivision of the NW1/4 of Section 28.


RECORD OF DURABLE WITNESS MONUMENTS

NO	DESCRIPTION	MAGNETIC	
		BEARING	DISTANCE
1	SET P.K. NAIL IN 18" Aspen (DBL. BLAZED)	S 66°W	39.02 FT.
2	SET P.K. NAIL IN 20" WHITE OAK (DBL. BLAZED)	S 84°W	77.11 FT.
3	SET P.K. NAIL IN 21" WHITE OAK (DBL. BLAZED)	S 87°W	97.01 FT.
4	EXISTING 1" IRON PIPE NEAR FENCE CORNER	S 87°W	8.36 FT.

Note: The stone was found 1'N. and 2'W. of old E-W tie wire in the fence. The stone was 26"x10", pointed, and 3" thick. I found no evidence of a stake under the stone, or any old bearing trees of record.

SET LUNDE MARKER NEAR STONE & TO NORTH OF FENCE.

FOUND POINTED FIELD STONE NEAR TIE WIRE ON FENCE-POST.

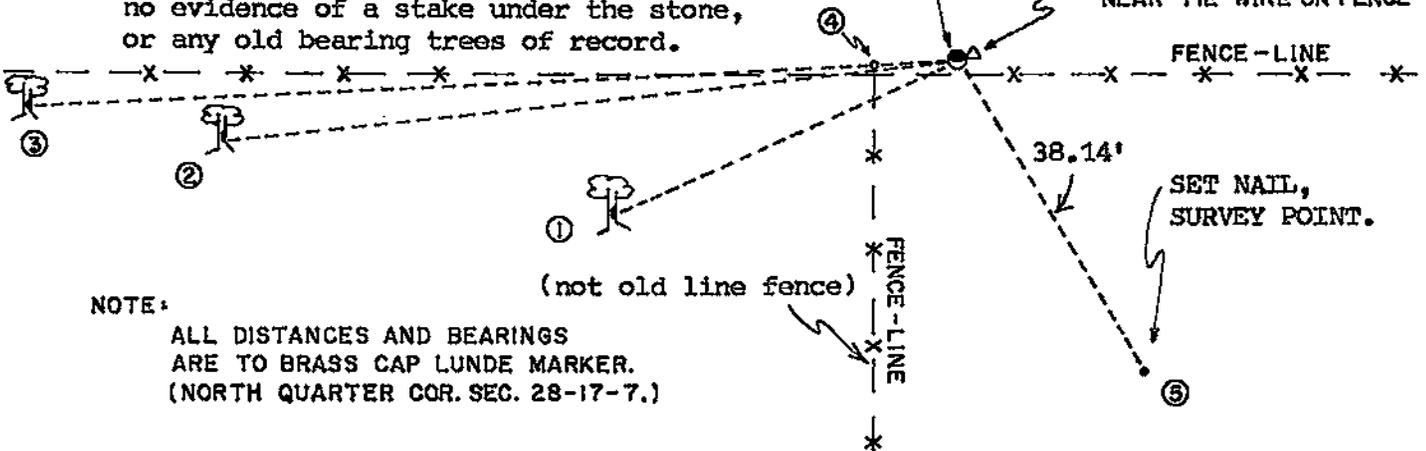

NOTE: ALL DISTANCES AND BEARINGS ARE TO BRASS CAP LUNDE MARKER. (NORTH QUARTER COR. SEC. 28-17-7.)

PLAN VIEW DRAWING OF REFERENCE TIES

MAP SHOWING DISTANCE AND DIRECTION TO OTHER PUBLIC LAND SURVEY CORNERS USED FOR REESTABLISHING THE CORNER

(NOT TO SCALE)


we
1/23/08

On 9/08/07 K. Don Pederson filed a plat of survey indicating that my 1/2 mile distance was off over 6 feet. After checking over my survey notes, my files, and the other survey files, I didn't see how this could be as everything appeared to check. On 9/12/07 Fred Hilby said that actually my distance checked within tenths and that Pederson's distance on the map was wrong.

NW-SECTION CORNER
SEC. 28-17-7
EX. 1 3/4" IRON PIPE

N-QUARTER CORNER
SEC. 28-17-7
SET LUNDE MARKER
BY STONE.

NE-SECTION CORNER
SEC. 28-17-7
EX. IRON PIPE

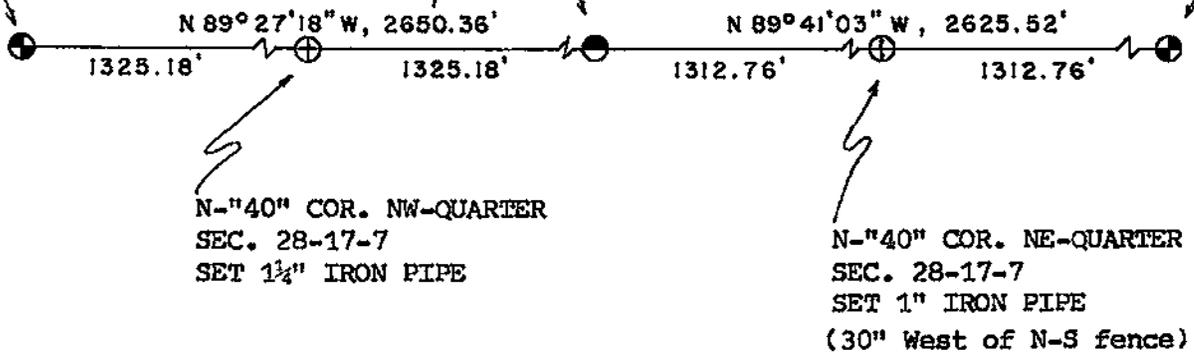


I, WILLIAM C. JUNG
HEREBY CERTIFY THAT THE CORNER LOCATION SHOWN ON THIS RECORD WAS DETERMINED BY ME OR UNDER MY DIRECTION AND CONTROL AND THAT THIS U. S. PUBLIC LAND SURVEY MONUMENT RECORD IS CORRECT AND COMPLETE TO THE BEST OF MY KNOWLEDGE AND BELIEF.

William C. Jung
Signature

Deputy County Surveyor, January 6, 1988

Date

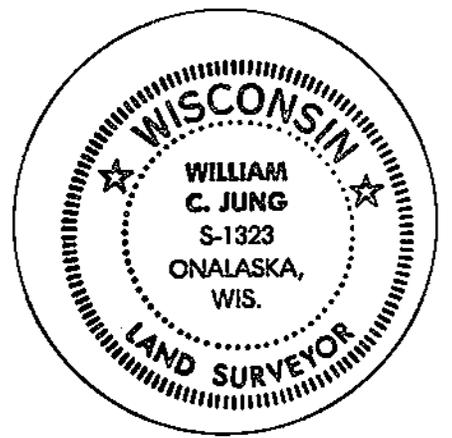

Seal