


21707212000

U. S. PUBLIC LAND SURVEY MONUMENT RECORD

SECTION 21 T 17 N, R 7 W, TOWN OF ONALASKA

LA CROSSE COUNTY

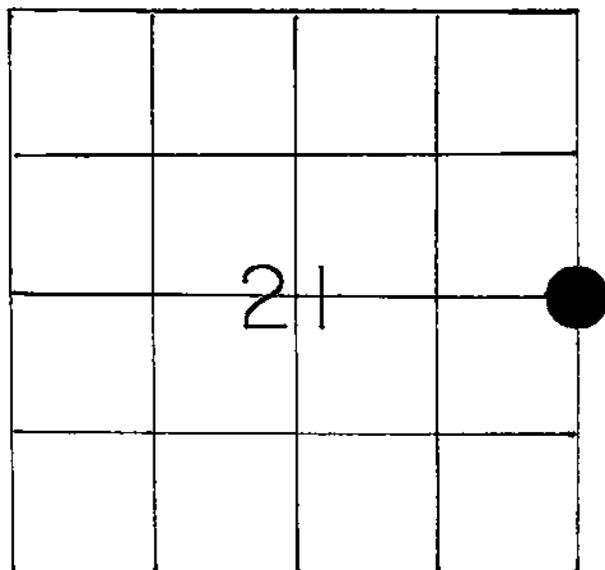

LOCATION OF LANDMARK

CREW: WILLIAM C. JUNG
 PETER F. FOLLANSBEE

11-05-1987

Describe any record evidence, monument evidence, testimonial evidence or any other material evidence you considered and whether the monument was found or restored through acceptance of an obliterated evidence location.

I accepted the old occupied corner as the best available evidence of the original government corner position and monumented it with a 1" iron pipe.

Describe or show any material discrepancy between the location of the restored corner and that of the corner previously restored or reestablished.

NONE KNOWN

WISCONSIN COORDINATE SYSTEM

North

East

Theta Angle

Horiz. Order

Vert. Order

TYPE OF LANDMARK


SET 1" IRON PIPE

BEARINGS ARE REFERENCED TO

ASSUMED BEARINGS


RECORD OF DURABLE WITNESS MONUMENTS

NO	DESCRIPTION	MAGNETIC	
		BEARING	DISTANCE
1	SET P.K. NAIL IN 29" BLACK OAK (BLAZED)	SOUTH +	1.14 FT.
2	SET P.K. NAIL IN 17" WHITE OAK (DEL. BLAZED)	N 09°W	59.60 FT.
3	SET P.K. NAIL IN 16" WHITE OAK (DEL. BLAZED)	S 67°E	90.80 FT.
4	SET P.K. NAIL IN 22" BLACK OAK (DEL. BLAZED)	S 18°E	36.30 FT.

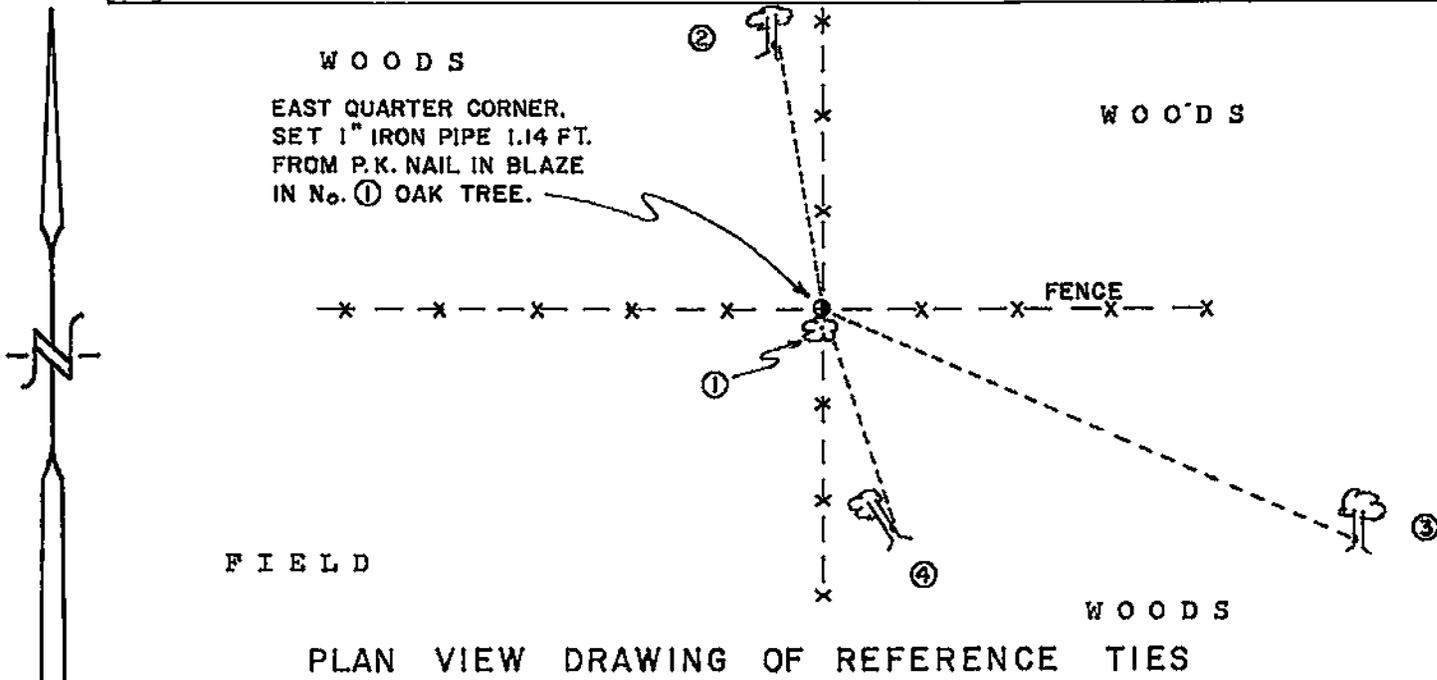

MAP SHOWING DISTANCE AND DIRECTION TO OTHER PUBLIC LAND SURVEY CORNERS USED FOR REESTABLISHING THE CORNER

(NOT TO SCALE)

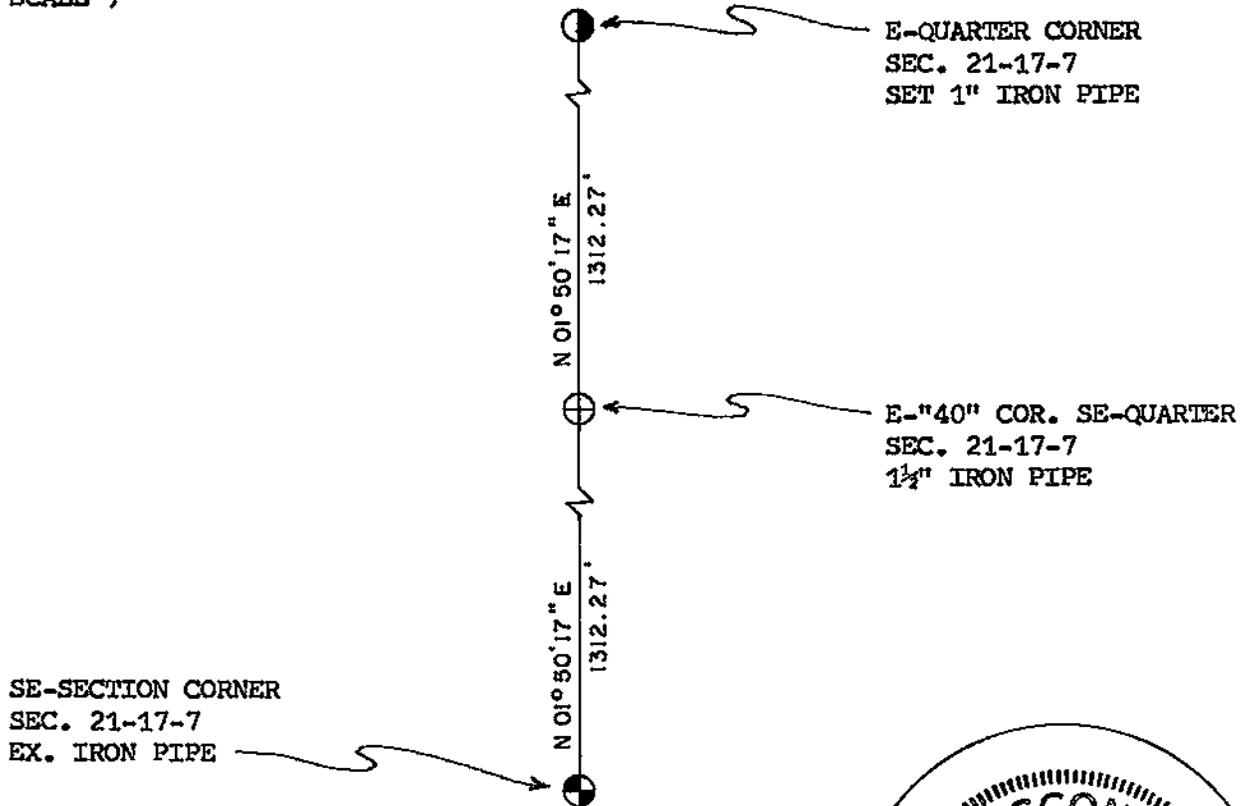

I, WILLIAM C. JUNG
HEREBY CERTIFY THAT THE CORNER LOCATION SHOWN ON THIS RECORD
WAS DETERMINED BY ME OR UNDER MY DIRECTION AND CONTROL AND
THAT THIS U. S. PUBLIC LAND SURVEY MONUMENT RECORD IS CORRECT
AND COMPLETE TO THE BEST OF MY KNOWLEDGE AND BELIEF.

William C. Jung Deputy County Surveyor, December 18, 1987
Signature Date



Seal