


21707220000

U. S. PUBLIC LAND SURVEY MONUMENT RECORD

SECTION 22 T 17 N, R 7 W, TOWN OF ONALASKA
 LA CROSSE COUNTY

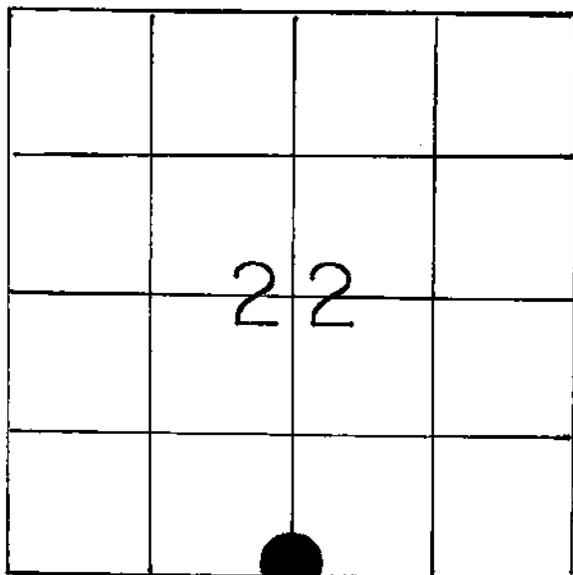

LOCATION OF LANDMARK

CREW: WILLIAM C. JUNG
 PETER F. FOLLANSBEE

12-04-1987

Describe any record evidence, monument evidence, testimonial evidence or any other material evidence you considered and whether the monument was found or restored through acceptance of an obliterated evidence location.

I projected a line from the Southwest Corner of Section 22 through the pipe shown as "D" on Hurlburt's map dated May 14, 1985, and intersected this line with the occupied East line of the SE1/4-SW1/4 projected South. This location fits the occupied corner very well, including the old line fences to the East and South. I set an iron pipe at the corner.


Describe or show any material discrepancy between the location of the restored corner and that of the corner previously restored or reestablished.

NONE KNOWN

WISCONSIN COORDINATE SYSTEM
North
East
Theta Angle
Horiz. Order
Vert. Order
TYPE OF LANDMARK
SET 1 1/4" IRON PIPE
BEARINGS ARE REFERENCED TO
ASSUMED BEARINGS


RECORD OF DURABLE WITNESS MONUMENTS
MAGNETIC

NO	DESCRIPTION	BEARING	DISTANCE
1	SET P.K. NAIL IN 24" BLACK OAK (DBL. BLAZED)	NORTH \pm	40.71 FT.
2	SET P.K. NAIL IN 13" WHITE OAK (DBL. BLAZED)	S 21°E	67.41 FT. (slope)
3	SET P.K. NAIL IN 9" ELM (DBL. BLAZED)	S 10°E	41.84 FT. "
4	SET P.K. NAIL IN 7" HICKORY (DBL. BLAZED)	S 05°W \pm	51.87 FT. "

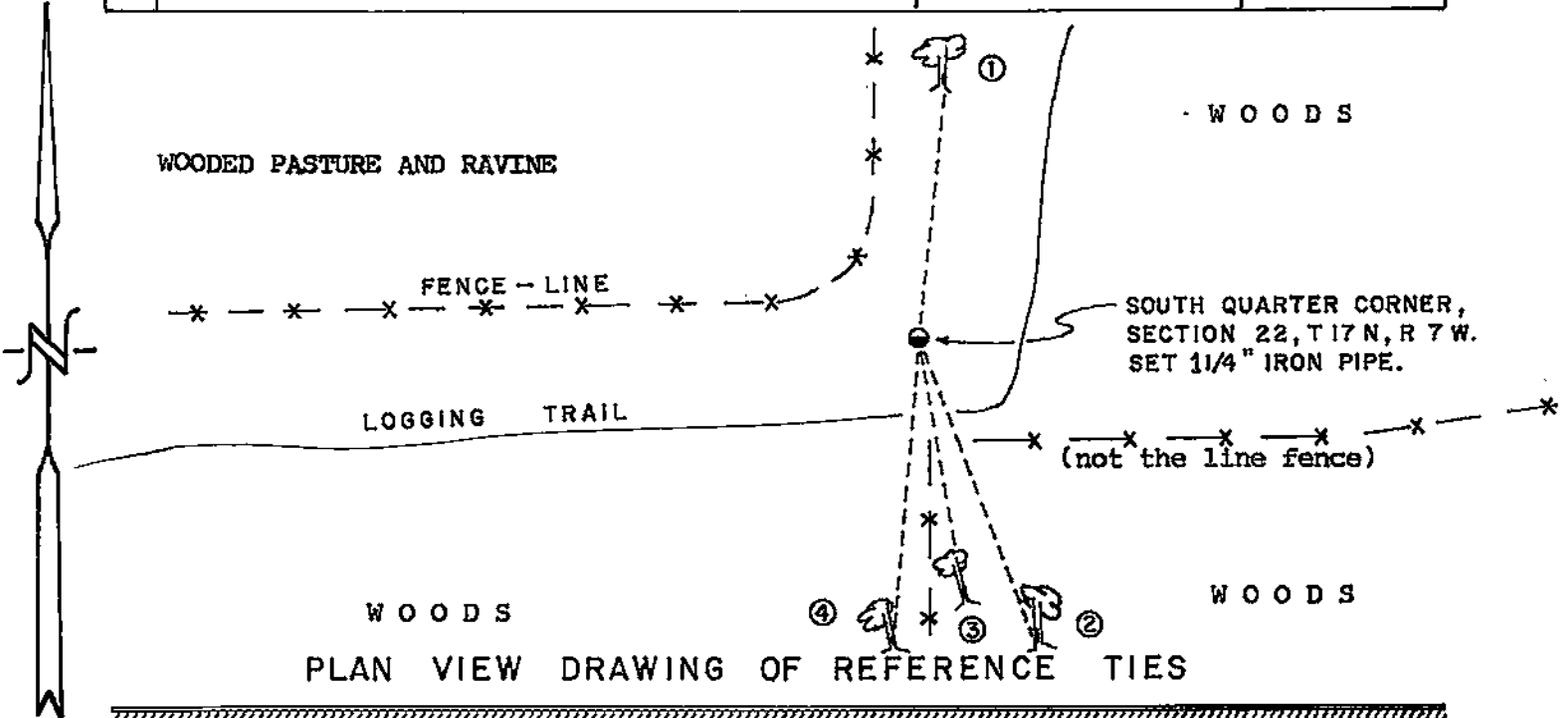

MAP SHOWING DISTANCE AND DIRECTION TO OTHER PUBLIC LAND SURVEY CORNERS USED FOR REESTABLISHING THE CORNER

(NOT TO SCALE)

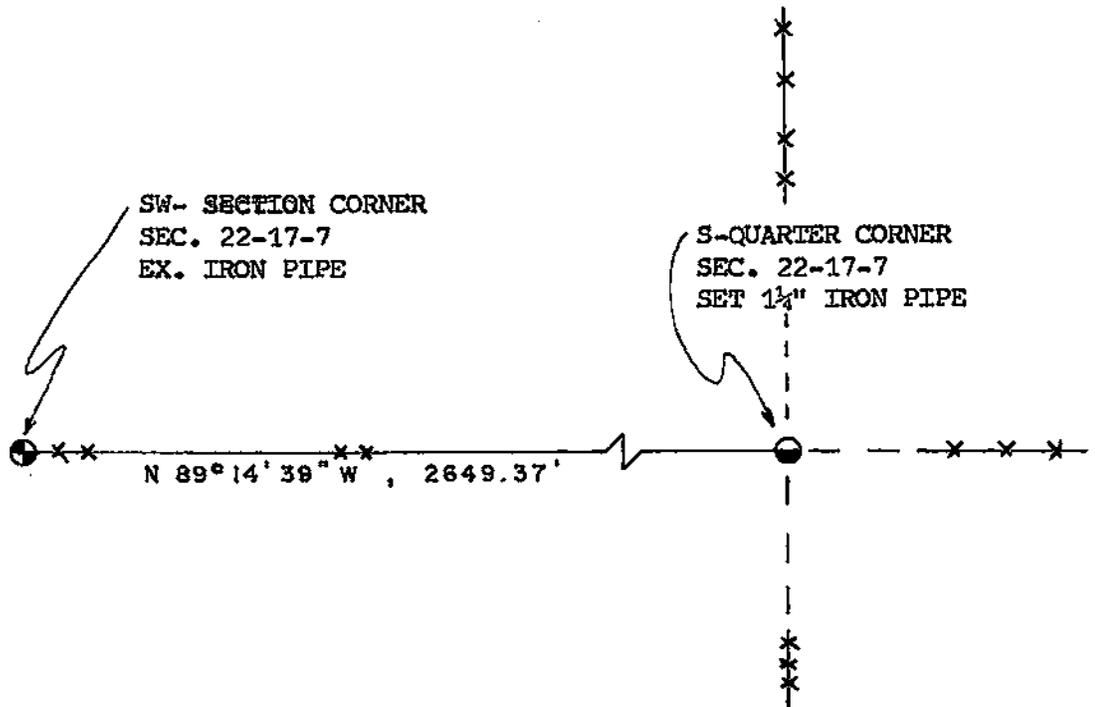

I, WILLIAM C. JUNG
HEREBY CERTIFY THAT THE CORNER LOCATION SHOWN ON THIS RECORD
WAS DETERMINED BY ME OR UNDER MY DIRECTION AND CONTROL AND
THAT THIS U. S. PUBLIC LAND SURVEY MONUMENT RECORD IS CORRECT
AND COMPLETE TO THE BEST OF MY KNOWLEDGE AND BELIEF.

William C. Jung Deputy County Surveyor, December 30, 1987
Signature Date

