


21707222000

U. S. PUBLIC LAND SURVEY MONUMENT RECORD

SECTION 23 T 17 N, R 7 W, TOWN OF ONALASKA
 LA CROSSE COUNTY

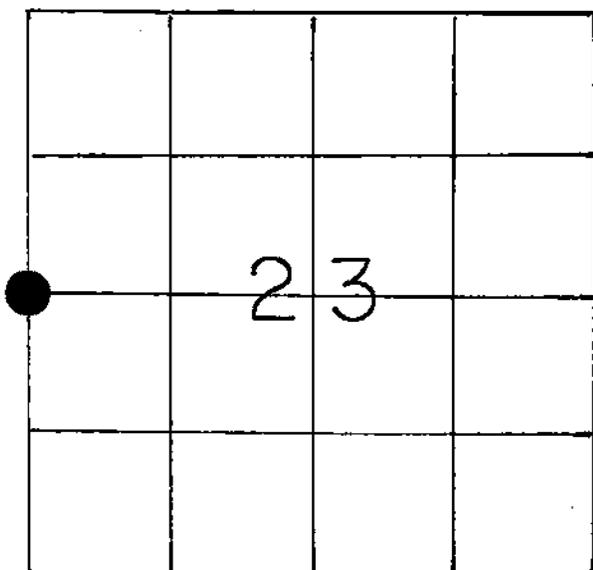

LOCATION OF LANDMARK

Crew: WILLIAM C. JUNG
 PETER F. FOLLANSBEE
 Date: 10/02/1996

WISCONSIN COORDINATE SYSTEM
North
East
Theta Angle
Horiz. Order
Vert. Order
TYPE OF LANDMARK
1½" x 28½" round Iron Bar.
BEARINGS ARE REFERENCED TO
GRID NORTH.

Describe any record evidence, monument evidence, testimonial evidence or any other material evidence you considered and whether the monument was found or restored through acceptance of an obliterated evidence location.

There was no evidence of the original government corner. I computed out the location of this corner by single proportionate measurement and monumented the corner with an iron bar.

Describe or show any material discrepancy between the location of the restored corner and that of the corner previously restored or reestablished.

None known.

