


21707230000

U. S. PUBLIC LAND SURVEY MONUMENT RECORD

SECTION 23 T 17 N, R 7 W, TOWN OF HAMILTON
 LA CROSSE COUNTY

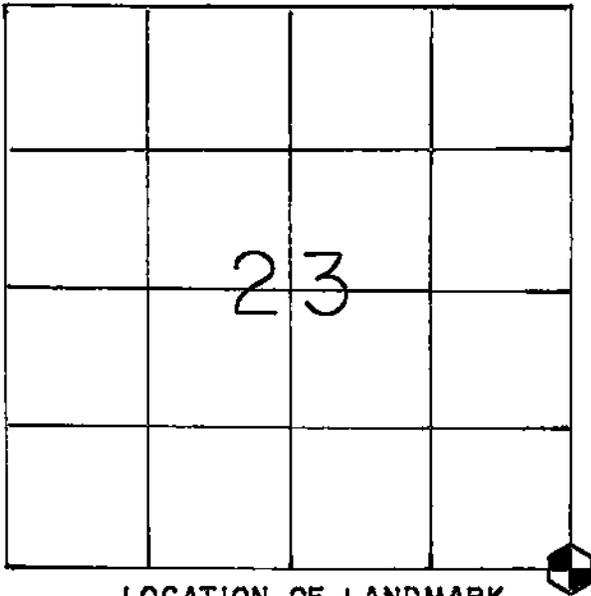

LOCATION OF LANDMARK

Crew: WILLIAM C. JUNG
 PETER F. FOLLANSBEE
 Date: 10/01/1996

WISCONSIN COORDINATE SYSTEM

North

East

Theta Angle

Horiz. Order

Vert. Order

TYPE OF LANDMARK

Brass cap Lunde marker.

BEARINGS ARE REFERENCED TO

GRID NORTH.

Describe any record evidence, monument evidence, testimonial evidence or any other material evidence you considered and whether the monument was found or restored through acceptance of an obliterated evidence location.

I accepted the occupied conditions as the best available evidence of the original government corner position. I monumented the corner with a brass capped Lunde marker.

Describe or show any material discrepancy between the location of the restored corner and that of the corner previously restored or reestablished.


None known.

RECORD OF DURABLE WITNESS MONUMENTS
GRID NORTH

NO	DESCRIPTION	BEARING	DISTANCE
1	Set P.K. Nail in SW-side 14" W. Oak	N 10°08'47"W	205.57 Ft.
2	Ex. pinched Iron Pipe NE-side 30"W. Oak <small>w/N-S wire</small>	N 00°41'01"E	208.41 Ft.
3	Set P.K. Nail in SE-side 9" Maple	N 64°01'27"E	143.69 Ft.
4	Set P.K. Nail in SE-side 5½" Hickory	N 72°38'08"E	120.01 Ft.


(Note: the 3 Bearing Trees are double blazed.)

(Not to scale)

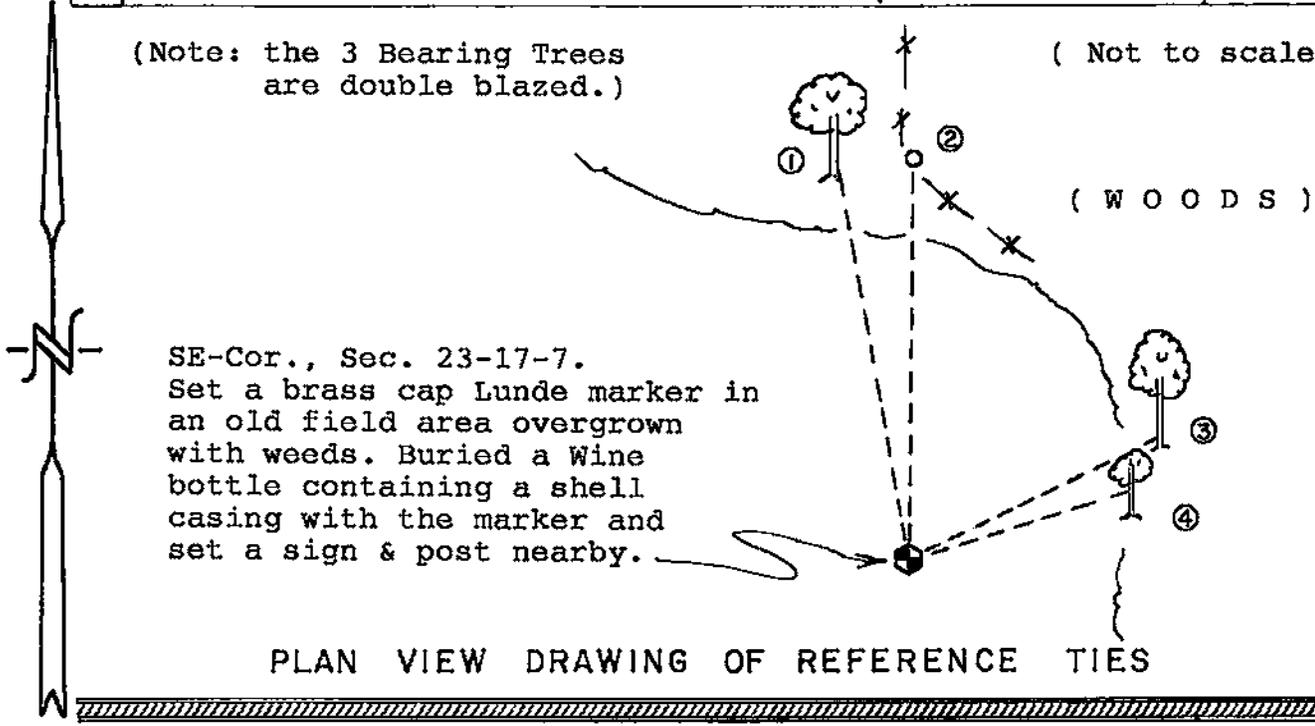

MAP SHOWING DISTANCE AND DIRECTION TO OTHER PUBLIC LAND SURVEY CORNERS USED FOR REESTABLISHING THE CORNER

(not to scale)

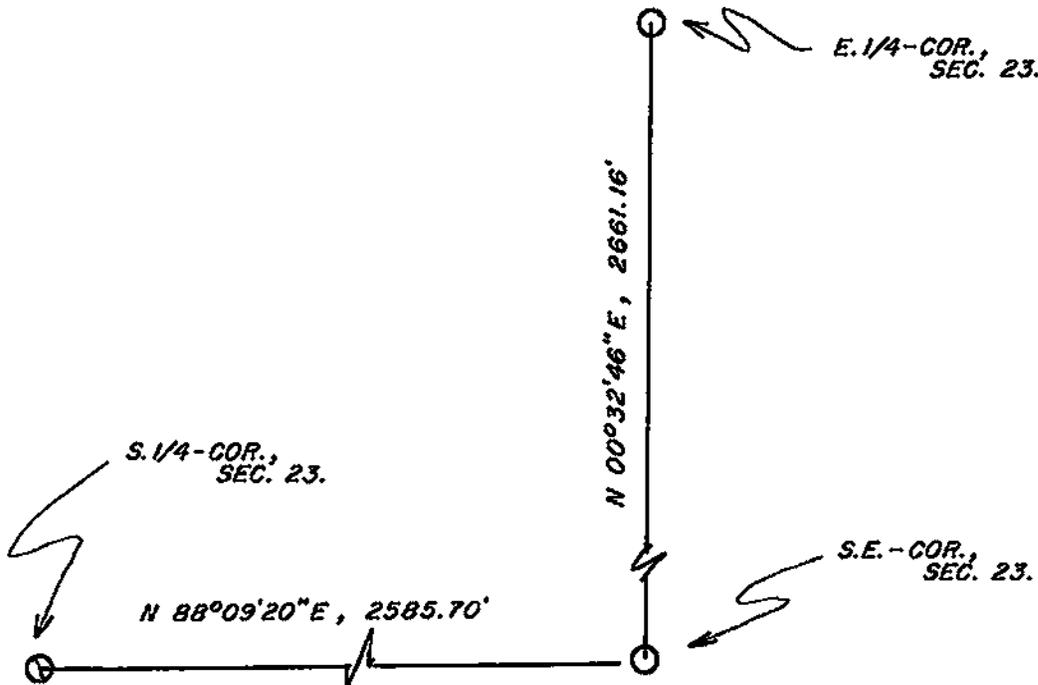

I, William C. Jung, County Surveyor
HEREBY CERTIFY THAT THE CORNER LOCATION SHOWN ON THIS RECORD WAS DETERMINED BY ME OR UNDER MY DIRECTION AND CONTROL AND THAT THIS U. S. PUBLIC LAND SURVEY MONUMENT RECORD IS CORRECT AND COMPLETE TO THE BEST OF MY KNOWLEDGE AND BELIEF.

William C. Jung 1/6/97
Signature Date



Seal