


21707230020

U. S. PUBLIC LAND SURVEY MONUMENT RECORD

SECTION 26 T 17 N, R 7 W, TOWN OF Onalaska

LA CROSSE COUNTY

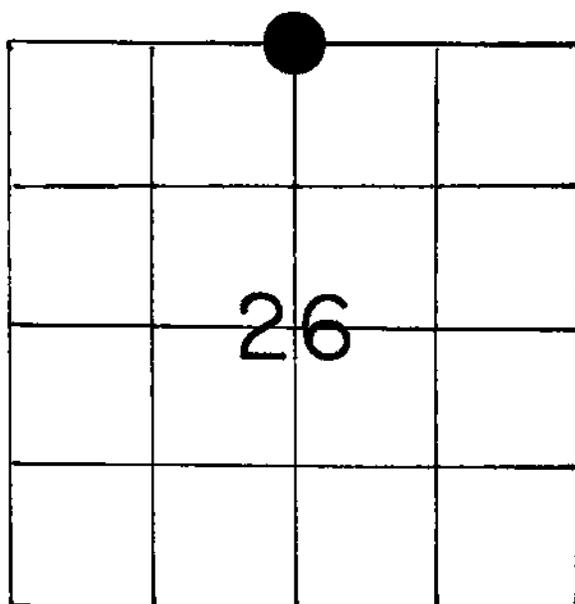

LOCATION OF LANDMARK

Crew: WILLIAM C. JUNG
PETER F. FOLLANSBEE

Date: 6/30/1989

Describe any record evidence, monument evidence, testimonial evidence or any other material evidence you considered and whether the monument was found or restored through acceptance of an obliterated evidence location.

I accepted the iron pipe as the best available evidence of the original government corner and replaced it with a brass capped Lunde marker.

(See attached R.D. Walter notes.)

Describe or show any material discrepancy between the location of the restored corner and that of the corner previously restored or reestablished.

NONE KNOWN

WISCONSIN COORDINATE SYSTEM

North

East

Theta Angle

Horiz. Order

Vert. Order

TYPE OF LANDMARK

BRASS CAP LUNDE MARKER


BEARINGS ARE REFERENCED TO

Assumed North

RECORD OF DURABLE WITNESS MONUMENTS

NO	DESCRIPTION	MAGNETIC	
		BEARING	DISTANCE
1	Set P.K. Nail on S.-side, 29" White Oak	N 90° W	30.67 Ft.
2	Set 3/4" I.P. @ end of NW.-wing wall	S 45° W	7.78 Ft.
3	Set P.K. Nail on SE-side of nut tree(7")	N 34° E	28.82 Ft.
4	Set P.K. Nail on S.-side 11" nut tree	N 82° E	51.92 Ft.

(NOTE: ALL TREES ARE UNBLAZED)

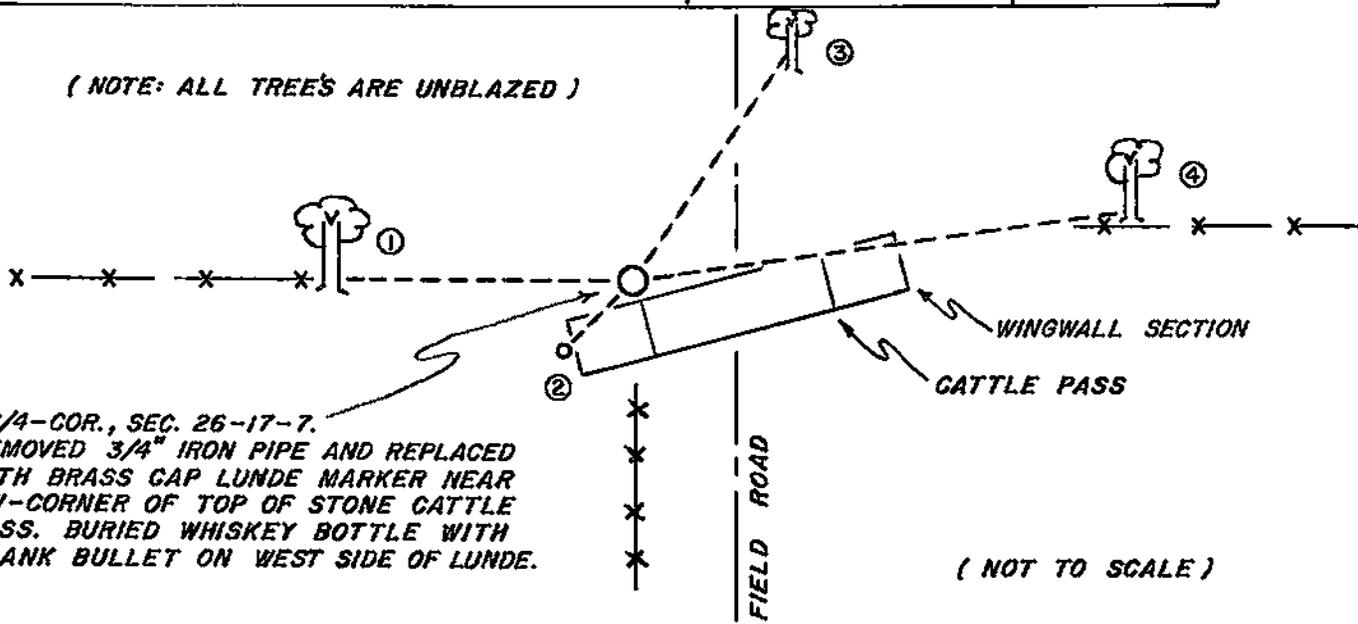


PLAN VIEW DRAWING OF REFERENCE TIES

MAP SHOWING DISTANCE AND DIRECTION TO OTHER PUBLIC LAND SURVEY CORNERS USED FOR REESTABLISHING THE CORNER

(not to scale)

N 1/4-Cor., Sec. 26-17-7.
Brass cap Lunde marker.

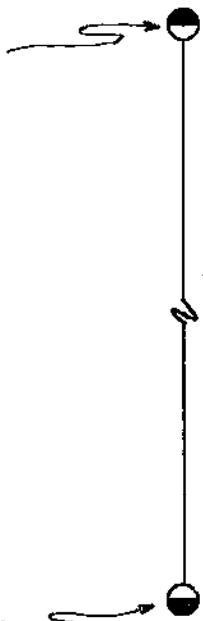

S 00°07'09" E, 5270.80'
R.D. Walter measurement.

S 1/4-Cor., Sec. 26-17-7.
Brass cap Lunde marker.

I, William C. Jung, Deputy County Surveyor
HEREBY CERTIFY THAT THE CORNER LOCATION SHOWN ON THIS RECORD WAS DETERMINED BY ME OR UNDER MY DIRECTION AND CONTROL AND THAT THIS U. S. PUBLIC LAND SURVEY MONUMENT RECORD IS CORRECT AND COMPLETE TO THE BEST OF MY KNOWLEDGE AND BELIEF.

William C. Jung
Signature

December 21, 1989
Date



Seal

WALTER LAND SURVEYS

3/24/1989

NORTH 1/4 CORNER SECTION 26, T17N, R7W

Gov't Survey Set 1/4 Section Corner


Arch³ April
1988

After a thorough SEARCH of the County Records I found ONE SURVEY tied to the North 1/4 corner.

RICHARD D. WALTER R.L.S. TRAVELED to the area of the corner and FOUND a 3/4" pipe at an OLD FENCE INTERSECTION.

Life long RESIDENT and LAND OWNER (Walter Waldenberger) in the AREA of the corner GAVE TESTIMONY that the 3/4" pipe WAS SET by a SURVEYOR in the PAST at the FENCE INTERSECTION and that it MARKED the LOCATION of the North 1/4 corner.

Accepted 3/4" pipe as best evidence of the 1/4 corner.

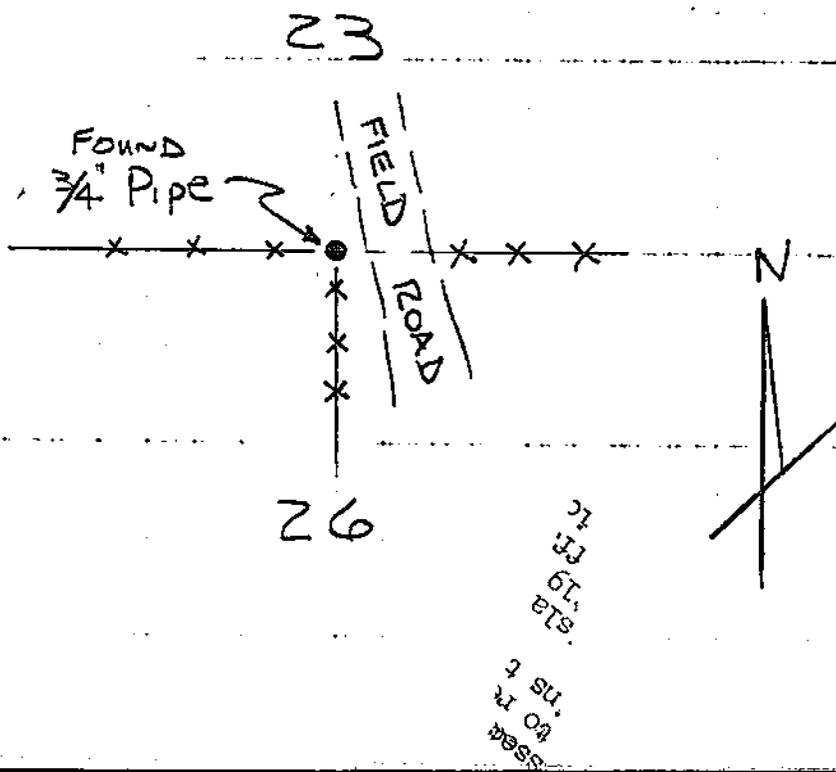

SEARCHED TO RECORD
APR 19 1988
R.D. WALTER