


U. S. PUBLIC LAND SURVEY MONUMENT RECORD

SECTION 23 T 17 N, R 7 W, TOWN OF HAMILTON
LA CROSSE COUNTY

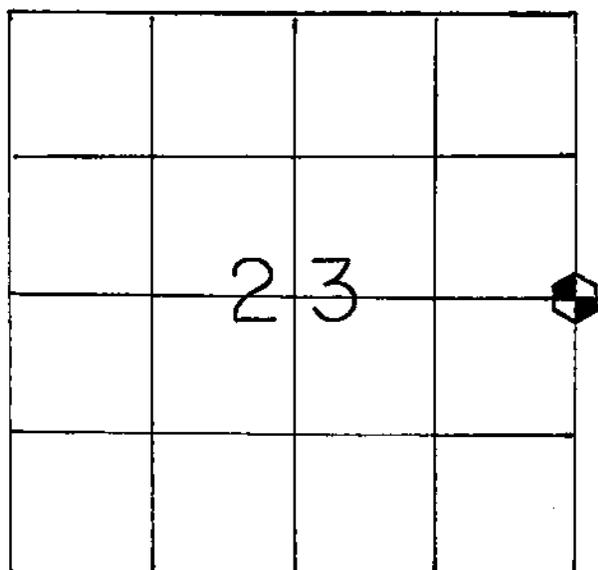

LOCATION OF LANDMARK

Crew: WILLIAM C. JUNG
PETER F. FOLLANSBEE
Date: 9/25/1996

WISCONSIN COORDINATE SYSTEM
North
East
Theta Angle
Horiz. Order
Vert. Order
TYPE OF LANDMARK
Brass cap Lunde marker.
BEARINGS ARE REFERENCED TO
GRID NORTH.

Describe any record evidence, monument evidence, testimonial evidence or any other material evidence you considered and whether the monument was found or restored through acceptance of an obliterated evidence location.


I set this corner at a location that best fits the occupied evidence found in Section 23. A brass capped Lunde marker was set at the corner. Just to the West of the Lunde marker I found an old downed tie post.

Describe or show any material discrepancy between the location of the restored corner and that of the corner previously restored or reestablished.

None known.


RECORD OF DURABLE WITNESS MONUMENTS

NO	DESCRIPTION	BEARING	DISTANCE
1	My Existing Nail in center of logging road	S 86° 48' 33" W (GRID)	123.84 Ft.
2	Set P.K. Nail in NW-side 8" Maple	S 45° W(mag.)	64.78 Ft.
3	Set P.K. Nail in NW-side 10" Maple	S 27° W(mag.)	34.10 Ft.
4	Set P.K. Nail in E.-side 11" Maple	S 04° W(mag.)	28.55 Ft.

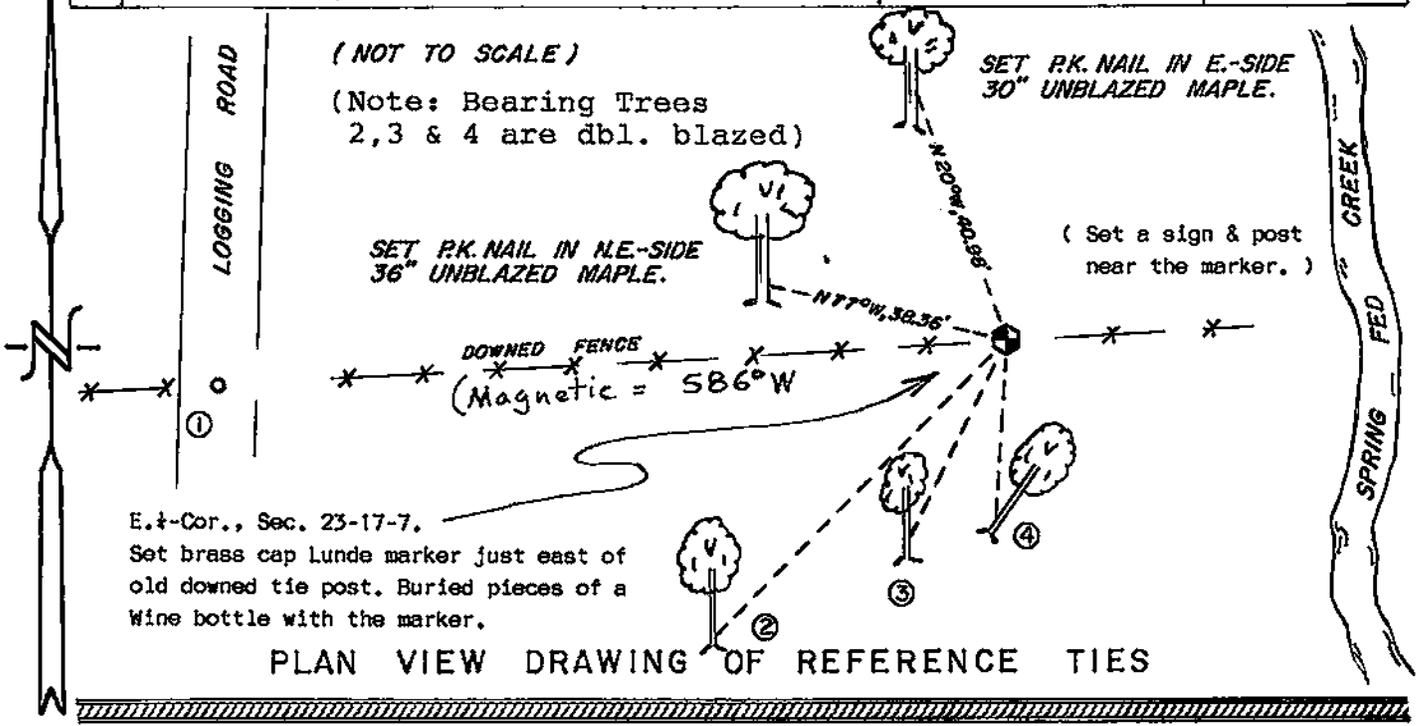


MAP SHOWING DISTANCE AND DIRECTION TO OTHER PUBLIC LAND SURVEY CORNERS USED FOR REESTABLISHING THE CORNER

(not to scale)

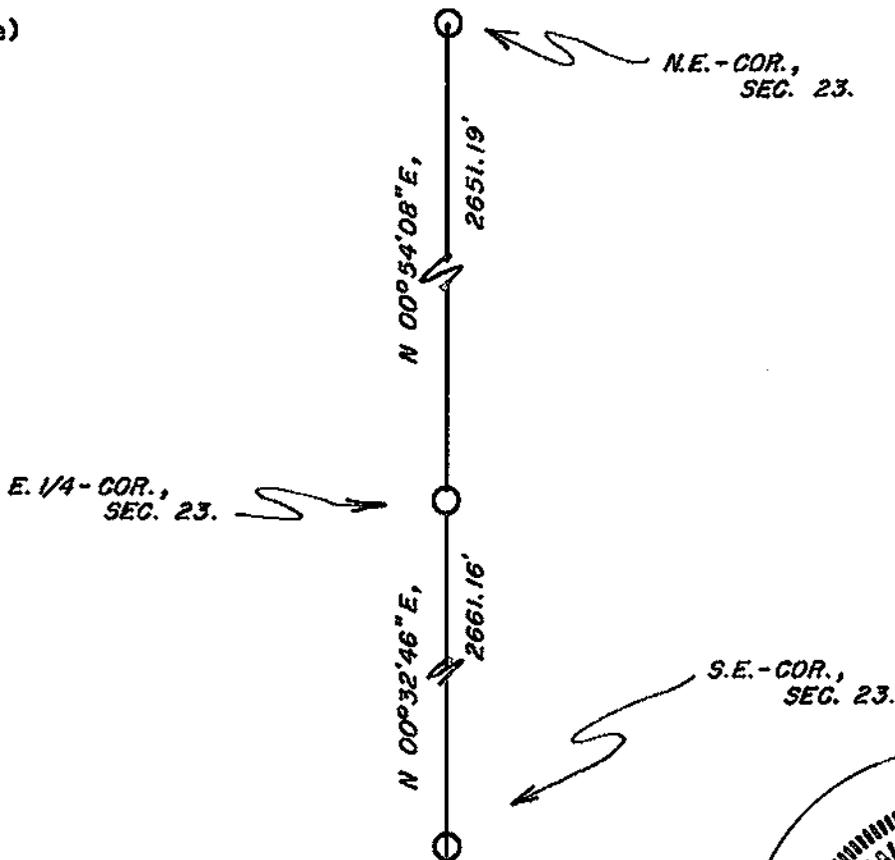

I, William C. Jung, County Surveyor
 HEREBY CERTIFY THAT THE CORNER LOCATION SHOWN ON THIS RECORD
 WAS DETERMINED BY ME OR UNDER MY DIRECTION AND CONTROL AND
 THAT THIS U. S. PUBLIC LAND SURVEY MONUMENT RECORD IS CORRECT
 AND COMPLETE TO THE BEST OF MY KNOWLEDGE AND BELIEF.

William C. Jung 1/6/97
 Signature Date

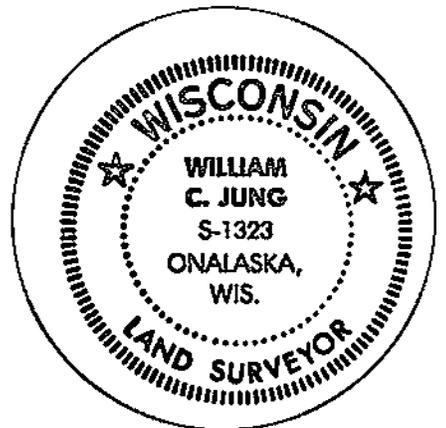

Seal