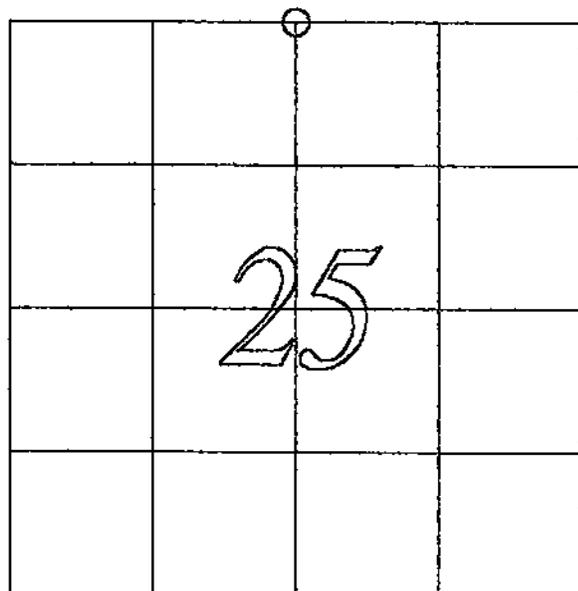


21707240020

U. S. PUBLIC LAND SURVEY MONUMENT RECORD

SECTION 25 T 17 N, R 7 W, TOWN OF HAMILTON
LA CROSSE COUNTY

LOCATION OF LANDMARK

CREW: CHRIS FECHNER

JOSH NAVE

JOHN UNBEHAUN: WITNESS

DATE: 07/18/2002

Describe any record evidence, monument evidence, testimonial evidence, or any other material evidence you considered and whether the monument was found or restored through acceptance of an obliterated evidence location.

Original bearing trees or stumps could not be determined due to logging. The northeast and northwest corners of Section 25 are existing but not tied together. The distance East from my North 1/4 corner is 26 feet longer than the Government Notes. However, the distance from the West is very good. My crew leader and I located the fence line North and South of the corner location and used it (continued)

Describe or show any material discrepancy between the location of the restored corner and that of the corner previously restored or reestablished.
None Known.

as the best available evidence. John Unbehaun(witness), a 32 year resident, agreed with the corner location and stated his predecessor told him the "old" corner location was within 3 feet of my corner location. The location of the northeast corner of Section 25 was somewhat questioned, however, it has been used in previous surveys and accepted as the correct location.

WISCONSIN COORDINATE SYSTEM

North

East

Theta Angle

Horiz. Order

Vert. Order


TYPE OF LANDMARK

3/4" X 30" IRON BAR

BEARINGS ARE REFERENCED TO
LA CROSSE COUNTY COORDINATES


RECORD OF DURABLE WITNESS MONUMENTS

NO	DESCRIPTION	BEARING	DISTANCE
1	MAG NAIL IN SINGLE BLAZE 6" HICKORY	N 10°20'50" E	6.84'
2	MAG NAIL IN 16" HICKORY	N 71°22'21" E	48.86'
3	MAG NAIL IN 24" RED OAK	S 17°09'01" W	9.62'
4	MAG NAIL IN SINGLE BLAZE 6" CHERRY	N 56°09'21" W	17.01'
⑤	CENTER OF 36" RED OAK	N 21°50' E	36'

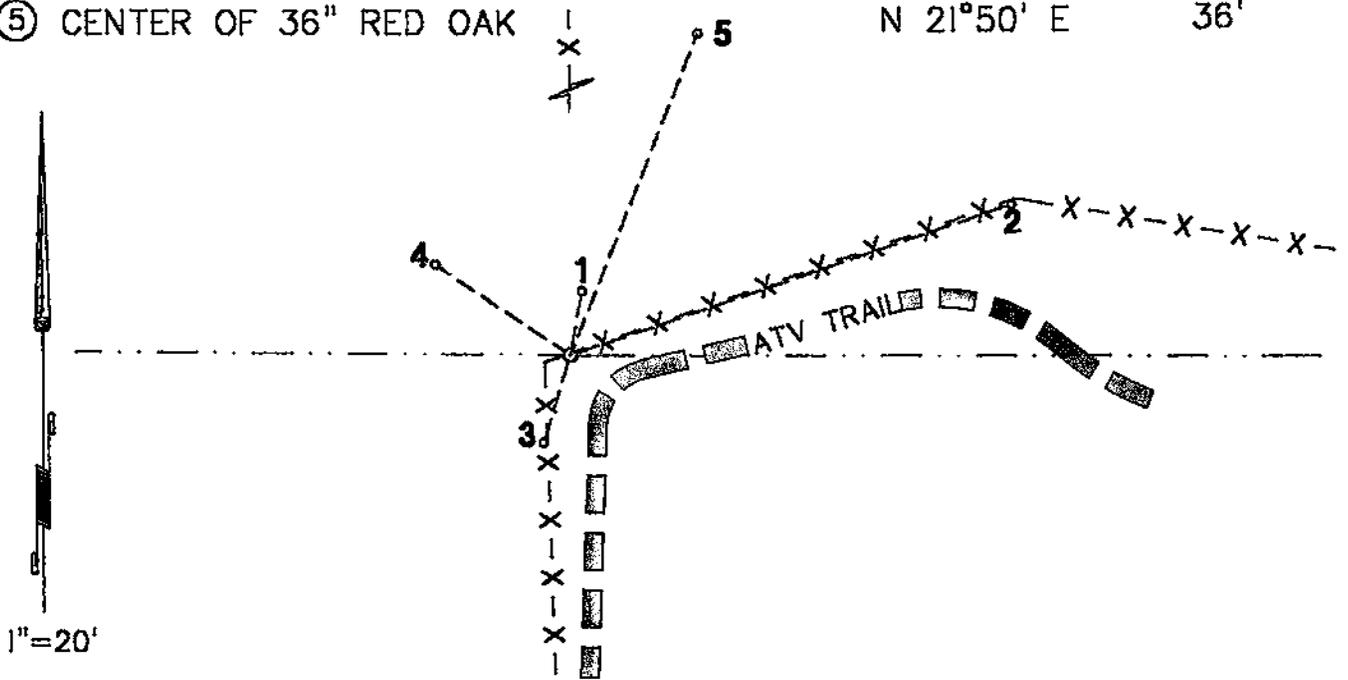

PLAN VIEW DRAWING OF REFERENCE TIES

MAP SHOWING DISTANCE AND DIRECTION TO OTHER PUBLIC LAND SURVEY CORNERS USED FOR REESTABLISHING THE CORNER

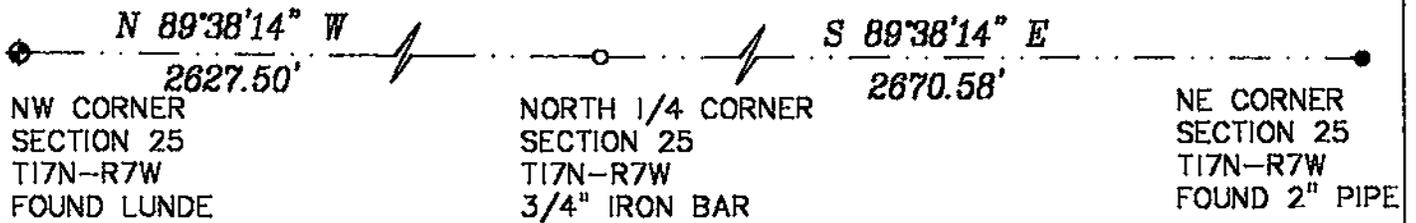

I, CHRISTOPHER W. FECHNER

HEREBY CERTIFY THAT THE CORNER LOCATION SHOWN ON THIS RECORD WAS DETERMINED BY ME OR UNDER MY DIRECTION AND CONTROL AND THAT THIS U. S. PUBLIC LAND SURVEY MONUMENT RECORD IS CORRECT AND COMPLETE TO THE BEST OF MY KNOWLEDGE AND BELIEF.



Christopher W. Fechner

Signature

7/27/02

Date

Seal