


21707250020

U. S. PUBLIC LAND SURVEY MONUMENT RECORD

SECTION 36 T 17 N, R 7 W, TOWN OF HAMILTON

LA CROSSE COUNTY

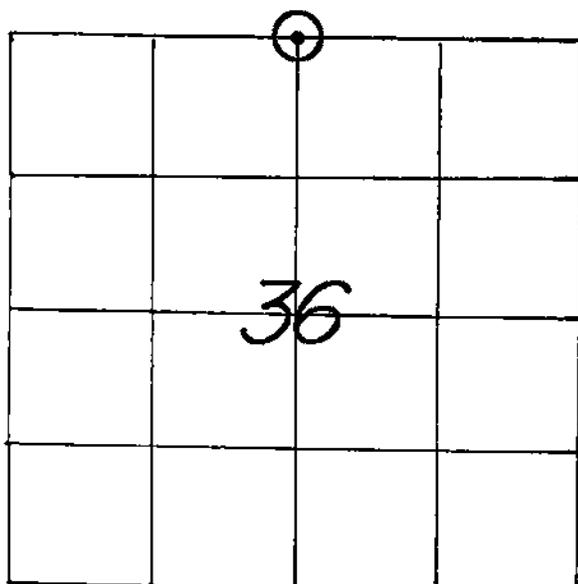

LOCATION OF LANDMARK

CREW: WILLIAM C. JUNG
 PETER F. FOLLANSBEE
 DATE: 7/19/2005

WISCONSIN COORDINATE SYSTEM

North

East

Theta Angle

Horiz. Order

Vert. Order

TYPE OF LANDMARK

3/4" IRON BAR WITH A RED PLASTIC CAP.

BEARINGS ARE REFERENCED TO

Describe any record evidence, monument evidence, testimonial evidence or any other material evidence you considered and whether the monument was found or restored through acceptance of an obliterated evidence location.

Mike Harding set an iron bar at this corner in 1998. I found and accepted this bar as the corner and took ties.

Describe or show any material discrepancy between the location of the restored corner and that of the corner previously restored or reestablished.

NONE KNOWN.

RECORD OF DURABLE WITNESS MONUMENTS

MAGNETIC

NO	DESCRIPTION	BEARING	DISTANCE
1	SET A NAIL IN S.-SIDE OF A 9-1/2" WHITE OAK	S 84° W	SLOPE = 23.82'
2	EX. MAG NAIL IN S.W.-FACE OF AN 8" HICKORY (UPI.7)	N 81° E	21.12 FT.
3	EX. MAG NAIL IN N.W.-FACE OF AN 11" W. OAK (UPI.5)	S 63° E	24.17 FT.
4	SET A NAIL IN N.W.-SIDE OF A 15-1/2" WHITE OAK	S 30° W	31.50 FT.

(NOTE: THE FOUR BEARING TREES ARE DOUBLE BLAZED.)

(NOTE: THIS 13" WHITE OAK LIES IMMEDIATELY NORTH OF THE IRON BAR.)

(W O O D S)

(W O O D S)


N. 1/4 - COR., SEC. 36-17-7.
 FOUND AN EXISTING 3/4" IRON BAR, UP 7",
 ON THE SOUTH EDGE OF A WHITE
 OAK. SET A RED PLASTIC CAP ON
 THE BAR AND SET A SIGN &
 POST TO THE SOUTH.

(W O O D S)

(NOT TO SCALE)

PLAN VIEW DRAWING OF REFERENCE TIES

MAP SHOWING DISTANCE AND DIRECTION TO OTHER PUBLIC LAND SURVEY CORNERS USED FOR REESTABLISHING THE CORNER

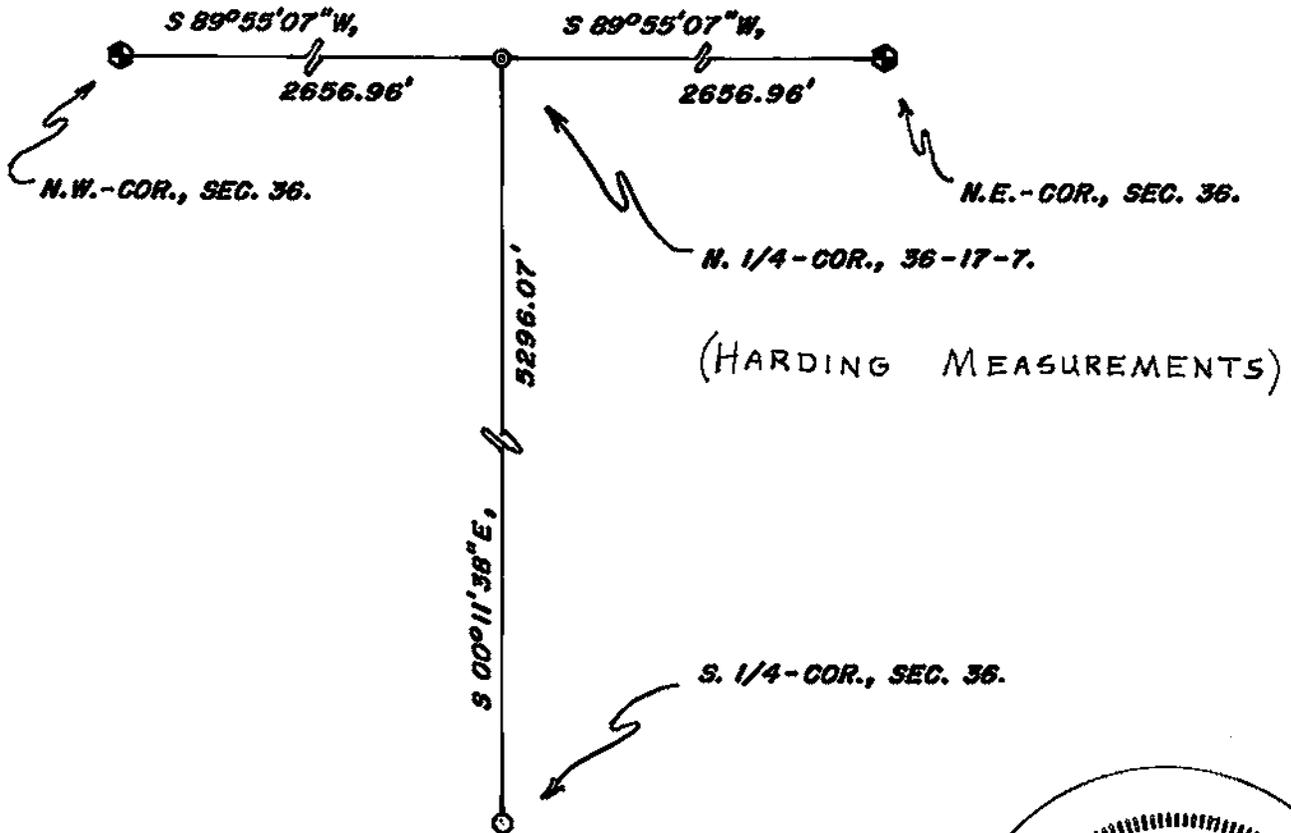


(HARDING MEASUREMENTS)

I, WILLIAM C. JUNG, COUNTY SURVEYOR
 HEREBY CERTIFY THAT THE CORNER LOCATION SHOWN ON THIS RECORD
 WAS DETERMINED BY ME OR UNDER MY DIRECTION AND CONTROL AND
 THAT THIS U. S. PUBLIC LAND SURVEY MONUMENT RECORD IS CORRECT
 AND COMPLETE TO THE BEST OF MY KNOWLEDGE AND BELIEF.

William C. Jung
 Signature

11/29/05
 Date

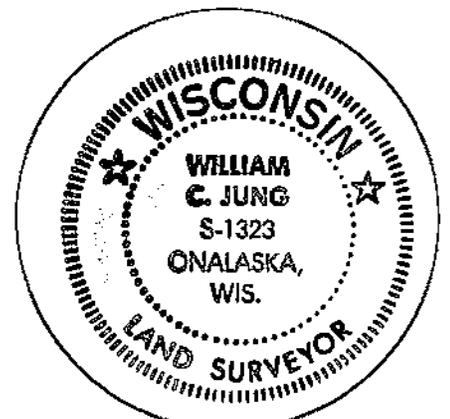

Seal