

21707260020

---


 U. S. PUBLIC LAND SURVEY MONUMENT RECORD
 

---

 SECTION 35 T 17 N, R 7 W, TOWN OF ONALASKA


---

LA CROSSE COUNTY

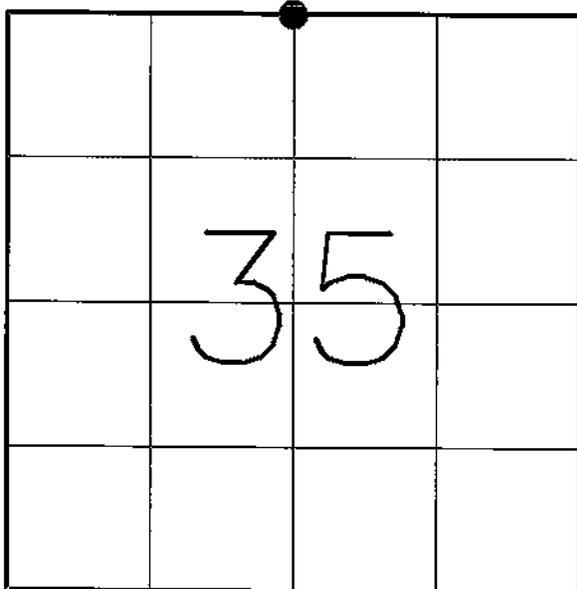

LOCATION OF LANDMARK

WISCONSIN COORDINATE SYSTEM
NORTH
EAST
THETA ANGLE
HORIZ. ORDER
VERT. ORDER
TYPE OF LANDMARK
BRASS CAP LUNDE MARKER
BEARINGS ARE REFERENCE TO LA CROSSE COUNTY COORDINATE SYSTEM

DESCRIBE ANY RECORDED EVIDENCE, MONUMENT EVIDENCE, TESTIMONIAL EVIDENCE OR ANY OTHER MATERIAL EVIDENCE YOU CONSIDERED AND WHETHER THE MONUMENT WAS FOUND OR RESTORED THROUGH ACCEPTANCE OF AN OBLITERATED EVIDENCE LOCATION.

JUNE 29, 1989

COUNTY SURVEYOR FOUND AN IRON PIPE SET BY R.D. WALTER AND ACCEPTED THE LOCATION, SET A BRASS CAPPED LUNDE MARKER.

JUNE 14, 1993

MARKER WAS DISTURBED BY CONSTRUCTION EQUIPMENT, COUNTY SURVEYOR REPLACED WITH A NEW LUNDE MARKER.

NOVEMBER 27, 2002


MARKER WAS DISTURBED BY CONSTRUCTION EQUIPMENT, I REPLACED EXISTING MARKER FROM TIES, INCLUDING THE RIGHT OF WAY IRONS FROM WALTER'S INNSBRUCK SURVEY.

DESCRIBE OR SHOW ANY MATERIAL DISCREPANCY BETWEEN THE LOCATION OF THE RESTORED CORNER AND THAT OF THE CORNER PREVIOUSLY RESTORED OR REESTABLISHED.

NONE KNOWN

**RECORD OF DURABLE WITNESS MONUMENT**

NO	DESCRIPTION	BEARING	DISTANCE
1	FOUND 1 1/4" I.P. W/CAP	S62°15'38"W	150.98
2	CORNER CONCRETE FOUNDATION	S30°59'26"E	69.03
3	CORNER CONCRETE FOUNDATION	N86°29'04"E	107.30
4	FOUND 1 1/4" I.P. W/CAP	N46°26'34"E	207.18
5	FOUND 1 1/4" I.P. W/CAP	N17°53'46"E	132.38

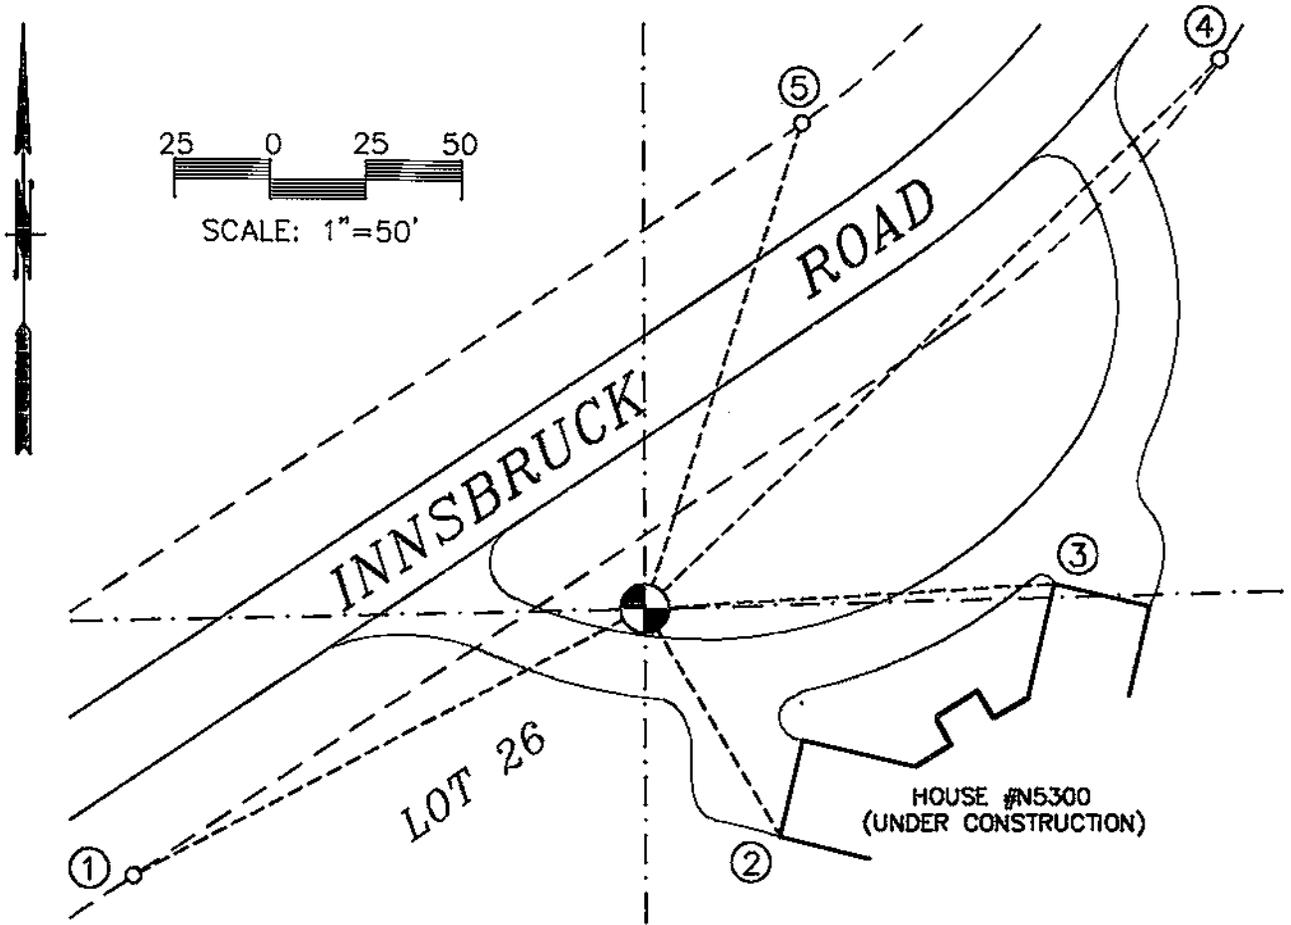

PLAN VIEW DRAWING OF REFERENCE TIES


MAP SHOWING DISTANCE AND DIRECTION TO OTHER PUBLIC LAND SURVEY CORNER USED FOR REESTABLISHING THE CORNER.

NO OTHER CORNERS MEASURED FOR THIS SURVEY.

I, PAUL E. FAIRCHILD  
 HEREBY CERTIFY THAT THE CORNER LOCATION SHOWN ON THIS RECORD  
 WAS DETERMINED BY ME OR UNDER MY DIRECTION AND CONTROL AND  
 THAT THIS U.S. PUBLIC LAND SURVEY MONUMENT IS CORRECT AND  
 COMPLETE TO THE BEST OF MY KNOWLEDGE AND BELIEF.

*Paul E. Fairchild*  
 SIGNATURE


12/31/02  
 DATE

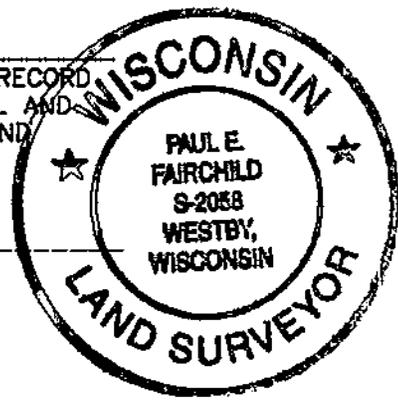

## U. S. PUBLIC LAND SURVEY MONUMENT RECORD

SECTION 35 T 17 N, R 7 W, TOWN OF Onalaska

## LA CROSSE COUNTY

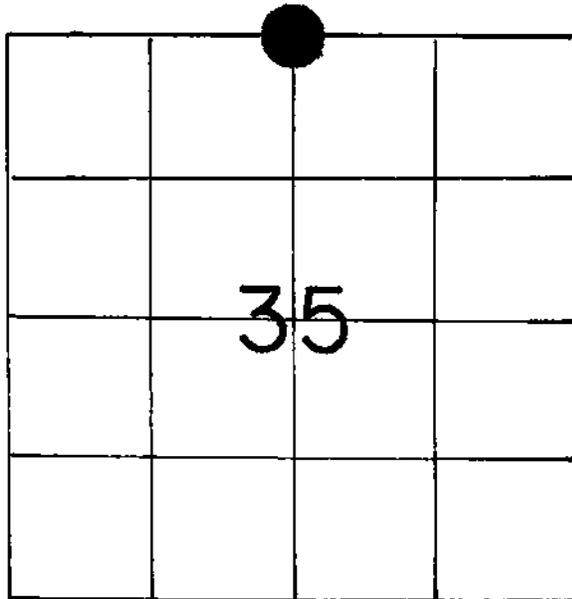

LOCATION OF LANDMARK

WISCONSIN COORDINATE SYSTEM

North

East

Theta Angle

Horiz. Order

Vert. Order

TYPE OF LANDMARK

BRASS CAP LUNDE MARKER

BEARINGS ARE REFERENCED TO

Assumed North

Crew: WILLIAM C. JUNG  
PETER F. FOLLANSBEECrew: William C. Jung Crew: William C. Jung  
Peter F. Follansbee

Date: 6/29/1989

Date: 6/14/93

Date: 8/4/93

Describe any record evidence, monument evidence, testimonial evidence or any other material evidence you considered and whether the monument was found or restored through acceptance of an obliterated evidence location.

I accepted Walter's pipe as the corner and replaced it with a brass capped Lunde marker.

(See attached R.D. Walter notes.)


On June 14, 1993, I found that the fence post was bent, the bottle was broken, and the marker was broken by construction equipment. I set a new Lunde marker and sign and post. I buried the old marker with the new.

Describe or show any material discrepancy between the location of the restored corner and that of the corner previously restored or reestablished.

NONE KNOWN

RECORD OF DURABLE WITNESS MONUMENTS  
MAGNETIC


NO	DESCRIPTION	BEARING	DISTANCE	
1	F'nd 1 1/4" I.P. w/ "R.D. Walter" cap	S 63° W	<del>150.87</del> Ft.	150.96
2	Set P.K. Nail in 7" unblazed Norway	S 09° W	<del>80.80</del> Ft.	80.90
3	Set P.K. Nail in 9" unblazed Norway	S 44° E	<del>60.90</del> Ft.	60.96
4	F'nd 1 1/4" I.P. w/ "R.D. Walter" cap	N 47° E	<del>207.10</del> Ft.	207.08

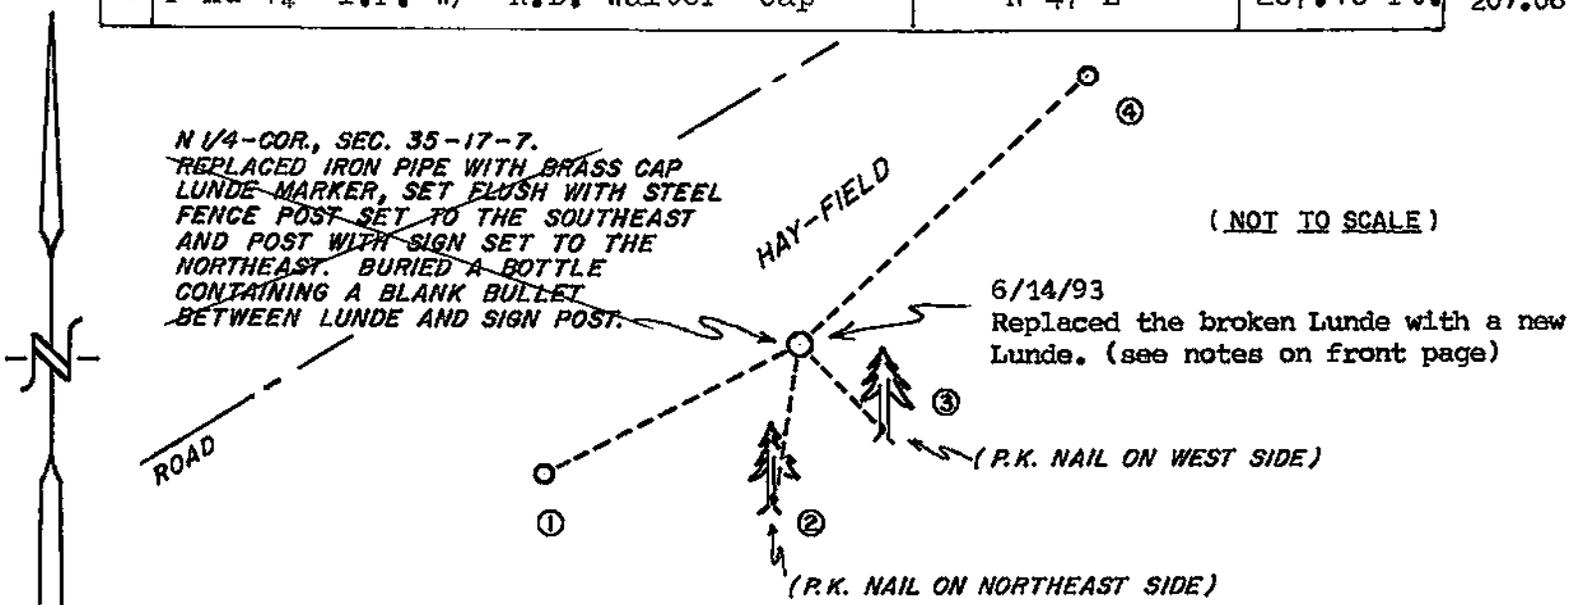

PLAN VIEW DRAWING OF REFERENCE TIES

MAP SHOWING DISTANCE AND DIRECTION TO OTHER PUBLIC LAND SURVEY CORNERS USED FOR REESTABLISHING THE CORNER

(not to scale)

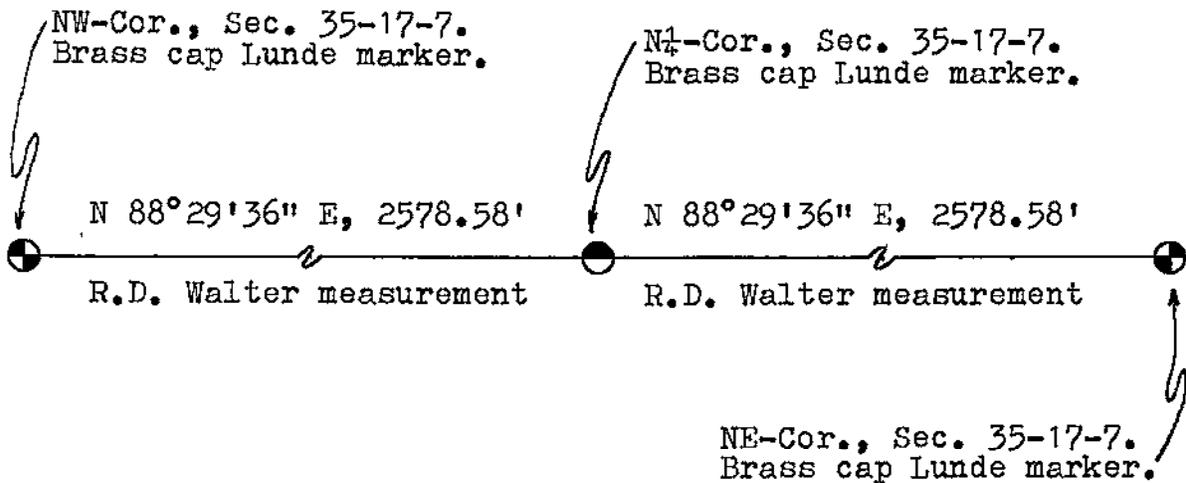

I, William C. Jung, Deputy County Surveyor  
 HEREBY CERTIFY THAT THE CORNER LOCATION SHOWN ON THIS RECORD  
 WAS DETERMINED BY ME OR UNDER MY DIRECTION AND CONTROL AND  
 THAT THIS U. S. PUBLIC LAND SURVEY MONUMENT RECORD IS CORRECT  
 AND COMPLETE TO THE BEST OF MY KNOWLEDGE AND BELIEF.

*William C. Jung*  
 Signature

December 21, 1989  
 Date

Revised: January 18, 1994



Seal

WALTER LAND SURVEYS

7-2/01

NORTH  $\frac{1}{4}$  CORNER SECTION 35, T17N, R7W.

Gov't Survey set  $\frac{1}{4}$  SECTION CORNER  
with the following BEARING TREES  
MARKED:

16" W. OAK N32°E 137 links (90.42')

18" W. OAK S16°W 78 links (51.48')

April  
988

After a thorough SEARCH of the County  
RECORDS I FOUND NO INFORMATION  
CONCERNING this CORNER.

RICHARD D. WALTER R.L.S. traversed to  
the area of the corner and found NO  
ORIGINAL corner or any BEARING TREE  
EVIDENCE. We found NO other SURVEY  
MONUMENTATION or any OCCUPATION LINES.

Computed Lost position (Single Proportional  
measurement) and found  $\frac{1}{4}$   
corner to be 2578.58 feet from the  
Northwest and Northeast corners of  
SECTION 35-17-7. GLO calls 39.62  $\frac{1}{2}$  chains  
from  $\frac{1}{4}$  corner to SECTION CORNER.

Accept Lost position as best evidence  
of corner.

I set a 1  $\frac{1}{4}$ " pipe as location of the  
 $\frac{1}{4}$  corner.