


U. S. PUBLIC LAND SURVEY MONUMENT RECORD

SECTION 26 T 17 N, R 7 W, TOWN OF Hamilton

LA CROSSE COUNTY

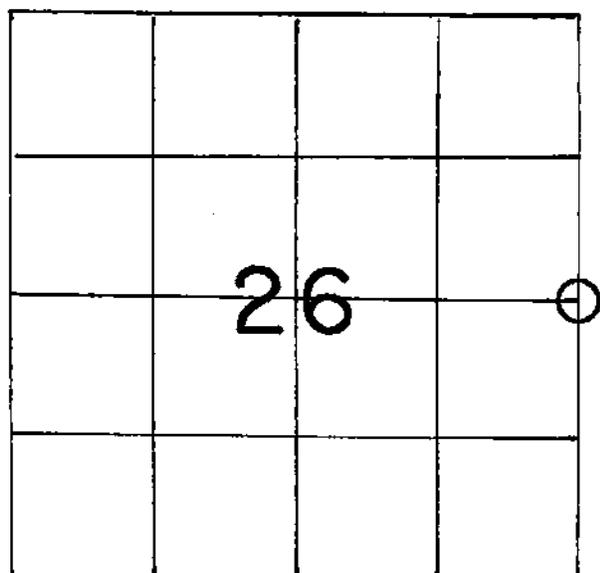

LOCATION OF LANDMARK

Crew: WILLIAM C. JUNG
PETER F. FOLLANSBEE

Date: 8/04/1993

Describe any record evidence, monument evidence, testimonial evidence or any other material evidence you considered and whether the monument was found or restored through acceptance of an obliterated evidence location.

I found an iron pipe used in previous surveys and made further ties for the corner as Wil Clark, RLS, thought that the pipe had been disturbed.

(I plumbed up the existing pipe.)

Describe or show any material discrepancy between the location of the restored corner and that of the corner previously restored or reestablished.

None Known

WISCONSIN COORDINATE SYSTEM

North

East

Theta Angle

Horiz. Order

Vert. Order


TYPE OF LANDMARK

Existing 1" Iron Pipe

BEARINGS ARE REFERENCED TO

RECORD OF DURABLE WITNESS MONUMENTS
MAGNETIC

| NO | DESCRIPTION | BEARING | DISTANCE |
|----|---|---------|---------------|
| 1 | Exist. Spike in side of south gate-post | S 61°W | 14.80 Ft. |
| 2 | Set P.K. Nail in W.-side 14" Hackberry | N 18°E | 5.23 Ft. |
| 3 | Set P.K. Nail in NW-side 17" White Oak | N 45°E | Sl.=28.26 Ft. |
| 4 | Set P.K. Nail in SW-side 6" Aspen | S 42°E | Sl.=44.19 Ft. |

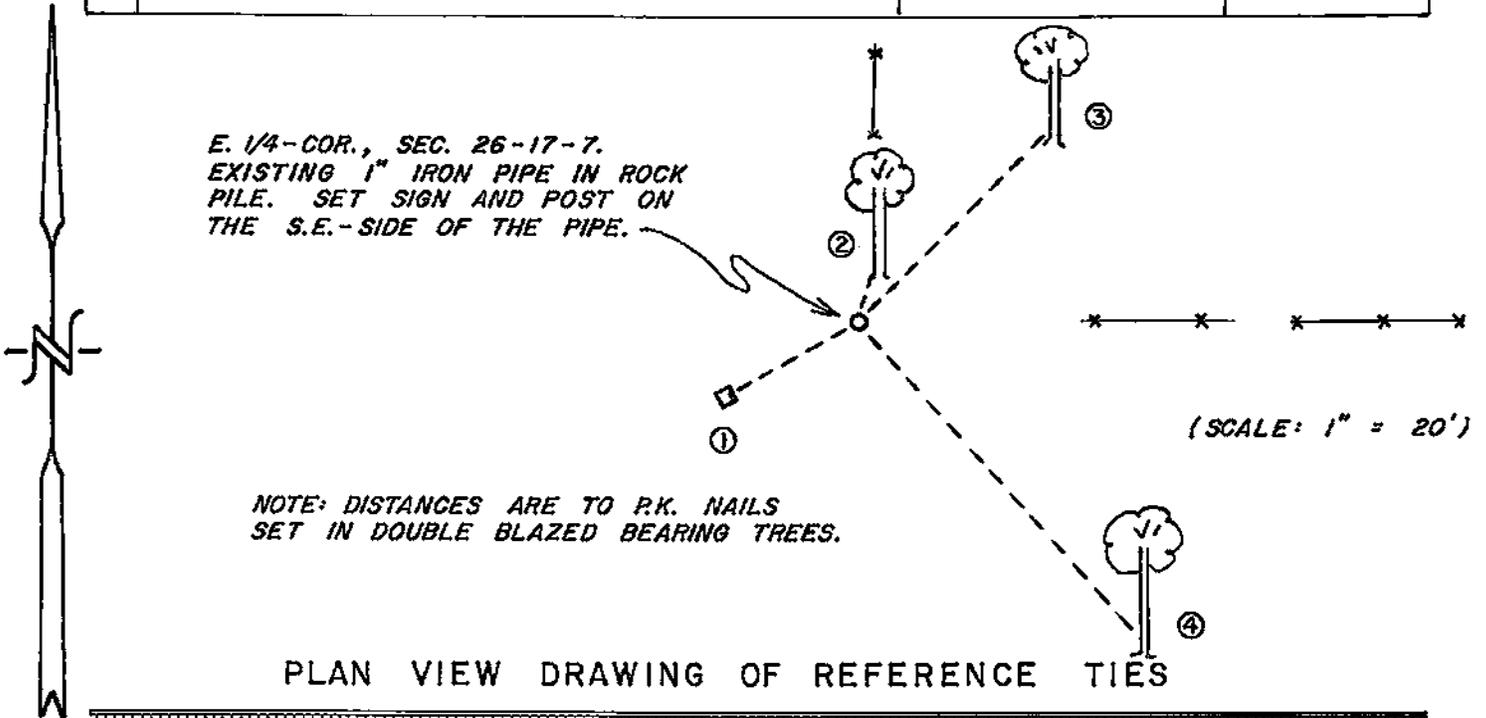

MAP SHOWING DISTANCE AND DIRECTION TO OTHER PUBLIC LAND SURVEY CORNERS USED FOR REESTABLISHING THE CORNER

No section measurements made by me at this time. Position confirmed by previous survey measurement.

I, William C. Jung, County Surveyor
HEREBY CERTIFY THAT THE CORNER LOCATION SHOWN ON THIS RECORD
WAS DETERMINED BY ME OR UNDER MY DIRECTION AND CONTROL AND
THAT THIS U. S. PUBLIC LAND SURVEY MONUMENT RECORD IS CORRECT
AND COMPLETE TO THE BEST OF MY KNOWLEDGE AND BELIEF.

William C. Jung
Signature


1/18/94
Date



U. S. PUBLIC LAND SURVEY MONUMENT RECORD

SECTION 25 T 17 N, R 7 W, TOWN OF HAMILTON

LA CROSSE COUNTY

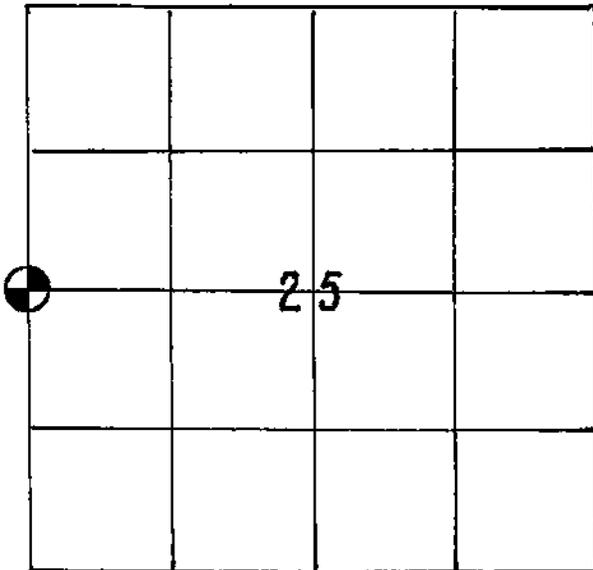

LOCATION OF LANDMARK

WISCONSIN COORDINATE SYSTEM

North N/A

East

Theta Angle

Horiz. Order

Vert. Order

TYPE OF LANDMARK

1" Iron Pipe Set

BEARINGS ARE REFERENCED TO

East line of Section 25
Recorded as $N00^{\circ}08'52''E$

Describe any record evidence, monument evidence, testimonial evidence or any other material evidence you considered and whether the monument was found or restored through acceptance of an obliterated evidence location.


At the intersection of two obliterated fencelines was found a pile of stones. This was the location described to me by Carl Lee, owner of the S.W. $\frac{1}{4}$ -N.W. $\frac{1}{4}$, believed to be in his 80's. Buried among the pile of stones an iron blade appx. 10" long with a hole in it was found. This blade was very rusted from age.

Describe or show any material discrepancy between the location of the restored corner and that of the corner previously restored or reestablished.

None known

RECORD OF DURABLE WITNESS MONUMENTS


| NO | DESCRIPTION | BEARING | DISTANCE |
|----|---------------------------------|---------|----------|
| 1 | Spike in 14" Hackberry Tree | N 7°E | 4.45' |
| 2 | Spike in 20" White Oak | N 47°E | 27.60' |
| 3 | Spike in 8" x 8" Wood Gate Post | S 78°W | 14.85' |
| 4 | | | |

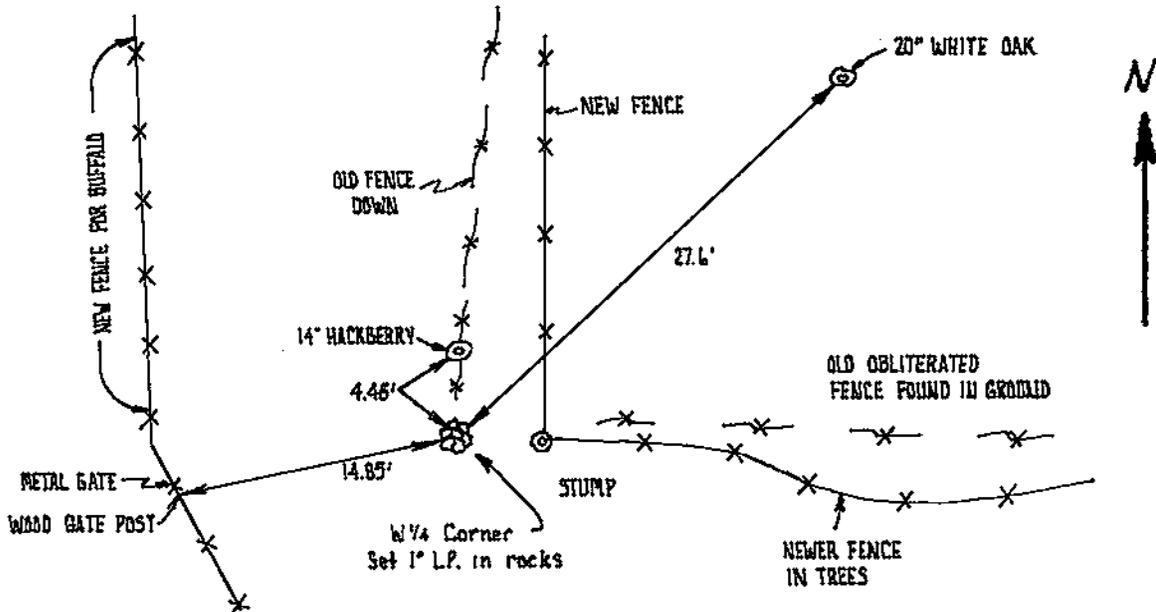

PLAN VIEW DRAWING OF REFERENCE TIES




MAP SHOWING DISTANCE AND DIRECTION TO OTHER PUBLIC LAND SURVEY CORNERS USED FOR REESTABLISHING THE CORNER

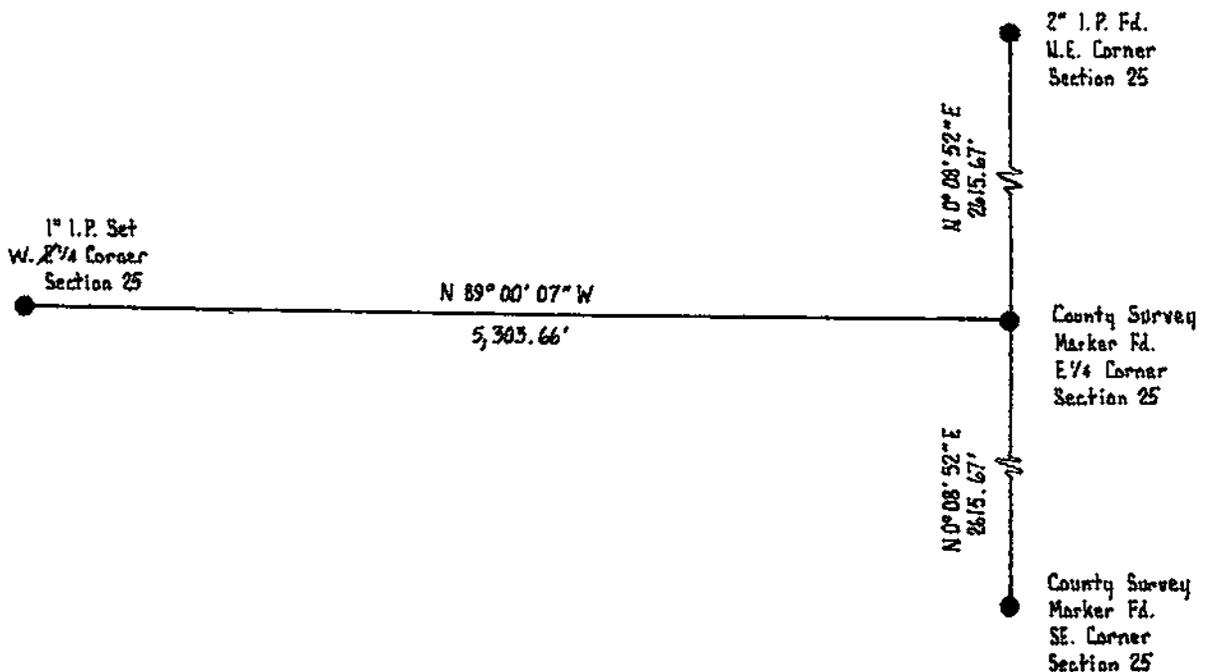

I, RODNEY H. MAXWELL
 HEREBY CERTIFY THAT THE CORNER LOCATION SHOWN ON THIS RECORD
 WAS DETERMINED BY ME OR UNDER MY DIRECTION AND CONTROL AND
 THAT THIS U. S. PUBLIC LAND SURVEY MONUMENT RECORD IS CORRECT
 AND COMPLETE TO THE BEST OF MY KNOWLEDGE AND BELIEF.

Rodney H. Maxwell 11/4/87
 Signature Date

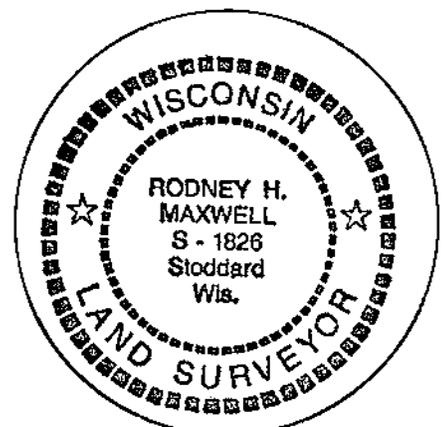

Seal