


21707280000

U. S. PUBLIC LAND SURVEY MONUMENT RECORD

SECTION 28 T 17 N, R 7 W, TOWN OF Onalaska

LA CROSSE COUNTY

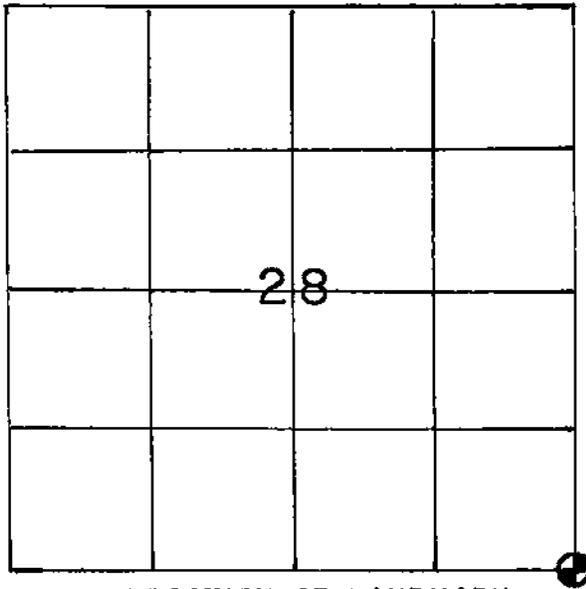

LOCATION OF LANDMARK

CREW: Bill Jung, Perry Dahl
 DATE: 5-6-87

WISCONSIN COORDINATE SYSTEM

North

East

Theta Angle

Horiz. Order

Vert. Order

TYPE OF LANDMARK

2 1/2" Iron Pipe

BEARINGS ARE REFERENCED TO

True (as per Solberg survey)

Describe any record evidence, monument evidence, testimonial evidence or any other material evidence you considered and whether the monument was found or restored through acceptance of an obliterated evidence location.


Greg Hofmeister set an iron pipe at the corner in 1981. He set the corner so as to fit the corner tie for the John Bosshard Addition. This location has also been used as the corner in other surveys and fits the evidence along the South line of the SE1/4 of Section 28 very well. I accepted this pipe as the best available evidence of the original government corner position.

Describe or show any material discrepancy between the location of the restored corner and that of the corner previously restored or reestablished.

None known.

RECORD OF DURABLE WITNESS MONUMENTS
MAGNETIC


| NO | DESCRIPTION | BEARING | DISTANCE |
|----|------------------------------------|---------|----------|
| 1 | Center of telephone box | N14°E | 66.17 |
| 2 | Chiselled "X" on concrete culvert | N23°W | 90.40 |
| 3 | P.K.nail in double blazed 5" oak | S19°W | 56.72 |
| 4 | P.K.nail in double blazed 4" aspen | S 5°E | 49.95 |

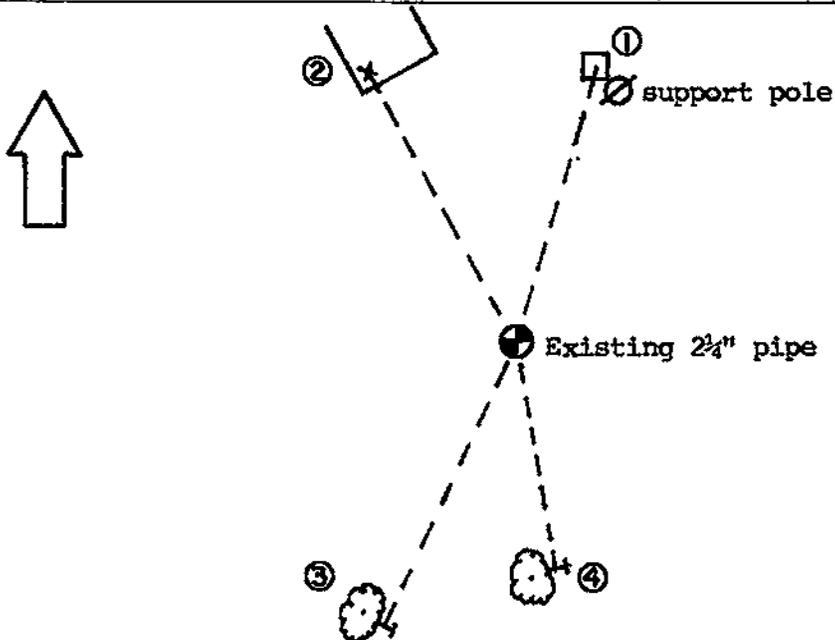

PLAN VIEW DRAWING OF REFERENCE TIES

MAP SHOWING DISTANCE AND DIRECTION TO OTHER PUBLIC LAND SURVEY CORNERS USED FOR REESTABLISHING THE CORNER

(not to scale)

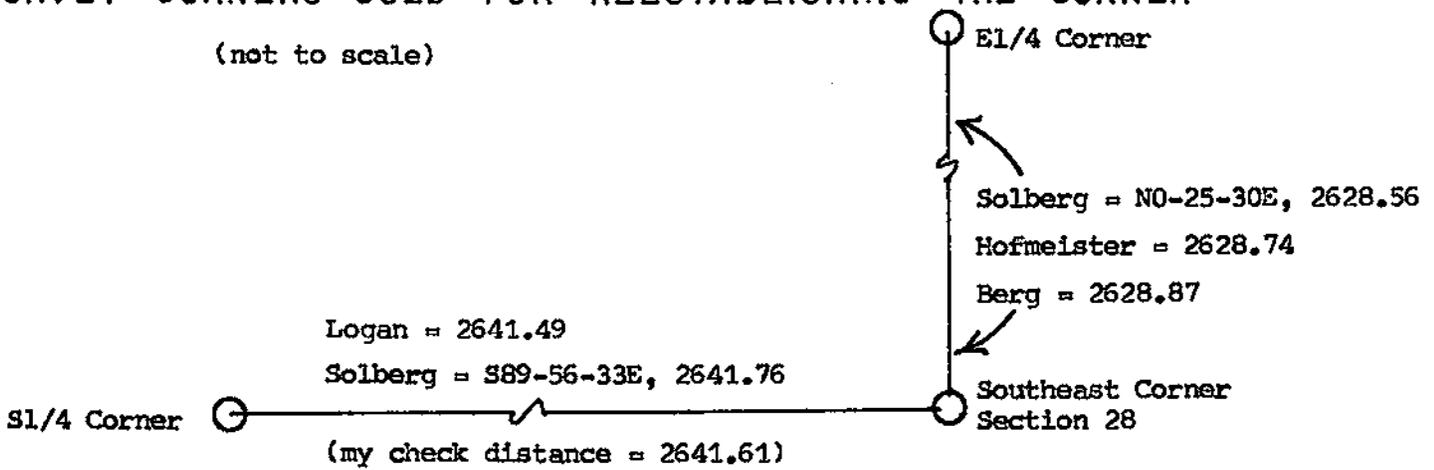


I, William C. Jung, Deputy County Surveyor,
HEREBY CERTIFY THAT THE CORNER LOCATION SHOWN ON THIS RECORD
WAS DETERMINED BY ME OR UNDER MY DIRECTION AND CONTROL AND
THAT THIS U. S. PUBLIC LAND SURVEY MONUMENT RECORD IS CORRECT
AND COMPLETE TO THE BEST OF MY KNOWLEDGE AND BELIEF.

William C. Jung
Signature

June 30, 1987

Date

Revised: December 30, 1987

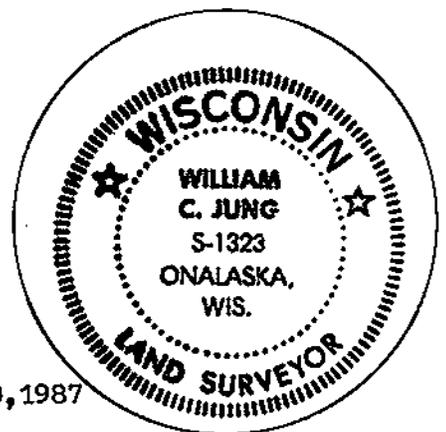

Seal