


U. S. PUBLIC LAND SURVEY MONUMENT RECORD

SECTION 28 T 17 N, R 7 W, ~~TOWN OF~~ CITY OF ONALASKA
 LA CROSSE COUNTY

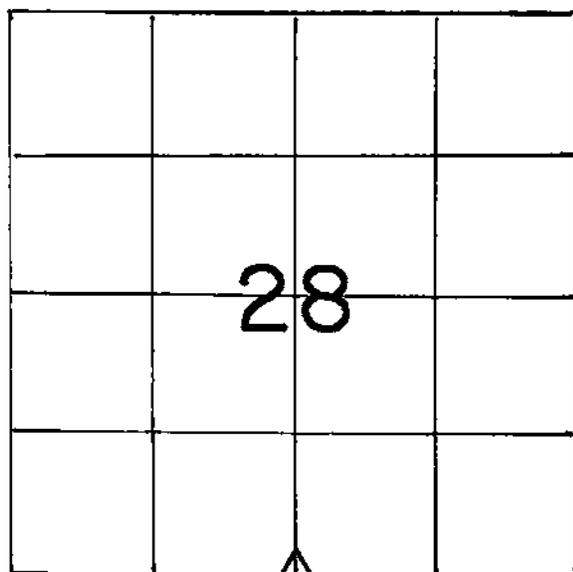

LOCATION OF LANDMARK

WISCONSIN COORDINATE SYSTEM
North
East
Theta Angle
Horiz. Order
Vert. Order
TYPE OF LANDMARK
Set Railroad Spike.
BEARINGS ARE REFERENCED TO

Crew: WILLIAM C. JUNG
 PETER F. FOLLANSBEE
 Date: 11/17/1994

Describe any record evidence, monument evidence, testimonial evidence or any other material evidence you considered and whether the monument was found or restored through acceptance of an obliterated evidence location.


I had set this corner in previous survey work. It was lost during construction. I reset this corner with a railroad spike.

Describe or show any material discrepancy between the location of the restored corner and that of the corner previously restored or reestablished.

None known.

RECORD OF DURABLE WITNESS MONUMENTS

NO	DESCRIPTION	BEARING	DISTANCE
1	Existing 1" Iron Pipe in fence	West \pm	44.68 Ft.
2	SE-Corner of block house foundation	Northwesterly \pm	132.13 Ft.
3	Center of top nut of hydrant	Northwesterly \pm	31.77 Ft.
4	Existing P.K. Nail in base of Power Pole	Southwesterly \pm	41.34 Ft.

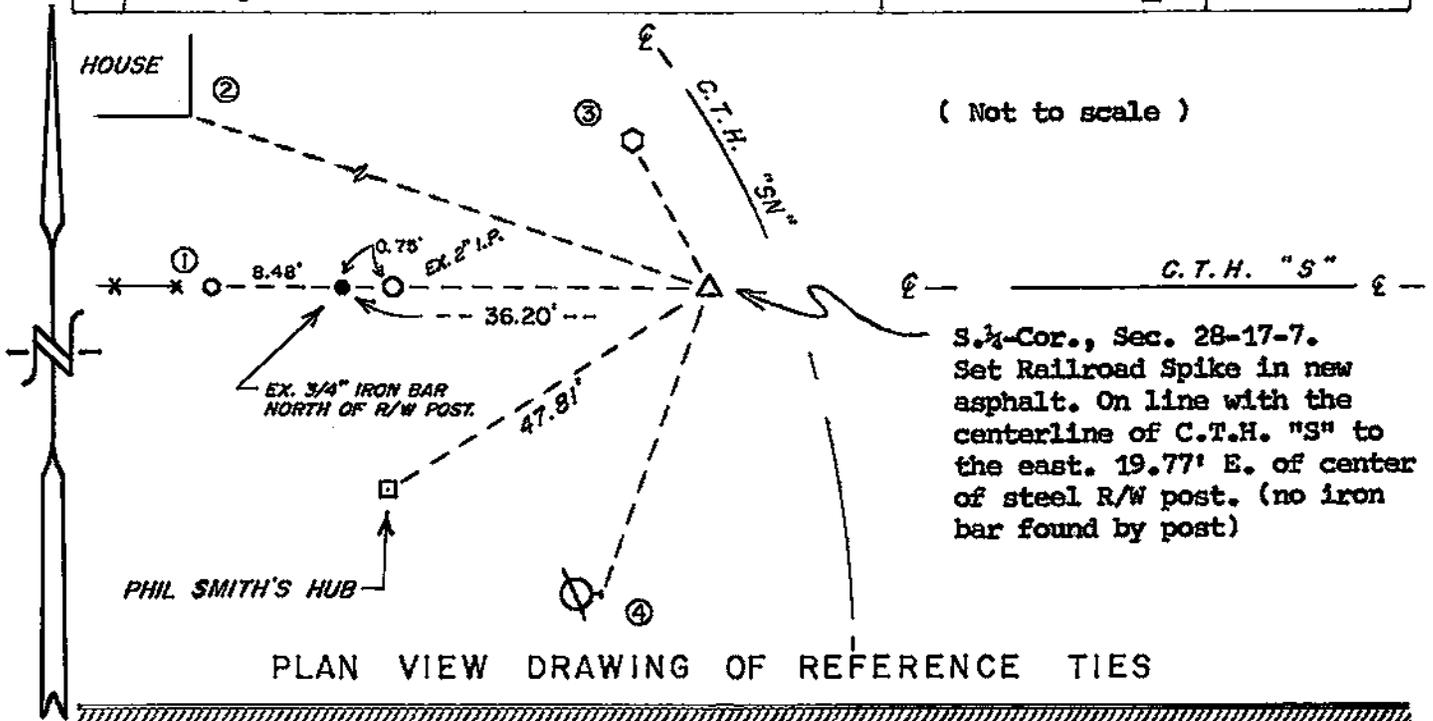


MAP SHOWING DISTANCE AND DIRECTION TO OTHER PUBLIC LAND SURVEY CORNERS USED FOR REESTABLISHING THE CORNER

No section measurements were made by me at this time. The position of this corner was confirmed by previous survey work.

I, William C. Jung, County Surveyor
 HEREBY CERTIFY THAT THE CORNER LOCATION SHOWN ON THIS RECORD WAS DETERMINED BY ME OR UNDER MY DIRECTION AND CONTROL AND THAT THIS U. S. PUBLIC LAND SURVEY MONUMENT RECORD IS CORRECT AND COMPLETE TO THE BEST OF MY KNOWLEDGE AND BELIEF.

William C. Jung 3/6/95
 Signature Date

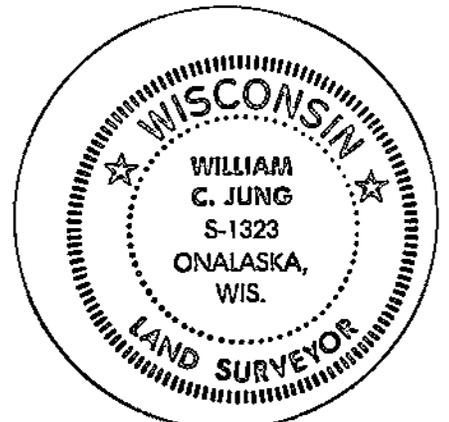


Seal

U. S. PUBLIC LAND SURVEY MONUMENT RECORD

SECTION 28 T 17 N, R 7 W, TOWN OF ONALASKA

LA CROSSE COUNTY

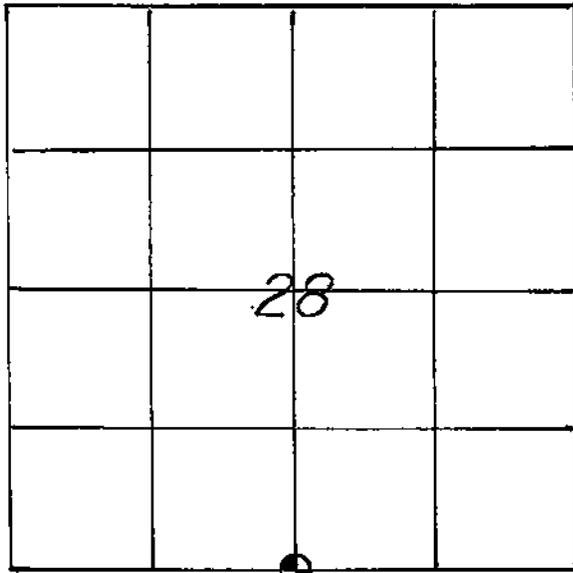

LOCATION OF LANDMARK

CREW: BILL JUNG, PERRY DAHL
DATE: 5-6-87

WISCONSIN COORDINATE SYSTEM
North
East
Theta Angle
Horiz. Order
Vert. Order

TYPE OF LANDMARK
~~SET LUNDE MARKER, DOWN 3', WITH 2" I.D. X~~
~~30" IR ON TOP OF IT, FLUSH WITH GROUND~~
 BEARINGS ARE REFERENCED TO
 True (as per Solberg survey)

Crew: William C. Jung
 Peter F. Follansbee
 Date: 5-17-89 and 7-9-90

Describe any record evidence, monument evidence, testimonial evidence or any other material evidence you considered and whether the monument was found or restored through acceptance of an obliterated evidence location.

I accepted the occupied corner as the best available evidence of the original government corner position. This location lines up with the old line fence to the North, the old line fence to the West, and the road centerline to the East. This location also fits the existing surveys, occupation, and field evidence along the South line of the SE1/4 of Section 28. The old North-South line fence and occupied corner at the S1/16SE Corner fits the final 1/2 mile almost perfectly. Ray Pelishek (County Surveyor), Derald Kading (Chief Surveyor of the local D.O.T. district), and Steve Solberg, RLS, all agree with this corner location. I set a brass capped Lunde marker, down 3', with a 2" I.D. x 30" iron pipe over it. Describe or show any material discrepancy between the location of the restored corner and that of the corner previously restored or reestablished.

I do not agree with the corner location as shown by Westbrook Associates, Inc., on the proposed right-of-way plat for C.T.H. "SN", Project No. 7067-01-21.

Note: December 30, 1987


Westbrook Associates, Inc., has since revised the plat for "SN". They have accepted my corner as being correct.

Note: On May 17, 1989, we removed the Lunde because of pending construction. We also removed the pipe. Wilhite said that a pipe was dug up from this area while they were excavating a trench. On July 9, 1990, we reset the Lunde marker and also set a post with sign to the South.

VOID

RECORD OF DURABLE WITNESS MONUMENTS

NO	DESCRIPTION	BEARING	DISTANCE
1	SOUTHEAST CORNER OF HOUSE	N54°W (magnetic)	132.09 131.91
2	IRON PIPE (for reference only)	WEST ±	44.67'
3	NORTHEAST CORNER OF ELECTRIC BOX (5'x5')	WEST ±	11.95'
4	CENTER OF TELEPHONE BOX BY POLE	S2°W (magnetic)	55.85 55.5

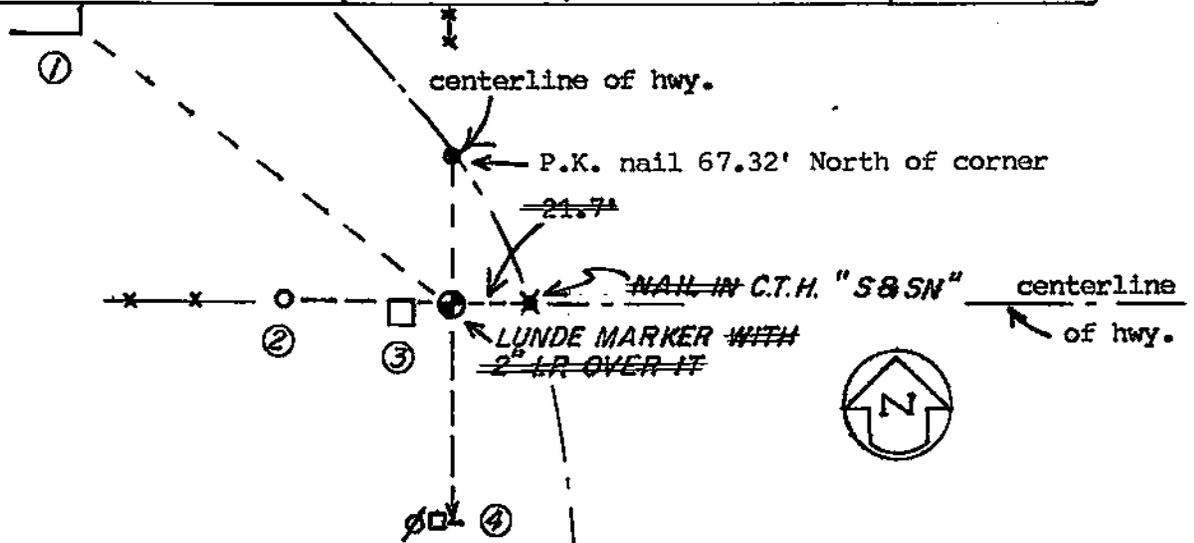


(not to scale)

PLAN VIEW DRAWING OF REFERENCE TIES

MAP SHOWING DISTANCE AND DIRECTION TO OTHER PUBLIC LAND SURVEY CORNERS USED FOR REESTABLISHING THE CORNER

(not to scale)

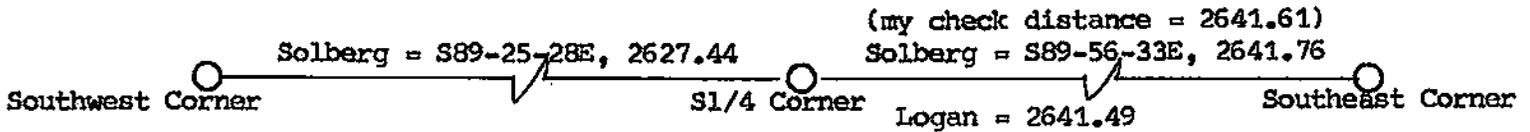


I, William C. Jung, Deputy County Surveyor,
 HEREBY CERTIFY THAT THE CORNER LOCATION SHOWN ON THIS RECORD
 WAS DETERMINED BY ME OR UNDER MY DIRECTION AND CONTROL AND
 THAT THIS U. S. PUBLIC LAND SURVEY MONUMENT RECORD IS CORRECT
 AND COMPLETE TO THE BEST OF MY KNOWLEDGE AND BELIEF.

William C. Jung
 Signature

June 30, 1987
 Date

Revised: February 14, 1991
W.C.J.

December 30, 1987
 (Revised)

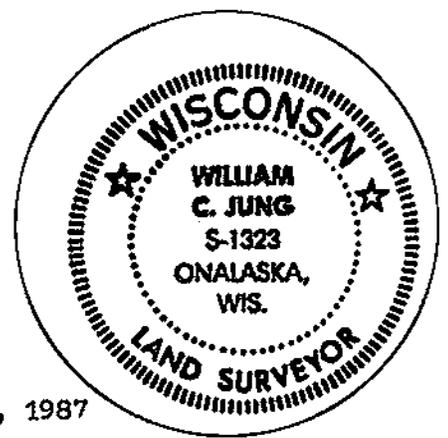

Seal

U.S. PUBLIC LAND SURVEY MONUMENT RECORD


INSTRUCTIONS:

This record shall show the location of the corner and shall include all of the following nine elements (a through i).

- (a) Identify the corner by reference to the U.S. public land survey system.

☉ = Corner monument restored.

North Quarter Corner
Section 33, Township 17N,
Range 07W, La Crosse County,
Wisconsin.

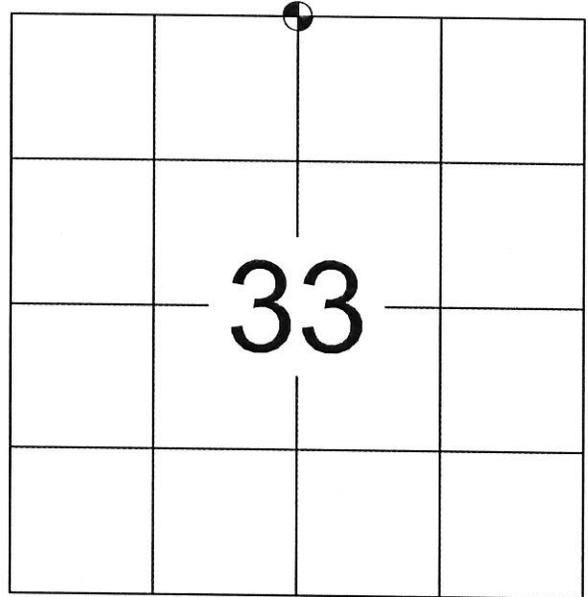


- (b) Describe any record evidence, monument evidence, occupation evidence, testimonial evidence, or any other material evidence that was considered, and whether the monument was found or placed.


A MAGNETIC SEARCH WAS PERFORMED AND FOUND RAIL ROAD SPIKE IN COUNTY TRUNK HIGHWAY SN. ALSO, LOCATED 3 OF THE 4 WITNESS MONUMENT. REPLACED THE LAST WITNESS MONUMENT WITH 0.75" O.D IRON REBAR.

- (c) In the plan view drawing below, provide reference ties to at least 4 witness monuments, or, if the location is within a municipality, to at least 2 witness monuments. (Witness monuments shall be made of concrete, natural stone, iron or other equally durable material.) Describe witness monuments.

- (d) Show a plan view drawing depicting the relevant monuments and reference ties which is sufficient in detail to enable accurate relocation of the corner monument if the corner monument is disturbed. Indicate north.

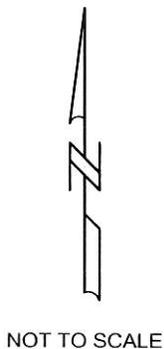

- FND 1.0" O.D. IP
- SET 0.75" O.D. IR
- ☉ FOUND RR SPIKE

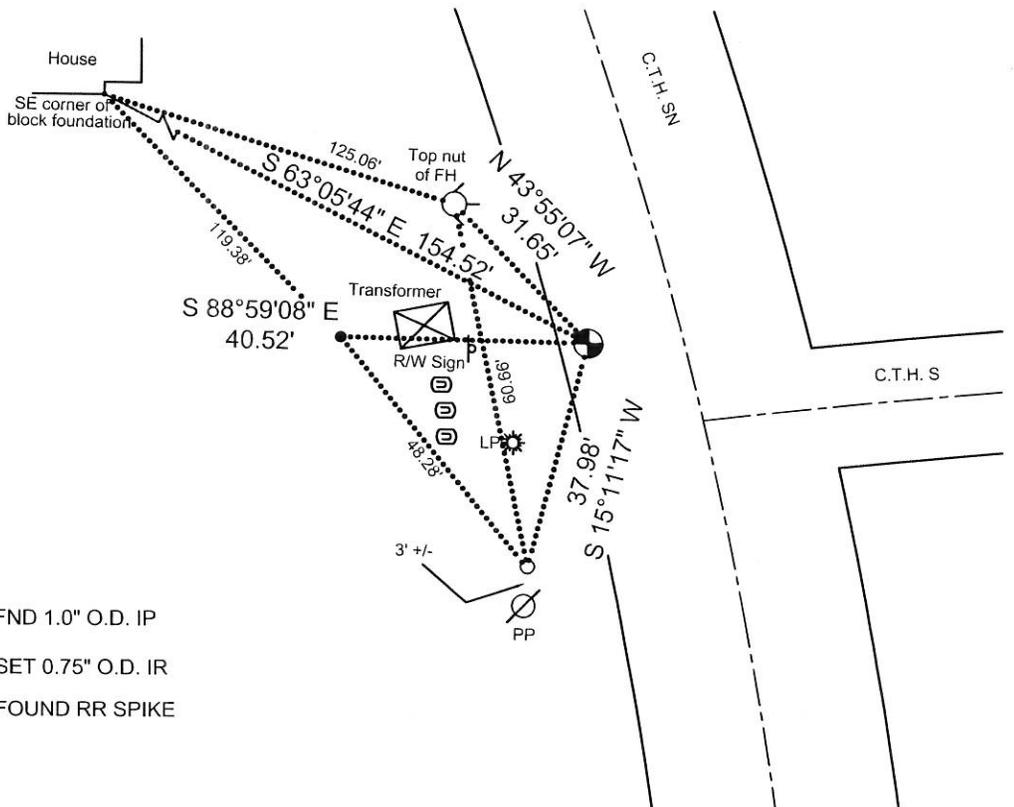

(e) Describe any material discrepancy between the location of the corner as restored or reestablished and the location of that corner as previously restored or reestablished by distance and direction. Show the discrepancy on the plan view drawing under (d), above. Show the distances between the corner as previously restored or reestablished and (1) the corner as restored or reestablished, and (2) to at least 2 of the witness monuments shown on the drawing in (d), above.

NO DISCREPANCIES WERE FOUND.

(f) Was the corner restored through acceptance of (1) an obliterated evidence location, or , (2) a found perpetuated location?

FOUND PERPETUATED LOCATION.

(g&h) Was the corner reestablished through lost corner proportionate methods? If so, show the method including the directions and distances the other public land survey corners used as evidence or as evidence or used for proportioning in determining the corner location?

NO.

(i) I, Brandon W. King S-2632
(type or print name)

certify that the corner location shown on this record was determined by me or under my direction and control and that this U.S. Public Land Survey Monument Record is correct and complete to the best of my knowledge and belief.

Brandon W. King Nov. 3, 2016
Signature Date

