


21707282000

U. S. PUBLIC LAND SURVEY MONUMENT RECORD

SECTION 28 T 17 N, R 7 W, TOWN OF ONALASKA
 LA CROSSE COUNTY

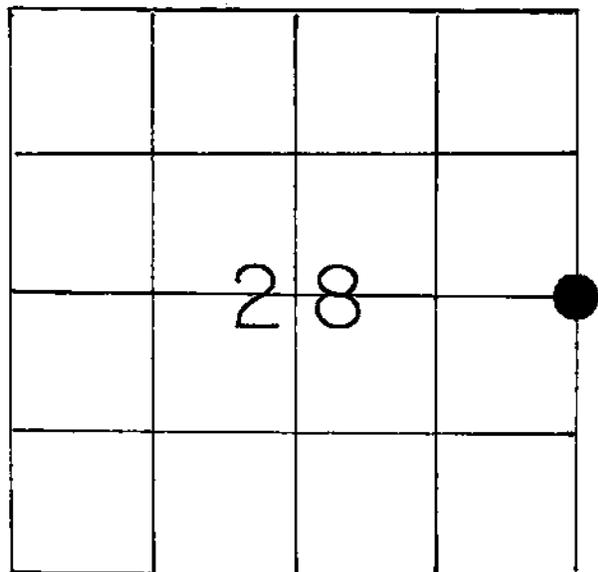

LOCATION OF LANDMARK

Crew: William Jung
 Peter Follansbee

8/11/1987 - (Revised 11/15/1994)

Describe any record evidence, monument evidence, testimonial evidence or any other material evidence you considered and whether the monument was found or restored through acceptance of an obliterated evidence location.

I found an iron pipe that had been used as the corner in previous surveys and accepted it as the best available evidence of the original government corner position. (Replaced the iron pipe with a 12" x 5' concrete monument with brass GPS cap).


Describe or show any material discrepancy between the location of the restored corner and that of the corner previously restored or reestablished.

NONE KNOWN

WISCONSIN COORDINATE SYSTEM
North
East
Theta Angle
Horiz. Order
Vert. Order
TYPE OF LANDMARK (GPS MARKER)
EXIST. 2 1/4" IRON PIPE, O.D.
BEARINGS ARE REFERENCED TO
ASSUMED BEARINGS


RECORD OF DURABLE WITNESS MONUMENTS

NO	DESCRIPTION	BEARING	DISTANCE
1	SET 1 1/4" x 26" IRON PIPE, O.D,	NORTH ±	33.00 Ft.
2	SET 1 1/4" x 26" IRON PIPE, O.D.	EAST ±	33.00 Ft.
3	SET 1 1/4" x 26" IRON PIPE, O.D.	SOUTH ±	33.00 Ft.
4	SET 1 1/4" x 26" IRON PIPE, O.D.	WEST ±	33.00 Ft.

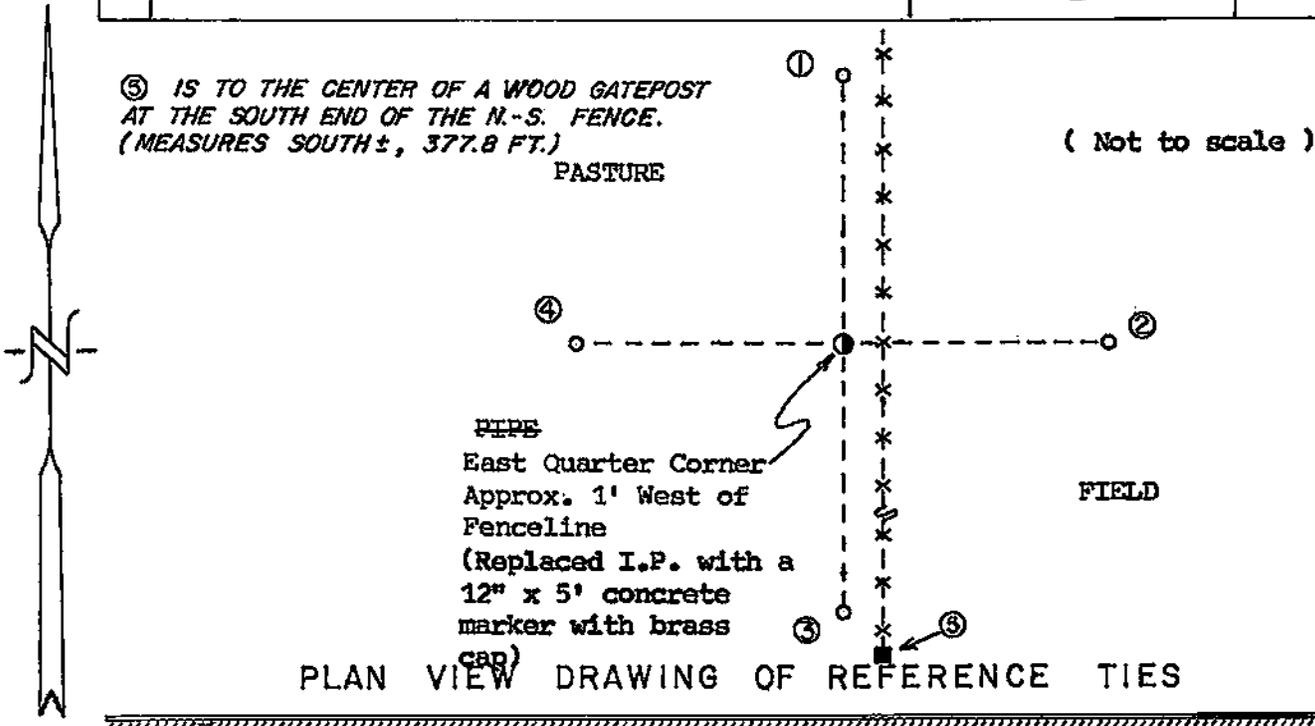

MAP SHOWING DISTANCE AND DIRECTION TO OTHER PUBLIC LAND SURVEY CORNERS USED FOR REESTABLISHING THE CORNER


(NOT TO SCALE)

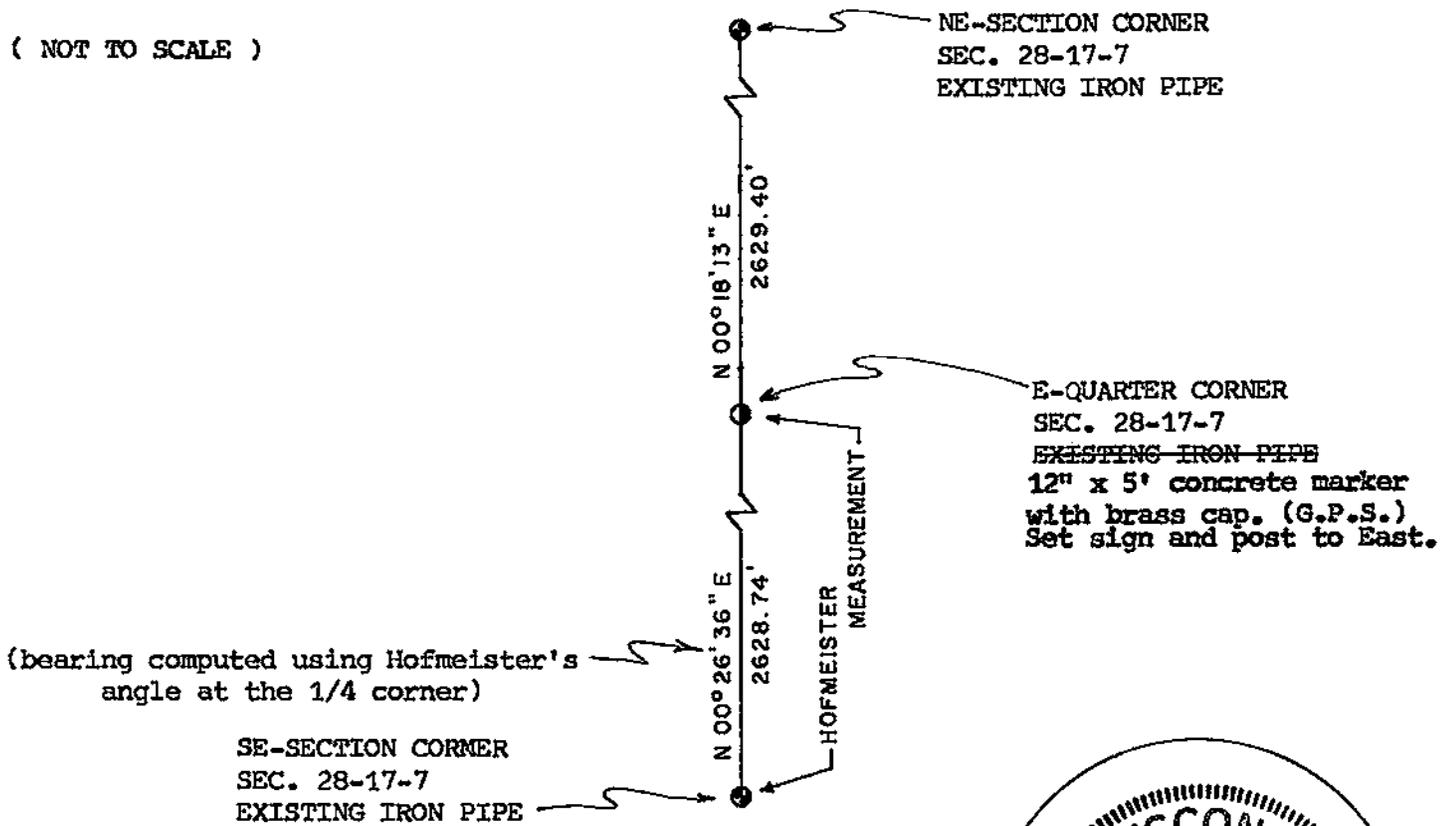

I, WILLIAM C. JUNG
HEREBY CERTIFY THAT THE CORNER LOCATION SHOWN ON THIS RECORD WAS DETERMINED BY ME OR UNDER MY DIRECTION AND CONTROL AND THAT THIS U. S. PUBLIC LAND SURVEY MONUMENT RECORD IS CORRECT AND COMPLETE TO THE BEST OF MY KNOWLEDGE AND BELIEF.

William C. Jung Deputy County Surveyor, December 18, 1987
Signature Date

REVISED 11/15/1994

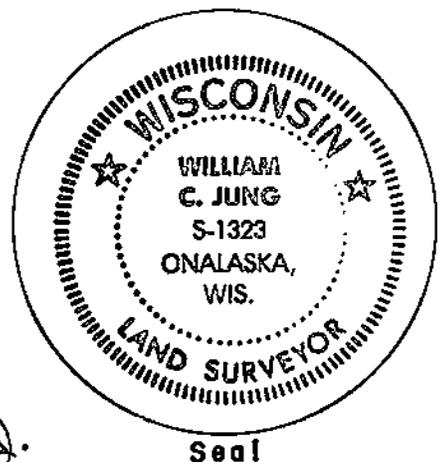

W.C.J.