


U. S. PUBLIC LAND SURVEY MONUMENT RECORD

SECTION 28 T 17 N, R 7 W, TOWN OF ONALASKA

LA CROSSE COUNTY

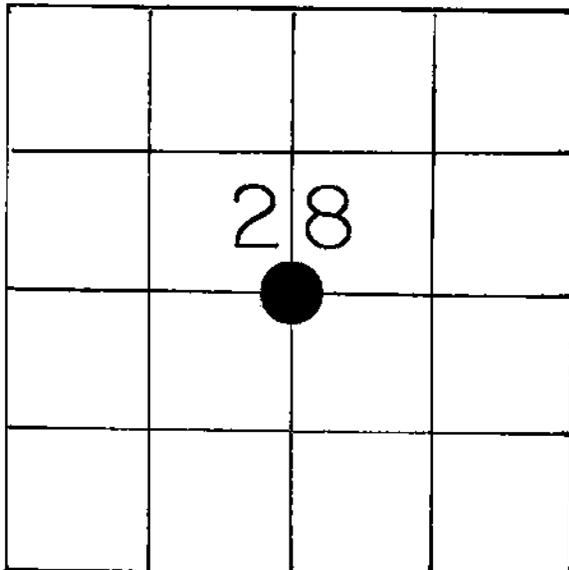

LOCATION OF LANDMARK

CREW: WILLIAM C. JUNG
PETER F. FOLLANSBEE

12-01-1987

Describe any record evidence, monument evidence, testimonial evidence or any other material evidence you considered and whether the monument was found or restored through acceptance of an obliterated evidence location.

I replaced an existing iron pipe with a brass capped Lunde Marker, set flush. Kaye Don Pederson set an iron pipe at the fence corner in 1973. I feel that this Center 1/4 Corner was set in an irregular fashion years ago in an unrecorded survey. The old fence corner itself is almost on line and very close to being equidistant between the North and South 1/4 Corners. I have seen Center 1/4 Corners set in this fashion in other sections, some of which were of record. Other evidence found in the NW1/4 supports the assumption that this corner was set in an irregular fashion and occupied as such over the years. I accepted the old occupied fence corner as evidence of a corner previously set. Pelishek (County Surveyor), Chalsma, Logan, and of course Pederson, all agree on this location. Describe or show any material discrepancy between the location of the restored corner and that of the corner previously restored or reestablished.

This corner is not at the "true Center 1/4 Corner as by law"; that is at the intersection of the 1/4 lines. It falls approximately 1.6' West and 25.8' South of the true Center 1/4 Corner location.

WISCONSIN COORDINATE SYSTEM

North

East

Theta Angle

Horiz. Order

Vert. Order

TYPE OF LANDMARK

SET BRASS CAP LUNDE MARKER (FLUSH)


BEARINGS ARE REFERENCED TO

ASSUMED BEARINGS

(as per Logan and Chalsma surveys)

RECORD OF DURABLE WITNESS MONUMENTS


NO	DESCRIPTION	MAGNETIC	
		BEARING	DISTANCE
1	SET P.K. NAIL IN 5" HICKORY (DOUBLE BLAZED)	N 63°W	18.97 FT.
2	SET P.K. NAIL IN 10" HICKORY (DOUBLE BLAZED)	N 30°W	32.88 FT.
3	SET P.K. NAIL IN 10" BIRCH (DOUBLE BLAZED)	N 50°E	28.90 FT.
4	SET P.K. NAIL IN 11" HICKORY (DOUBLE BLAZED)	S 41°W	39.74 FT.

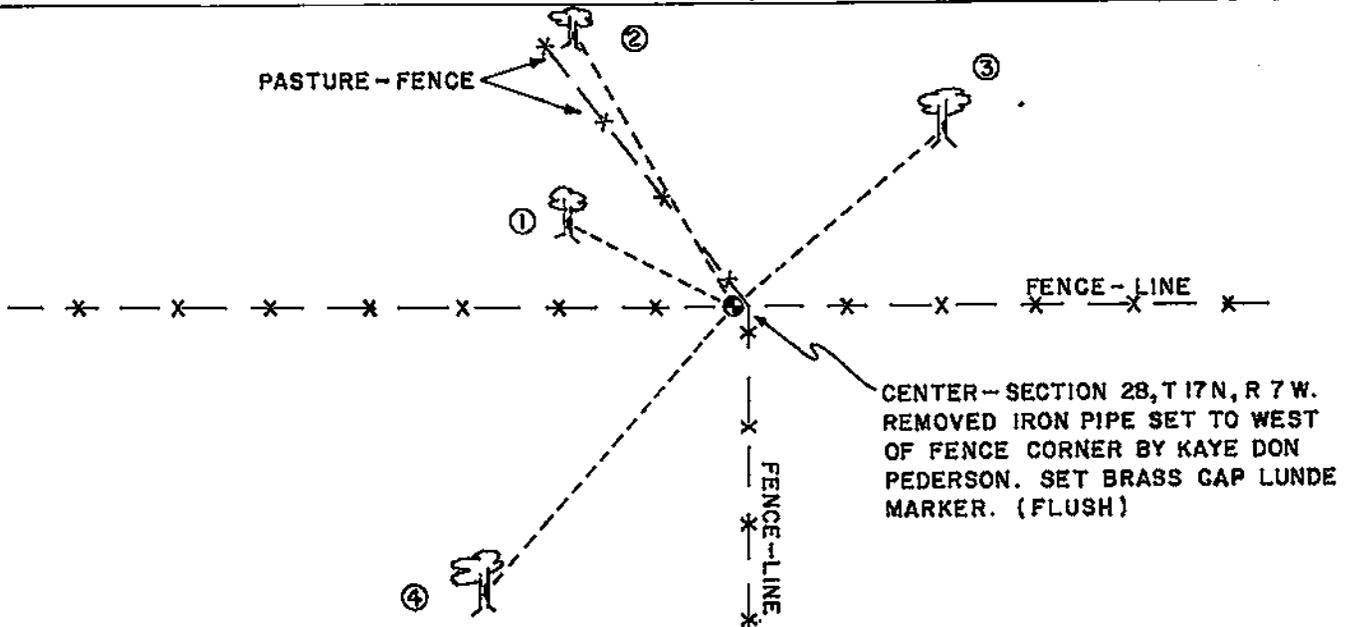

PLAN VIEW DRAWING OF REFERENCE TIES

MAP SHOWING DISTANCE AND DIRECTION TO OTHER PUBLIC LAND SURVEY CORNERS USED FOR REESTABLISHING THE CORNER

(NOT TO SCALE)

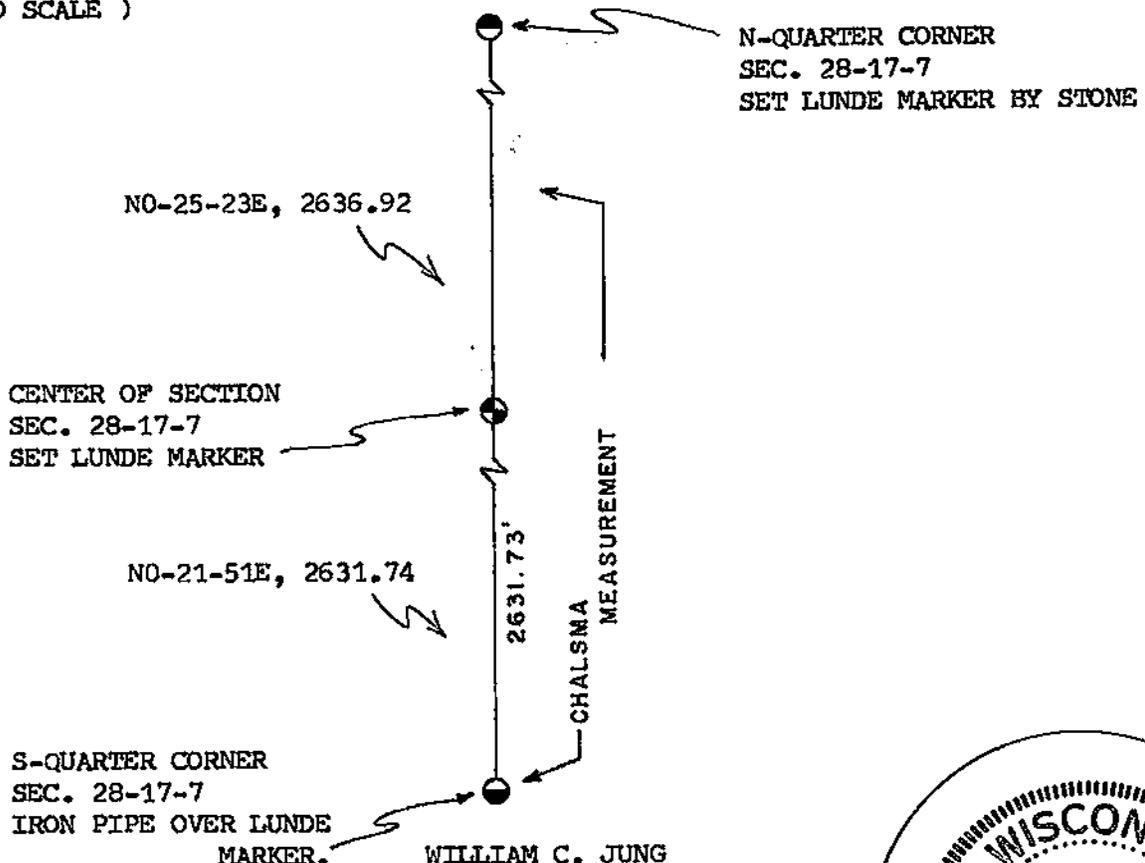

I, WILLIAM C. JUNG
HEREBY CERTIFY THAT THE CORNER LOCATION SHOWN ON THIS RECORD WAS DETERMINED BY ME OR UNDER MY DIRECTION AND CONTROL AND THAT THIS U. S. PUBLIC LAND SURVEY MONUMENT RECORD IS CORRECT AND COMPLETE TO THE BEST OF MY KNOWLEDGE AND BELIEF.

William C. Jung Deputy County Surveyor, January 6, 1988
Signature Date

