


21707290000

U. S. PUBLIC LAND SURVEY MONUMENT RECORD

SECTION 28 T 17 N, R 7 W, ^{CITY}~~TOWN~~ OF ONALASKA

LA CROSSE COUNTY

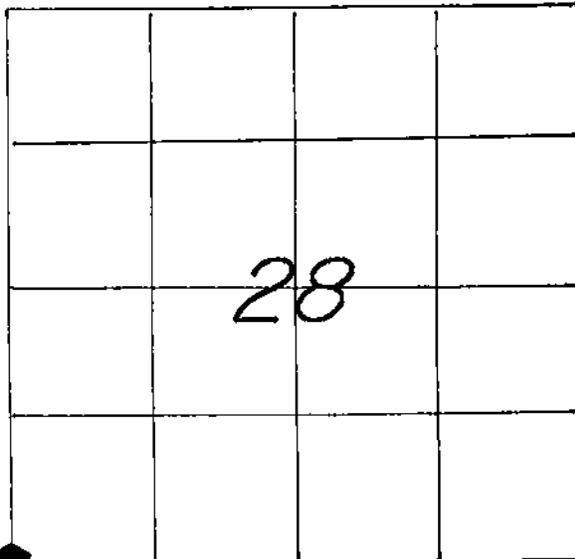

LOCATION OF LANDMARK

Crew: William C. Jung
Peter F. Follansbee

Date: 3/23/98

Describe any record evidence, monument evidence, testimonial evidence or any other material evidence you considered and whether the monument was found or restored through acceptance of an obliterated evidence location.

We found the corner of record and took new ties as the corner was in need of maintenance and updating.


Describe or show any material discrepancy between the location of the restored corner and that of the corner previously restored or reestablished.

NONE KNOWN.

WISCONSIN COORDINATE SYSTEM
North
East
Theta Angle
Horiz. Order
Vert. Order
TYPE OF LANDMARK
BERNTSEN MARKER.
BEARINGS ARE REFERENCED TO
SOLBERG'S MEASUREMENT AS
TRUE NORTH.


RECORD OF DURABLE WITNESS MONUMENTS

NO	DESCRIPTION	BEARING	DISTANCE
1	EXISTING 2-1/2" IRON PIPE	WEST ±	66.08 FT.
2	SOUTHWEST CORNER OF HOUSE WITH NEW SIDING	N. EASTERLY ±	80.73 FT.
3	SET A NEW NAIL IN N-SIDE OF AN UNBLAZED 7" OAK	EAST ±	39.20 FT.
4	SET A NAIL IN S-SIDE OF AN UNBLAZED 36" OAK	EAST ±	76.61 FT.

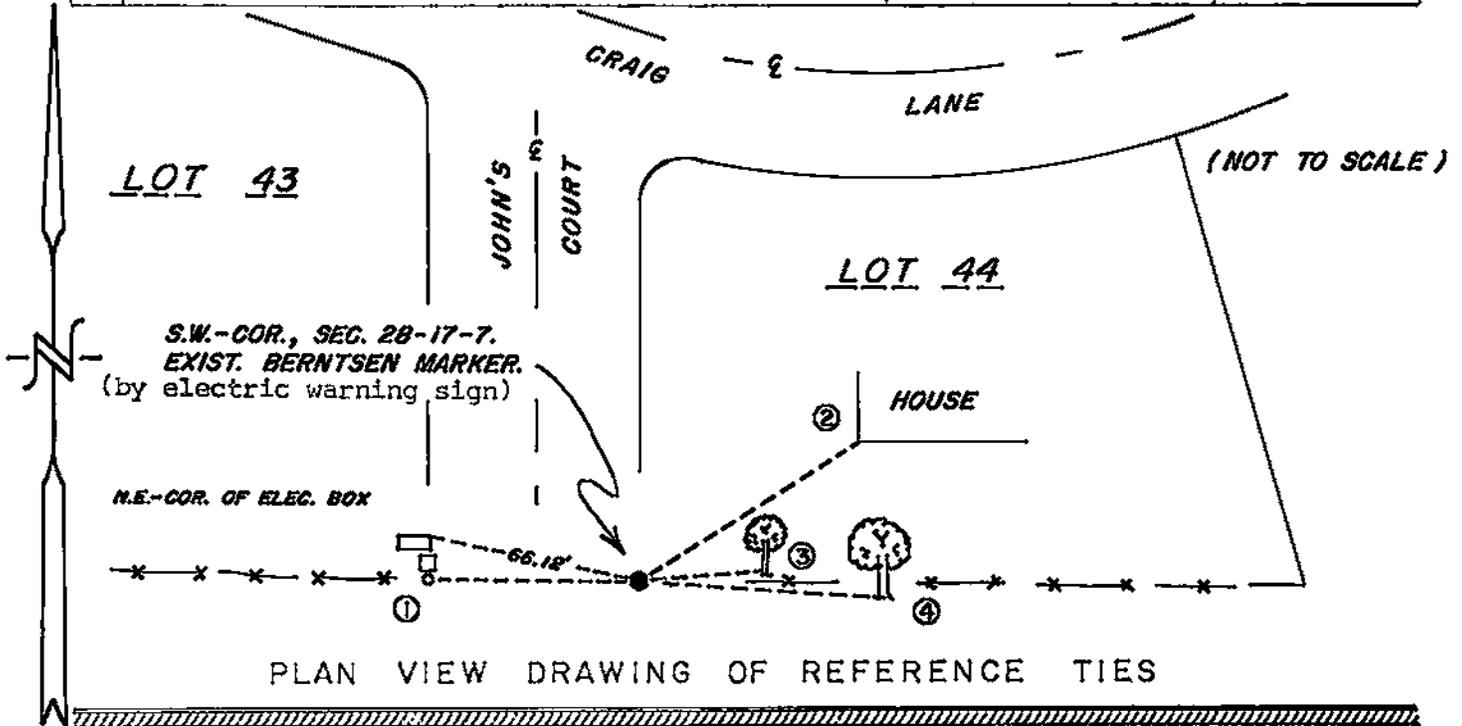


MAP SHOWING DISTANCE AND DIRECTION TO OTHER PUBLIC LAND SURVEY CORNERS USED FOR REESTABLISHING THE CORNER

(not to scale)

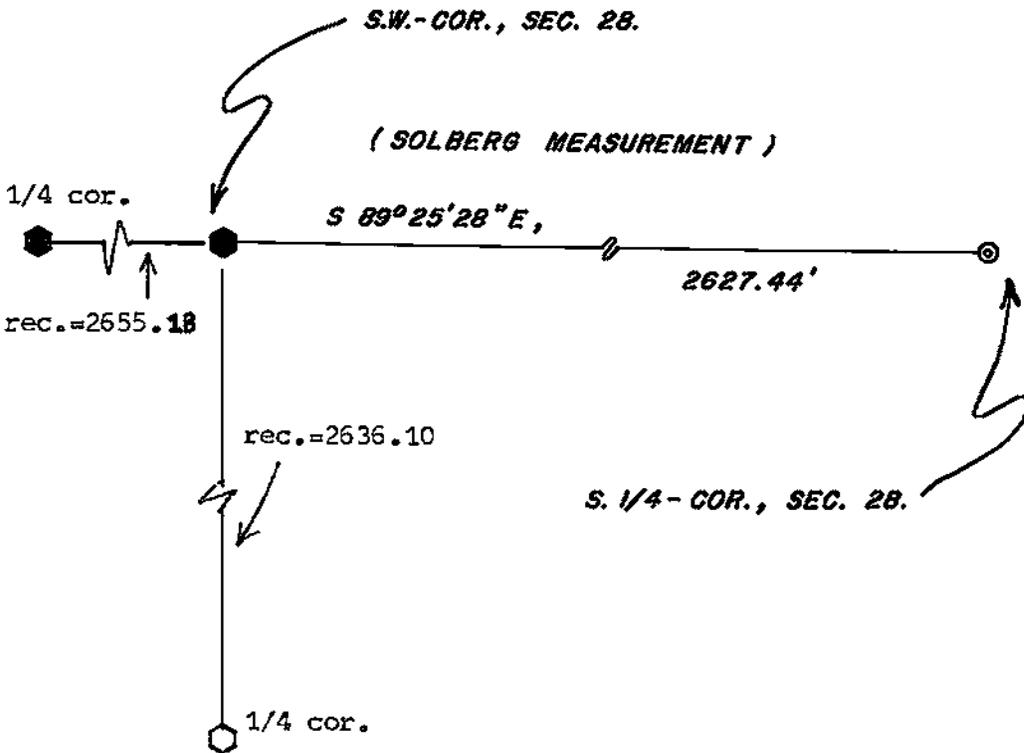

I, WILLIAM C. JUNG, COUNTY SURVEYOR
 HEREBY CERTIFY THAT THE CORNER LOCATION SHOWN ON THIS RECORD
 WAS DETERMINED BY ME OR UNDER MY DIRECTION AND CONTROL AND
 THAT THIS U. S. PUBLIC LAND SURVEY MONUMENT RECORD IS CORRECT
 AND COMPLETE TO THE BEST OF MY KNOWLEDGE AND BELIEF.

William C. Jung 2/25/99
 Signature Date

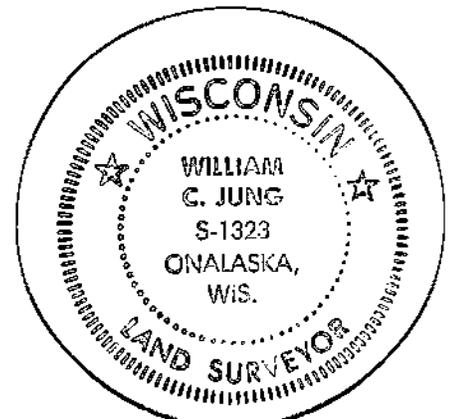


Seal

U. S. PUBLIC LAND SURVEY MONUMENT RECORD

SECTION 28 T 17 N, R 7 W, TOWN OF Onalaska

LA CROSSE COUNTY

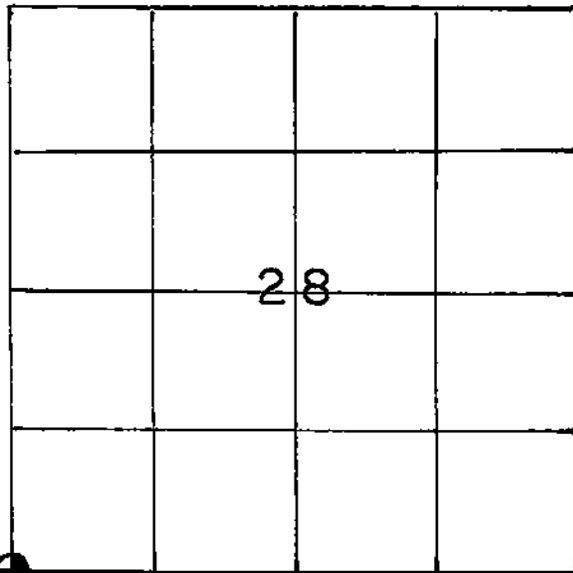

LOCATION OF LANDMARK

CREW: Bill Jung, Perry Dahl
DATE: 5-21-87

WISCONSIN COORDINATE SYSTEM
North
East
Theta Angle
Horiz. Order
Vert. Order
TYPE OF LANDMARK
Berntsen Marker
BEARINGS ARE REFERENCED TO
True (as per Solberg survey)

Describe any record evidence, monument evidence, testimonial evidence or any other material evidence you considered and whether the monument was found or restored through acceptance of an obliterated evidence location.

I found an existing Berntsen marker at the corner. Ray Pelishek set this marker in 1973. It replaced an existing marker. This point has been used as the corner in other surveys including the plat of "Second Addition to Schaller's Oak Park Addition".


Describe or show any material discrepancy between the location of the restored corner and that of the corner previously restored or reestablished.

None known.

RECORD OF DURABLE WITNESS MONUMENTS

NO	DESCRIPTION	BEARING	DISTANCE
1	Southwest corner of house	-----	80.90
2	Existing 2½" iron pipe	West+	66.12
3	P.K. nail in 5" unblazed oak	East+	39.25
4			


Note: See plat of "Second Addition to Schaller's Oak Park Addition" for more ties to the plat.

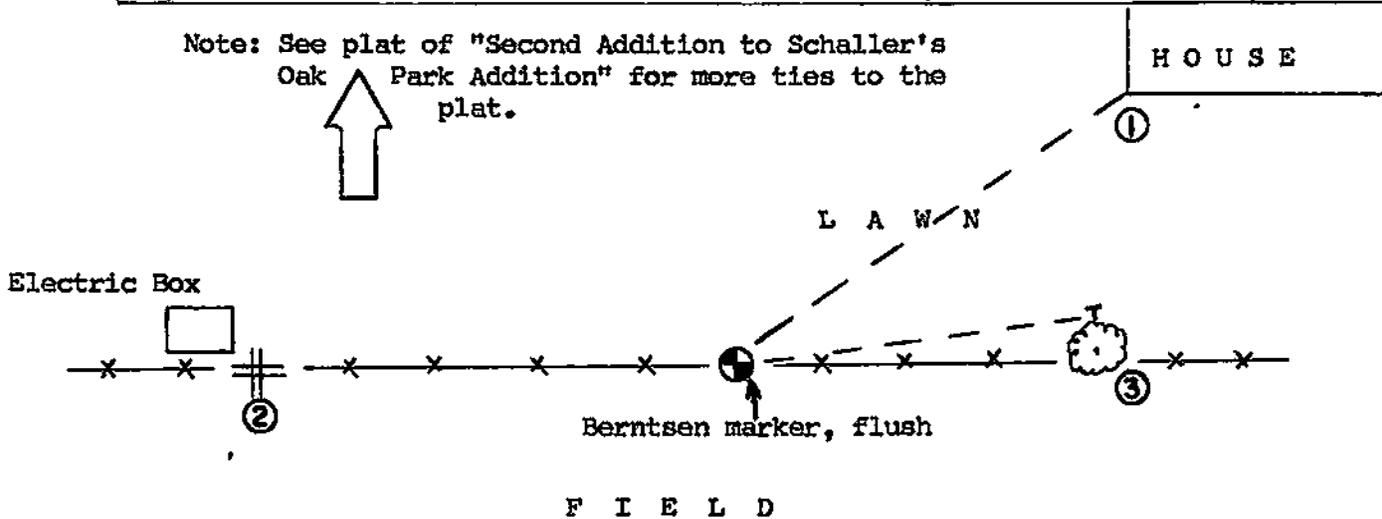

PLAN VIEW DRAWING OF REFERENCE TIES

MAP SHOWING DISTANCE AND DIRECTION TO OTHER PUBLIC LAND SURVEY CORNERS USED FOR REESTABLISHING THE CORNER

(not to scale)

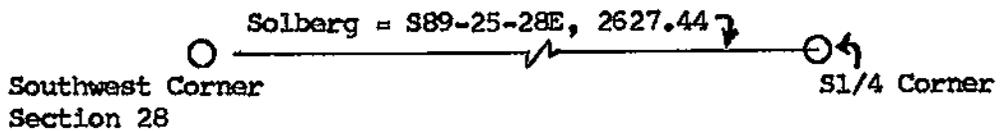


I, William C. Jung, Deputy County Surveyor,
 HEREBY CERTIFY THAT THE CORNER LOCATION SHOWN ON THIS RECORD
 WAS DETERMINED BY ME OR UNDER MY DIRECTION AND CONTROL AND
 THAT THIS U. S. PUBLIC LAND SURVEY MONUMENT RECORD IS CORRECT
 AND COMPLETE TO THE BEST OF MY KNOWLEDGE AND BELIEF.

William C. Jung
 Signature

June 30, 1987
 Date

Revised: December 30, 1987

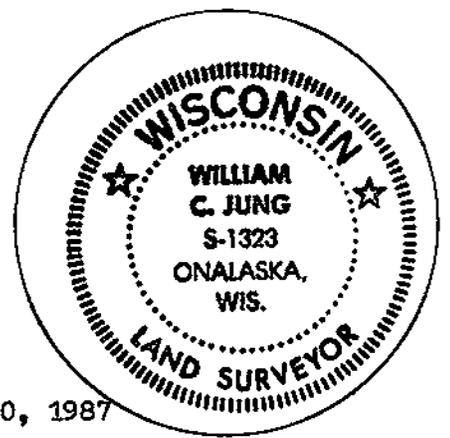

Seal



DAVY ENGINEERING CO.

115 So. 6th STREET • LA CROSSE, WISCONSIN 54601

STREETS
LAND SURVEYS
SEWER SYSTEMS
WATER SYSTEMS
WATER TREATMENT
SEWAGE TREATMENT

REGISTERED ENGINEERS AND LAND SURVEYORS
MUNICIPAL AND INDUSTRIAL CONSULTANTS



TELEPHONE: (608) 784-9882 P.O. BOX 762

January 18, 1973

La Crosse County Zoning Committee
La Crosse County Court House
La Crosse, Wisconsin 54601

Gentlemen:

I hereby certify that I have placed a La Crosse County survey marker at the corner of Sections 28, 29, 32 and 33, Township 17 North, Range 7 West.

The survey marker was set in place of an existing monument that marked the corner. The Section corner is tied in and referenced to the Plat of the Second Addition of Schaller's Oak Park Addition in the Town of Onalaska.

Sincerely yours,

DAVY ENGINEERING CO.
CONSULTING ENGINEERS

Ray Pelishek

Registered Land Surveyor S-188

RP:mr