


U. S. PUBLIC LAND SURVEY MONUMENT RECORD

SECTION 29 T 17 N, R 7 W, TOWN OF ONALASKA  
 LA CROSSE COUNTY

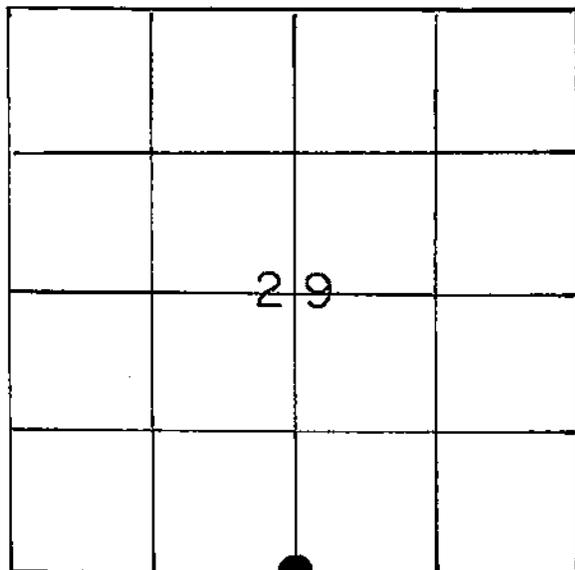

LOCATION OF LANDMARK

Crew: William Jung  
 Perry Dahl  
 4/19/85

WISCONSIN COORDINATE SYSTEM
North
East
Theta Angle
Horiz. Order
Vert. Order
TYPE OF LANDMARK
BERNTSEN (existing)
BEARINGS ARE REFERENCED TO

Describe any record evidence, monument evidence, testimonial evidence or any other material evidence you considered and whether the monument was found or restored through acceptance of an obliterated evidence location.

The Plat of Heritage Hills shows a brass capped U.S.C.E. marker at this corner. Apparently in 1973 Ron Blummer removed this marker and replaced it with a Berntsen marker. This marker has since been used in other surveys. I accepted this marker as the best available evidence of the original government corner position.

Describe or show any material discrepancy between the location of the restored corner and that of the corner previously restored or reestablished.

None known.

