


U. S. PUBLIC LAND SURVEY MONUMENT RECORD

SECTION 30 T 17 N, R 7 W, TOWN OF ONALASKA
 LA CROSSE COUNTY

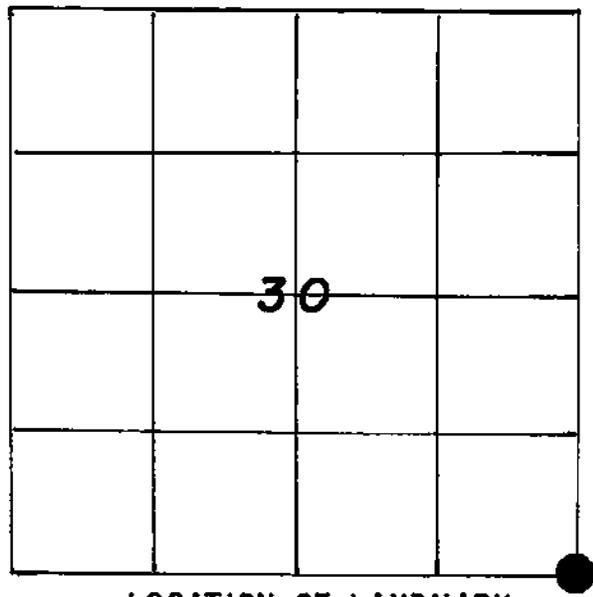

LOCATION OF LANDMARK

WISCONSIN COORDINATE SYSTEM
North
East
Theta Angle
Horiz. Order
Vert. Order
TYPE OF LANDMARK
BEARINGS ARE REFERENCED TO ASSUMED

Describe any record evidence, monument evidence, testimonial evidence or any other material evidence you considered and whether the monument was found or restored through acceptance of an obliterated evidence location.

This corner was established by extending a straight line from the South 1/4 corner of Section 29, West thru the Southwest corner of the SE 1/4 of the SW 1/4 of Section 29 and being the Southwest corner of Heritage Hills Subdivision, and doubling the distance from the South 1/4 corner of Section 29.

Describe or show any material discrepancy between the location of the restored corner and that of the corner previously restored or reestablished.


RECORD OF DURABLE WITNESS MONUMENTS

NO	DESCRIPTION	BEARING	DISTANCE
1			
2			
3			
4			

Computed location only. This corner falls in Lake Onalaska, but was set by the original Government Survey. See section control data sheet for ties to other section corners.

PLAN VIEW DRAWING OF REFERENCE TIES

MAP SHOWING DISTANCE AND DIRECTION TO OTHER PUBLIC LAND SURVEY CORNERS USED FOR REESTABLISHING THE CORNER

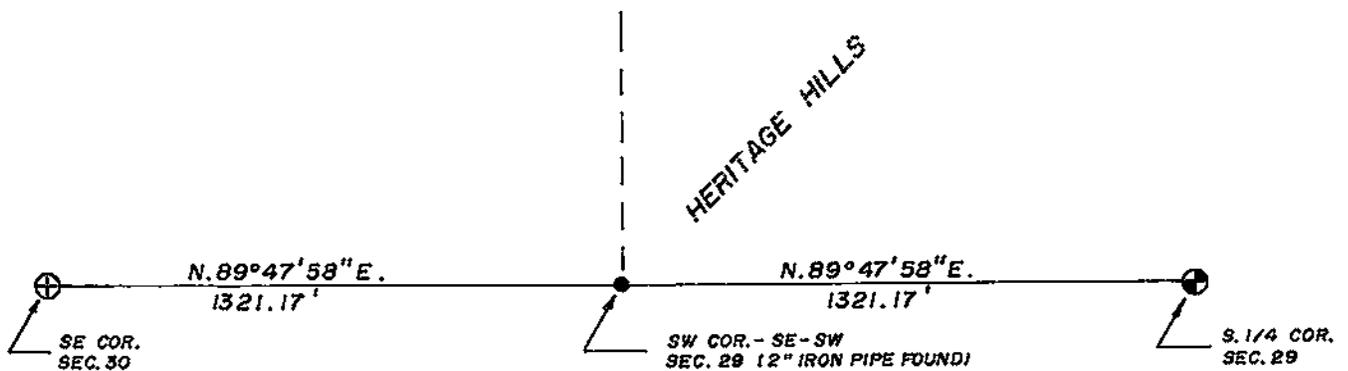

I, Robert W. Condon
 HEREBY CERTIFY THAT THE CORNER LOCATION SHOWN ON THIS RECORD
 WAS DETERMINED BY ME OR UNDER MY DIRECTION AND CONTROL AND
 THAT THIS U. S. PUBLIC LAND SURVEY MONUMENT RECORD IS CORRECT
 AND COMPLETE TO THE BEST OF MY KNOWLEDGE AND BELIEF.

Robert W. Condon
 Signature

8-21-91
 Date



Seal