


21707302020

U. S. PUBLIC LAND SURVEY MONUMENT RECORD

SECTION 30 T 17 N, R 7 W, TOWN OF ONALASKA

LA CROSSE COUNTY

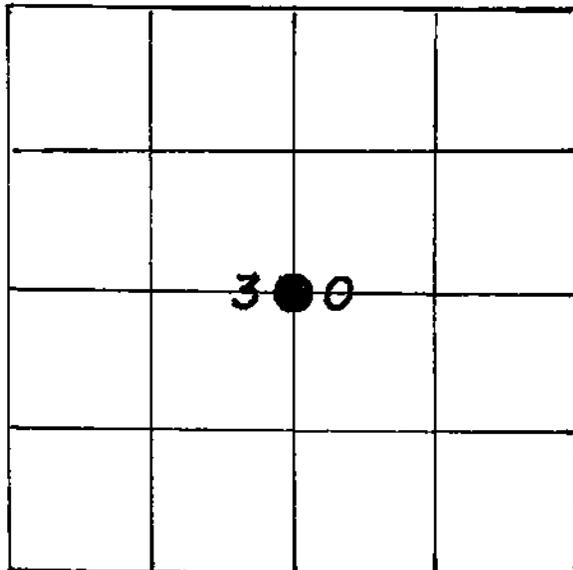

LOCATION OF LANDMARK

WISCONSIN COORDINATE SYSTEM

North

East

Theta Angle

Horiz. Order

Vert. Order

TYPE OF LANDMARK

BEARINGS ARE REFERENCED TO

ASSUMED

Describe any record evidence, monument evidence, testimonial evidence or any other material evidence you considered and whether the monument was found or restored through acceptance of an obliterated evidence location.

This corner was established by straight line intersect between the East 1/4 corner, the West 1/4 corner, the North 1/4 corner, and the Southwest corner of the NW 1/4 of the SE 1/4, said 1/4-1/4 corner is monumented by a Corps of Engineers brass cap monument (see 1985 Plat of Survey by Keith M. Graham).

Describe or show any material discrepancy between the location of the restored corner and that of the corner previously restored or reestablished.

