


U. S. PUBLIC LAND SURVEY MONUMENT RECORD

SECTION 32 T 17 N, R 7 W, CITY OF ONALASKA
 LA CROSSE COUNTY

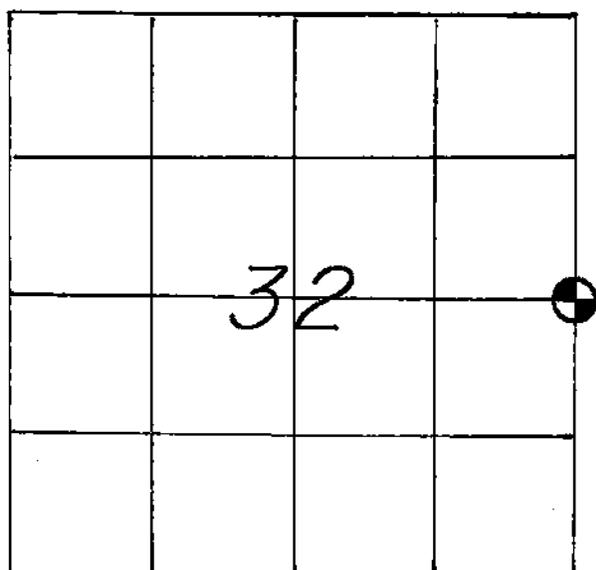

LOCATION OF LANDMARK

Crew: WILLIAM C. JUNG
 DALLAS WILHITE
 PETER F. FOLLANSBEE

Date: 8/1 /1995

Describe any record evidence, monument evidence, testimonial evidence or any other material evidence you considered and whether the monument was found or restored through acceptance of an obliterated evidence location.

The iron bar at the corner was apparently lost during road construction. We set a lande marker at the old corner location. This corner location has been used in many surveys in the surrounding area.

Describe or show any material discrepancy between the location of the restored corner and that of the corner previously restored or reestablished.

None Known.

WISCONSIN COORDINATE SYSTEM

North

East

Theta Angle

Horiz. Order

Vert. Order

TYPE OF LANDMARK

Brass cap lande marker.


BEARINGS ARE REFERENCED TO

Assumed

U. S. PUBLIC LAND SURVEY MONUMENT RECORD

SECTION 32 T 17 N, R 7 W, CITY OF ONALASKA

LA CROSSE COUNTY

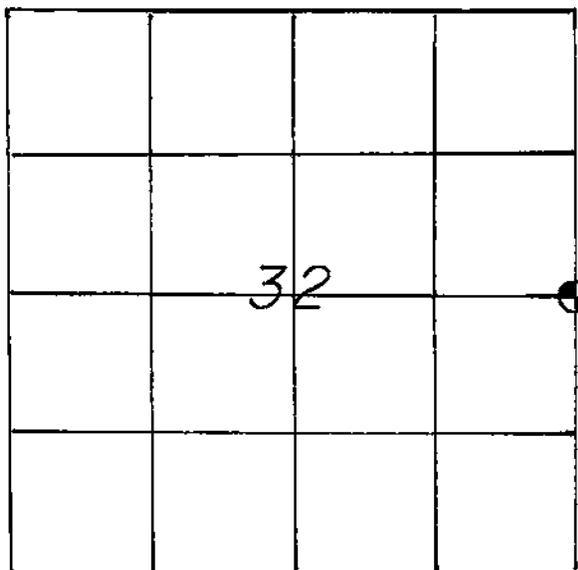

LOCATION OF LANDMARK

CREW: BILL JUNG
 PERRY DAHL
 BILL WOODMAN

DATE: 7-1-86

Describe any record evidence, monument evidence, testimonial evidence or any other material evidence you considered and whether the monument was found or restored through acceptance of an obliterated evidence location.

Bill Woodman showed me an existing monument at the 1/4 corner. This point has been used as the corner in previous surveys, including the Plats of Skyview Addition and Parkridge Second Addition. I accepted this location as the best available evidence of the original govt. corner position. I could not find an iron pipe 33 feet to the South. The corner falls in the center of Riders' Club Road which is now a dirt road.

Describe or show any material discrepancy between the location of the restored corner and that of the corner previously restored or reestablished.


None known.

WISCONSIN COORDINATE SYSTEM
North
East
Theta Angle
Horiz. Order
Vert. Order
TYPE OF LANDMARK
5/8" IRON BAR
BEARINGS ARE REFERENCED TO

VOID

RECORD OF DURABLE WITNESS MONUMENTS

NO	DESCRIPTION	MAGNETIC	
		BEARING	DISTANCE
1	S.E. CORNER OF UTILITY BOX	N77°W+	110.76'
2	CENTER BOLT OF FIRE HYDRANT	S69°W+	126.17'
3	PLASTIC CORNER OF HOUSE (S.W. CORNER)	S21°E+	97.07'
4	BRICK CORNER OF HOUSE (N.W. CORNER)	S28°E+	68.69'
5	CENTER OF MANHOLE	N76°E+	123.67'

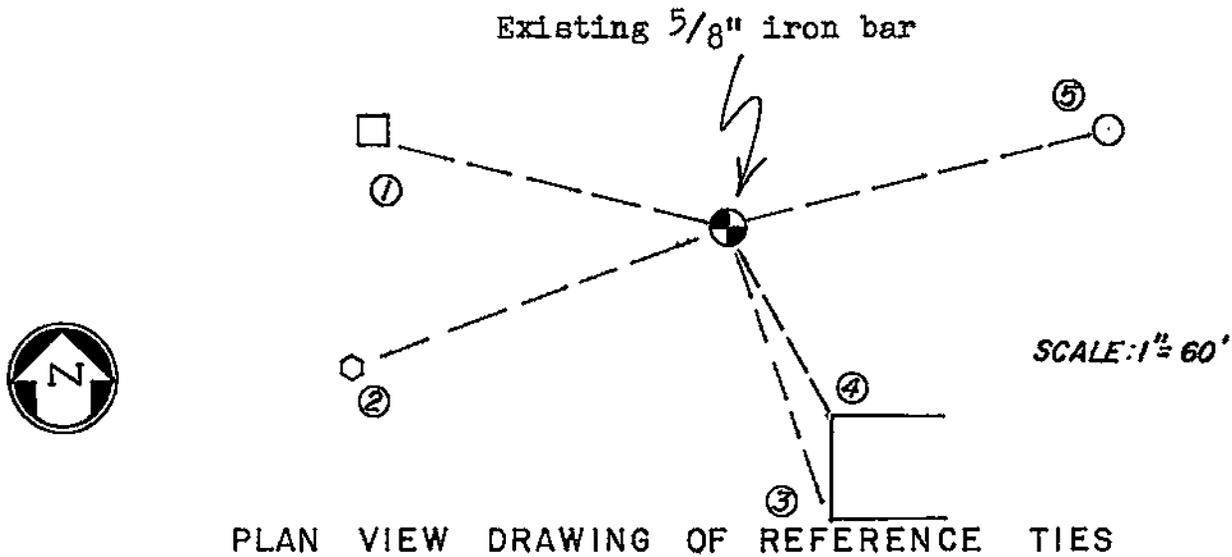

MAP SHOWING DISTANCE AND DIRECTION TO OTHER PUBLIC LAND SURVEY CORNERS USED FOR REESTABLISHING THE CORNER


(no measurements made by me at this time)

VOID

I, William C. Jung, Deputy County Surveyor,
 HEREBY CERTIFY THAT THE CORNER LOCATION SHOWN ON THIS RECORD
 WAS DETERMINED BY ME OR UNDER MY DIRECTION AND CONTROL AND
 THAT THIS U. S. PUBLIC LAND SURVEY MONUMENT RECORD IS CORRECT
 AND COMPLETE TO THE BEST OF MY KNOWLEDGE AND BELIEF.

William C. Jung
 Signature

January 12, 1987
 Date

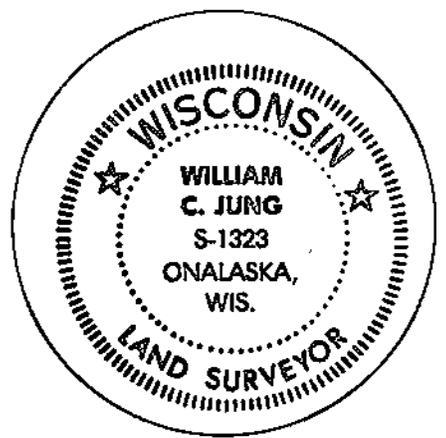

Seal