


U. S. PUBLIC LAND SURVEY MONUMENT RECORD

SECTION 33 T 17 N, R 7 W, TOWN OF ONALASKA
LA CROSSE COUNTY

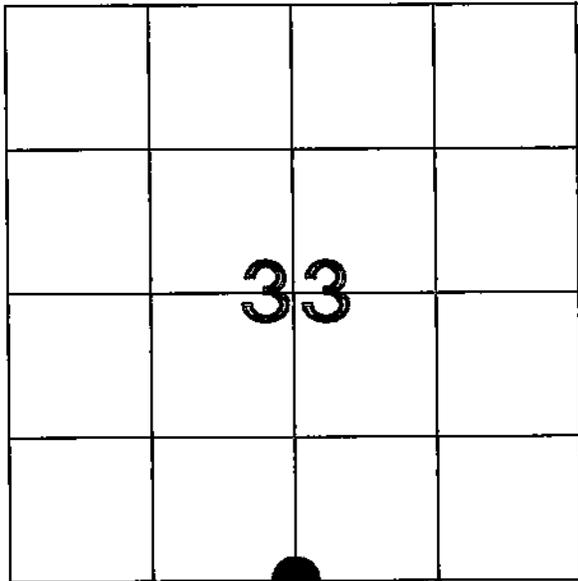

LOCATION OF LANDMARK

CREW: Mike Harding
 Scott Dunnum

DATE: 4-16-96

Describe any record evidence, monument evidence, testimonial evidence, or any other material evidence you considered and whether the monument was found or restored through acceptance of an obliterated evidence location.


Found existing 1" iron pipe as best available evidence for location of this south 1/4 corner.

Describe or show any material discrepancy between the location of the restored corner and that of the corner previously restored or reestablished.


WISCONSIN COORDINATE SYSTEM
North
East
Theta Angle
Horiz. Order
Vert. Order
TYPE OF LANDMARK
Found 1" IP
BEARINGS ARE REFERENCED TO
Grid North per State Hwy Project
☺ #1631-1-21

RECORD OF DURABLE WITNESS MONUMENTS

NO	DESCRIPTION	BEARING	DISTANCE
1	found 3/4" iron bar DOT marker	N 03°09'02" E	821.97'
2	found 3/4" iron bar DOT marker	N 15°19'20" E	473.54'
3	found 3/4" iron bar DOT marker	S 37°58'06" E	939.29'
4	found 3/4" iron bar DOT marker	N 01°46'27" E	1378.99'

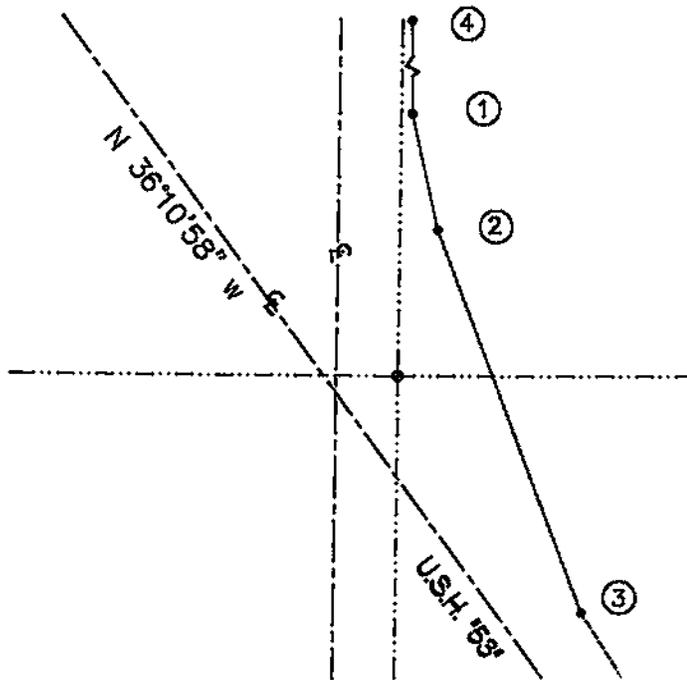

MAP SHOWING DISTANCE AND DIRECTION TO OTHER PUBLIC LAND SURVEY CORNERS USED FOR REESTABLISHING THE CORNER

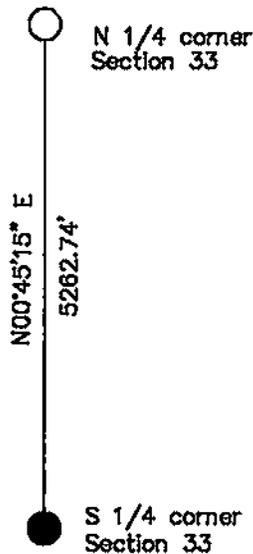

I, _____
 HEREBY CERTIFY THAT THE CORNER LOCATION SHOWN ON THIS RECORD
 WAS DETERMINED BY ME OR UNDER MY DIRECTION AND CONTROL AND
 THAT THIS U. S. PUBLIC LAND SURVEY MONUMENT RECORD IS CORRECT
 AND COMPLETE TO THE BEST OF MY KNOWLEDGE AND BELIEF.



Michael J. Harding

 Signature

5/16/96

 Date

Seal