


U. S. PUBLIC LAND SURVEY MONUMENT RECORD

SECTION 33 T 17 N, R 7 W, TOWN OF ONALASKA
LA CROSSE COUNTY

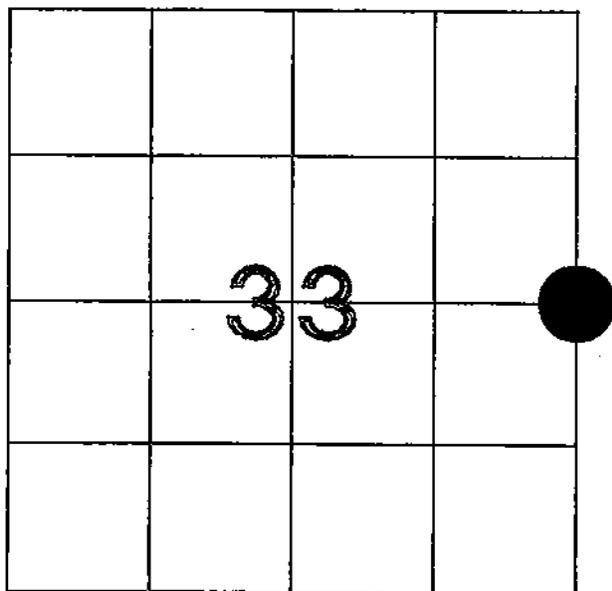

LOCATION OF LANDMARK

CREW: MIKE HARDING
 SCOTT DUNNUM

DATE: 4-16-96

Describe any record evidence, monument evidence, testimonial evidence, or any other material evidence you considered and whether the monument was found or restored through acceptance of an obliterated evidence location.

I found a 3 foot oak tree that appeared to be an original bearing tree. Also Richard D. Risberg gave testimonial evidence stating that he believed the corner to be up on the slope of the logging road. The fences to the north, east, and south are also strong occupational evidence for this location of the east 1/4 corner.

Describe or show any material discrepancy between the location of the restored corner and that of the corner previously restored or reestablished.

None

WISCONSIN COORDINATE SYSTEM

North

East

Theta Angle

Horiz. Order

Vert. Order

TYPE OF LANDMARK

SET 3/4" IRON BAR


BEARINGS ARE REFERENCED TO

Grid North per State Hwy Project
 #1631-1-21

RECORD OF DURABLE WITNESS MONUMENTS


NO	DESCRIPTION	BEARING	DISTANCE
1	Nail in base of 6" Hickory (Unblazed)	S 47°27'01" E	29.55'
2	Nail in base of 3' Oak (Unblazed)* see note	N 72°59'32" E	47.53'
3	Nail in base of 17" Oak (Unblazed)	N 69°23'32" E	13.78'
4	Nail in base of 4" Oak (Unblazed)	N 10°54'06" E	7.45'

* Note: 3' Oak tree believed to be an original bearing tree.

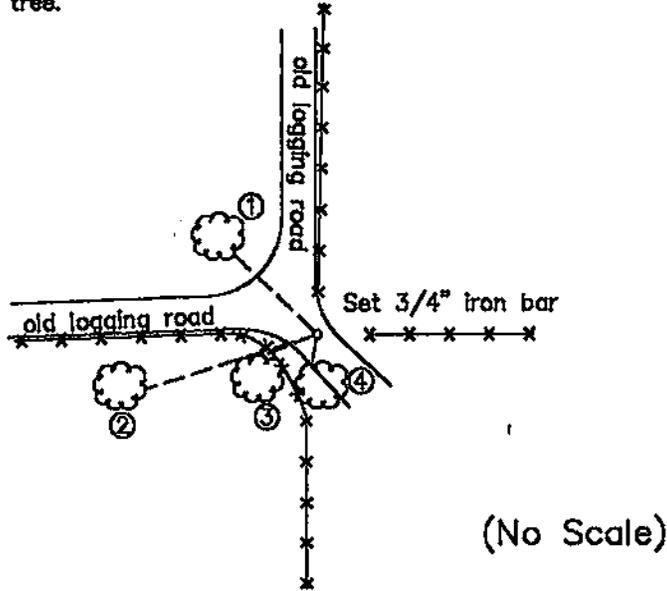

PLAN VIEW DRAWING OF REFERENCE TIES

MAP SHOWING DISTANCE AND DIRECTION TO OTHER PUBLIC LAND SURVEY CORNERS USED FOR REESTABLISHING THE CORNER

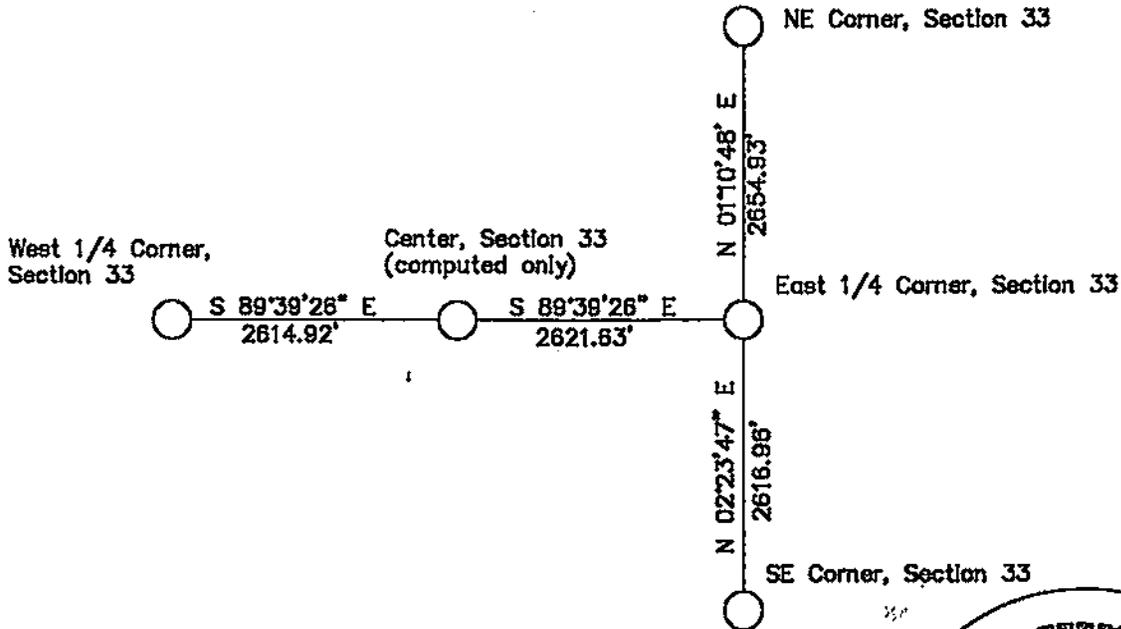

I, _____
 HEREBY CERTIFY THAT THE CORNER LOCATION SHOWN ON THIS RECORD WAS DETERMINED BY ME OR UNDER MY DIRECTION AND CONTROL AND THAT THIS U. S. PUBLIC LAND SURVEY MONUMENT RECORD IS CORRECT AND COMPLETE TO THE BEST OF MY KNOWLEDGE AND BELIEF.



Michael J. Harding
 Signature

4-29-96
 Date

Seal

U.S. PUBLIC LAND SURVEY MONUMENT RECORD


INSTRUCTIONS:

This record shall show the location of the corner and shall include all of the following nine elements (a through i).

- (a) Identify the corner by reference to the U.S. public land survey system.

 = Corner monument restored.

East Quarter Corner
Section 33, Township 17N,
Range 07W, La Crosse County,
Wisconsin.

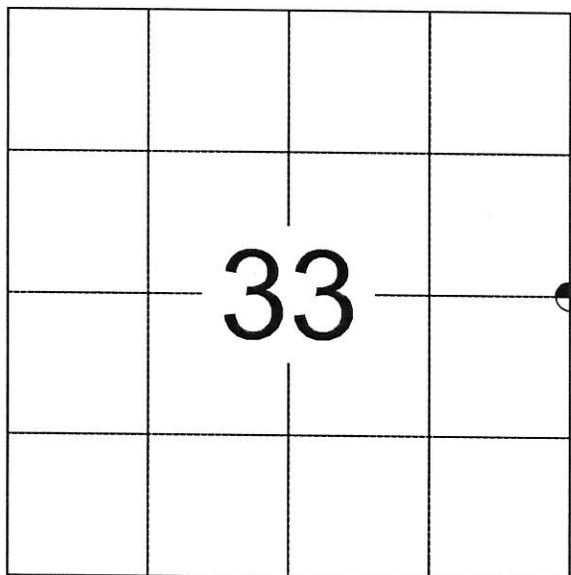


- (b) Describe any record evidence, monument evidence, occupation evidence, testimonial evidence, or any other material evidence that was considered, and whether the monument was found or placed.


A MAGNETIC SEARCH WAS PERFORMED AND NO MONUMENT WAS FOUND. A 0.75" IRON REBAR CAPPED WAS PLACED AT THE A CALCULATED POSITION FROM OTHER LOCATED SECTION MONUMENTS. SET 4 NEW WITNESS MONUMENTS.

- (c) In the plan view drawing below, provide reference ties to at least 4 witness monuments, or, if the location is within a municipality, to at least 2 witness monuments. (Witness monuments shall be made of concrete, natural stone, iron or other equally durable material.) Describe witness monuments.

- (d) Show a plan view drawing depicting the relevant monuments and reference ties which is sufficient in detail to enable accurate relocation of the corner monument if the corner monument is disturbed. Indicate north.

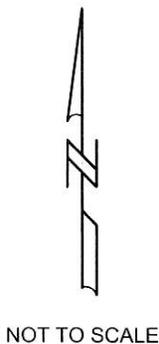

 SET 0.75" O.D. IR
 SET 0.75" O.D. IR CAPPED

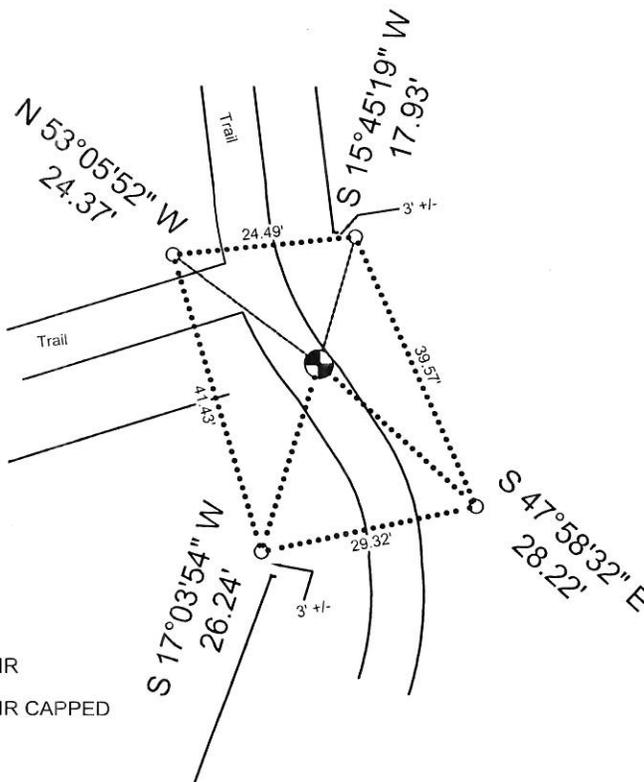

(e) Describe any material discrepancy between the location of the corner as restored or reestablished and the location of that corner as previously restored or reestablished by distance and direction. Show the discrepancy on the plan view drawing under (d), above. Show the distances between the corner as previously restored or reestablished and (1) the corner as restored or reestablished, and (2) to at least 2 of the witness monuments shown on the drawing in (d), above.

NO DISCREPANCIES WERE FOUND.

(f) Was the corner restored through acceptance of (1) an obliterated evidence location, or , (2) a found perpetuated location?

OBLITERATED EVIDENCE LOCATION.

(g&h) Was the corner reestablished through lost corner proportionate methods? If so, show the method including the directions and distances the other public land survey corners used as evidence or as evidence or used for proportioning in determining the corner location?

NO.

(i) I, Brandon W. King S-2632
(type or print name)

certify that the corner location shown on this record was determined by me or under my direction and control and that this U.S. Public Land Survey Monument Record is correct and complete to the best of my knowledge and belief.

Brandon W. King Nov. 3, 2016
Signature Date

