

RECORD OF LAND CORNER PERPETUATION

No. _____

STATE OF WISCONSIN

County of La Crosse } ss.

I, Ray Pelishek, hereby certify that the information shown hereon correctly describes the original corner, resurvey information, evidence found, type of monument found or placed, and witness monuments and accessories used to perpetuate the location of the original or established corner.

Dated this 29th day of October, 19 81

at La Crosse, Wisconsin.


Ray P. Pelishek
La Crosse County Surveyor
Title

COUNTY			La Crosse
TOWN			Onalaska
HIGHWAY			Green Coulee Rd.
SECTION	TOWNSHIP	RANGE	
<u>34</u> 3	<u>17</u> 16	<u>7</u> 7	
TYPE OF LANDMARK			
Bernsten Monument			

Date of Survey Oct. 29, 1981


Drafted by M. Weibel

Date Nov. 3, 1981

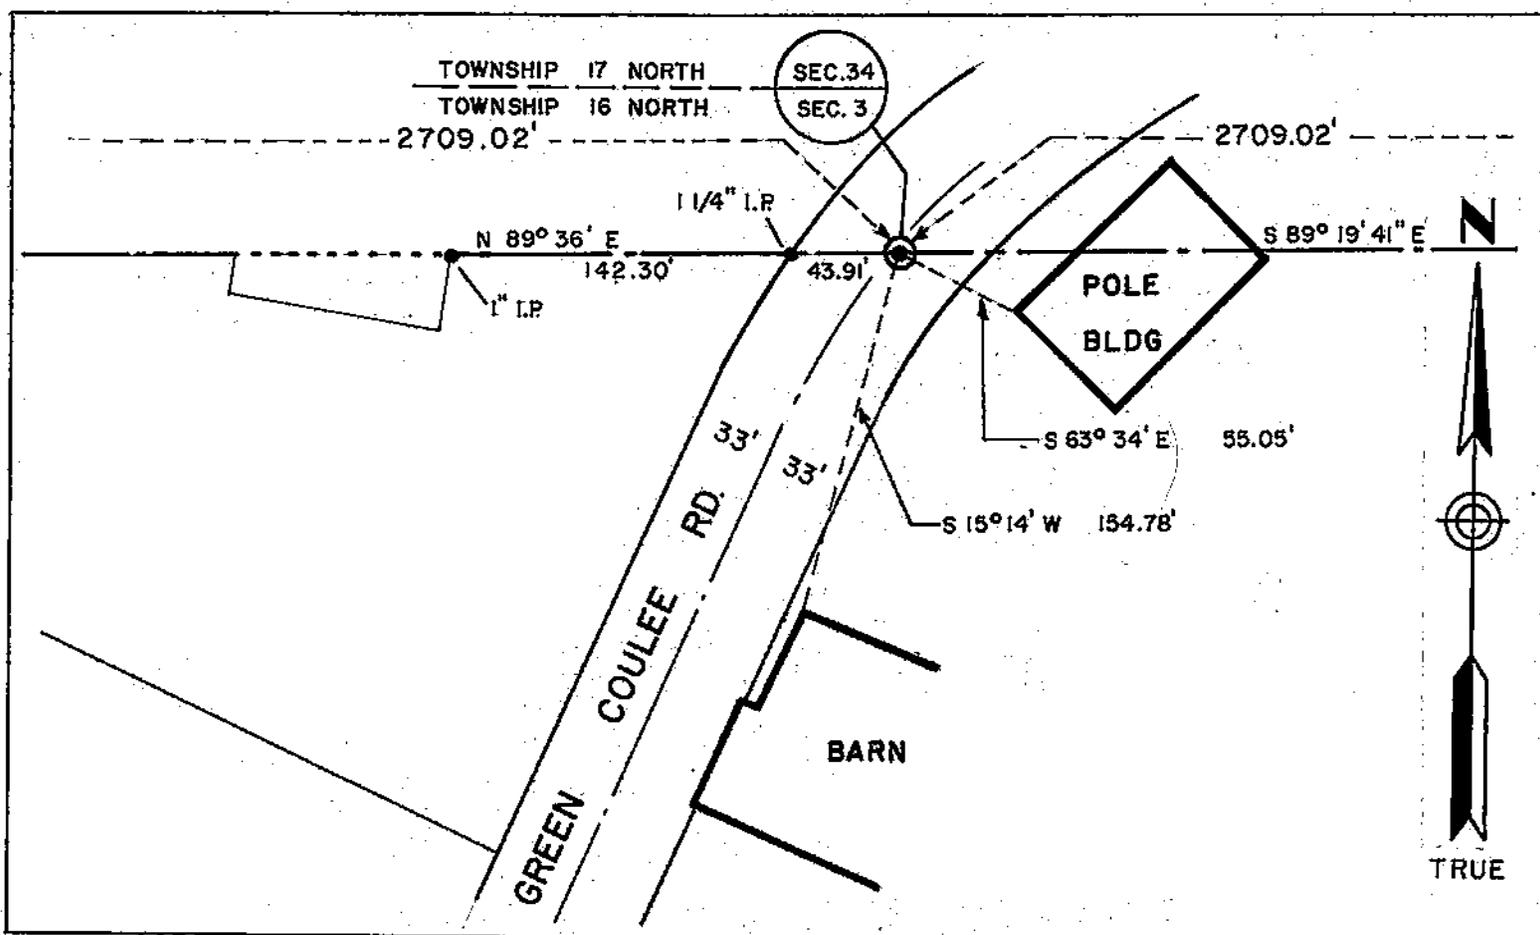

WISCONSIN COORDINATE SYSTEM	
North	Zone
East	
Elevation	Theta Angle
Vertical control order	
Horizontal control order	


REMARKS:

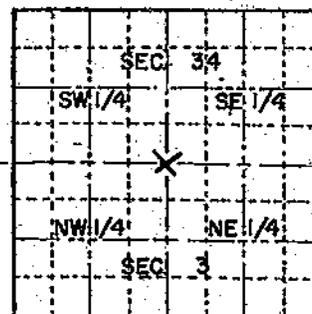

LOCATION SKETCH
(Location of landmark indicated by "x")

U. S. PUBLIC LAND SURVEY MONUMENT RECORD

SECTION 3 T 16 N, R 7 W, TOWN OF ONALASKA
 LA CROSSE COUNTY

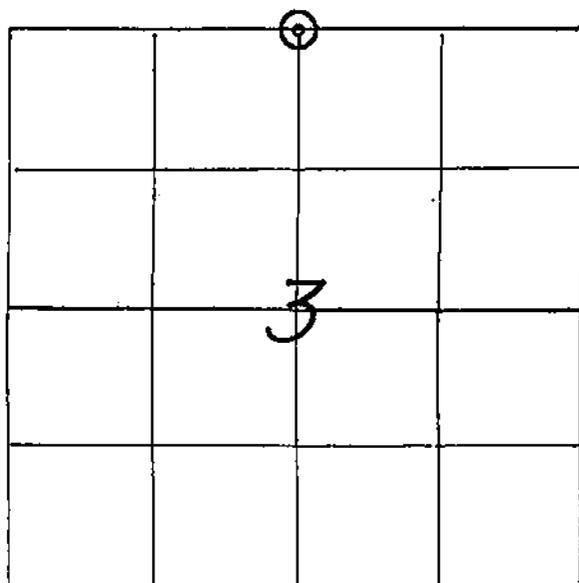

WISCONSIN COORDINATE SYSTEM
North
East
Theta Angle
Horiz. Order
Vert. Order
TYPE OF LANDMARK
<i>PK. NAIL OVER ROTTED BERNTSEN.</i>
BEARINGS ARE REFERENCED TO

LOCATION OF LANDMARK
 CREW: WILLIAM C. JUNG
 PETER F. FOLLANSBEE
 DATE: 6/29/1999

Describe any record evidence, monument evidence, testimonial evidence or any other material evidence you considered and whether the monument was found or restored through acceptance of an obliterated evidence location.


We found the Berntsen marker partially rotted. We repacked the hole and set a PK. nail over the marker.

Describe or show any material discrepancy between the location of the restored corner and that of the corner previously restored or reestablished.

NONE KNOWN.

RECORD OF DURABLE WITNESS MONUMENTS

NO	DESCRIPTION	BEARING	DISTANCE
1	EXISTING IRON PIPE ON R/W (DOWN 14"s)	WEST ±	44.04 FT.
2	N.E.-COR. OF 2-1/2' x 3-1/4' PAD FOR "ALPHA" UTILITY BOX	S. WESTERLY ±	60.79 FT.
3	NORTHERLY CORNER OF BARN AT GROUND	S 15° W (MAG.)	SLOPE = 154.85'
4	WESTERLY CORNER OF SHED (WOOD CORNER)	S 63-1/2° E (MAG.)	SLOPE = 54.98'

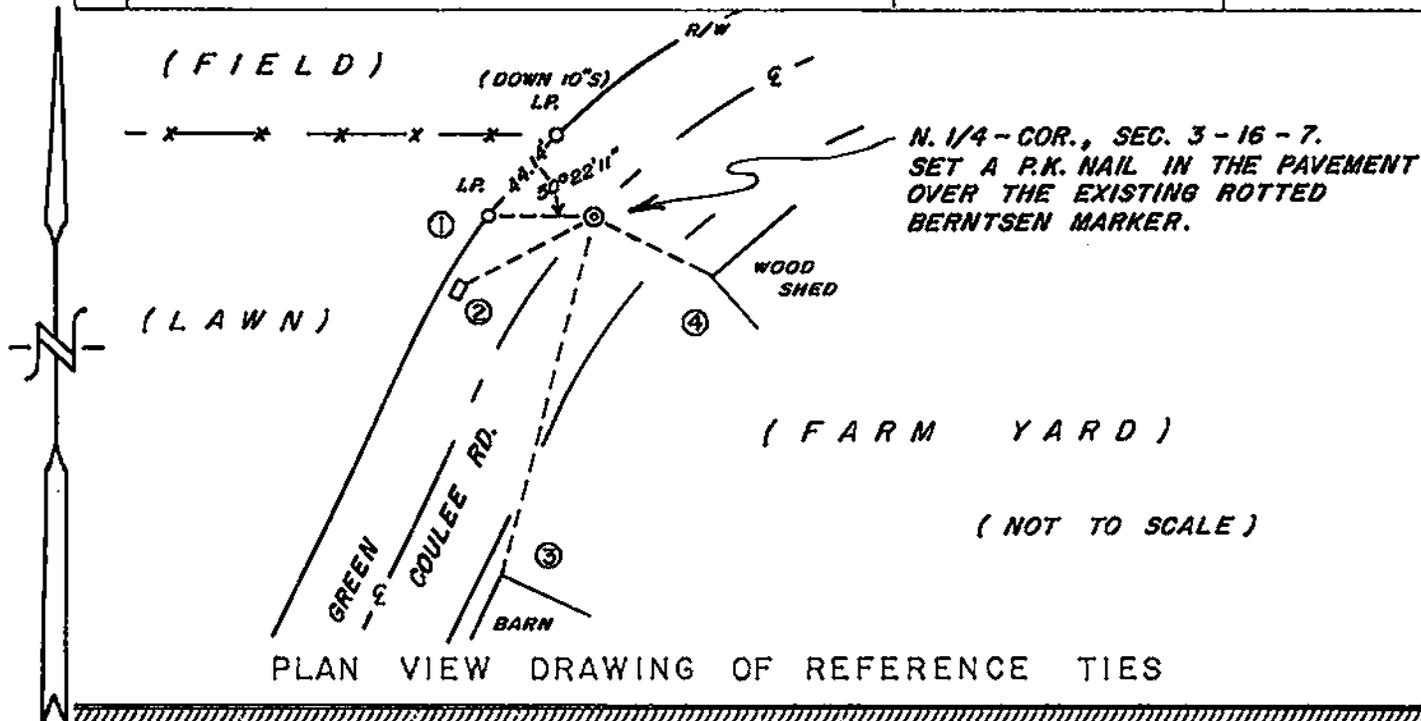

MAP SHOWING DISTANCE AND DIRECTION TO OTHER PUBLIC LAND SURVEY CORNERS USED FOR REESTABLISHING THE CORNER

No section measurements were made by me at this time. The location of this marker was confirmed previously by others.

I, WILLIAM C. JUNG, COUNTY SURVEYOR
HEREBY CERTIFY THAT THE CORNER LOCATION SHOWN ON THIS RECORD WAS DETERMINED BY ME OR UNDER MY DIRECTION AND CONTROL AND THAT THIS U. S. PUBLIC LAND SURVEY MONUMENT RECORD IS CORRECT AND COMPLETE TO THE BEST OF MY KNOWLEDGE AND BELIEF.

William C. Jung 7/20/99
Signature Date




Seal

 U. S. PUBLIC LAND SURVEY MONUMENT RECORD

 SECTION 3 T 16 N, R 7 W, TOWN OF ONALASKA

LA CROSSE COUNTY

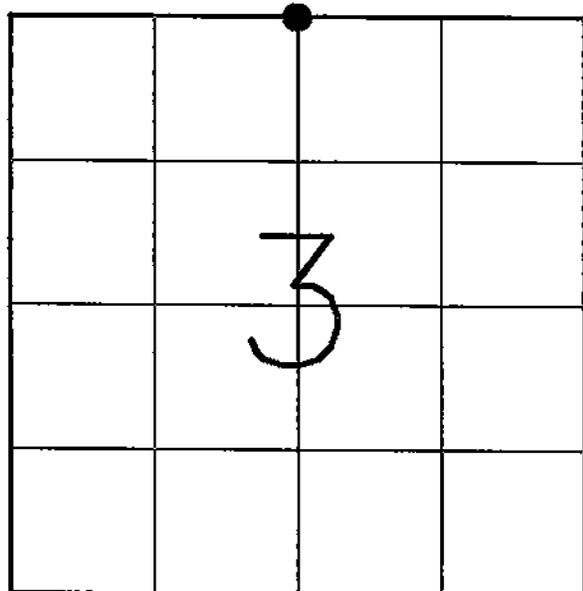

LOCATION OF LANDMARK


WISCONSIN COORDINATE SYSTEM	
NORTH	163103.62
EAST	458704.57
THETA ANGLE	
HORIZ. ORDER	
VERT. ORDER	
TYPE OF LANDMARK	
BEARINGS ARE REFERENCE TO LA CROSSE COUNTY COORDINATE SYSTEM (UNLESS OTHERWISE NOTED)	

DESCRIBE ANY RECORDED EVIDENCE, MONUMENT EVIDENCE, TESTIMONIAL EVIDENCE, OR ANY OTHER MATERIAL EVIDENCE YOU CONSIDERED AND WHETHER THE MONUMENT WAS FOUND OR RESTORED THROUGH ACCEPTANCE OF AN OBLITERATED EVIDENCE LOCATION.

PREVIOUSLY SURVEYED LUNDE MARKER AT QUARTER CORNER WAS DESTROYED DURING RE-CONSTRUCTION OF GREEN COLLEE ROAD. WE RE-SET CORNER AT PREVIOUS LOCATION.



DESCRIBE OR SHOW ANY MATERIAL DISCREPANCY BETWEEN THE LOCATION OF THE RESTORED CORNER AND THAT OF THE CORNER PREVIOUSLY RESTORED OR REESTABLISHED.

NONE

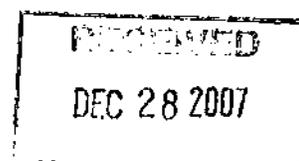

RECORD OF DURABLE WITNESS MONUMENT


NO	DESCRIPTION	BEARING	DISTANCE
1	1 1/4" IRON BAR (PLAT BLOCK CORNER)	S 70°49'06" W	59.16
2	SET 3/4" IRON BAR AT TOP BACK OF CURB	S 11°13'36" W	41.10
3	3/4" IRON BAR (PLAT P.C.)	N 33°40'18" E	118.89
4	SET 3/4" IRON BAR AT TOP BACK OF CURB	N 59°24'13" E	115.88

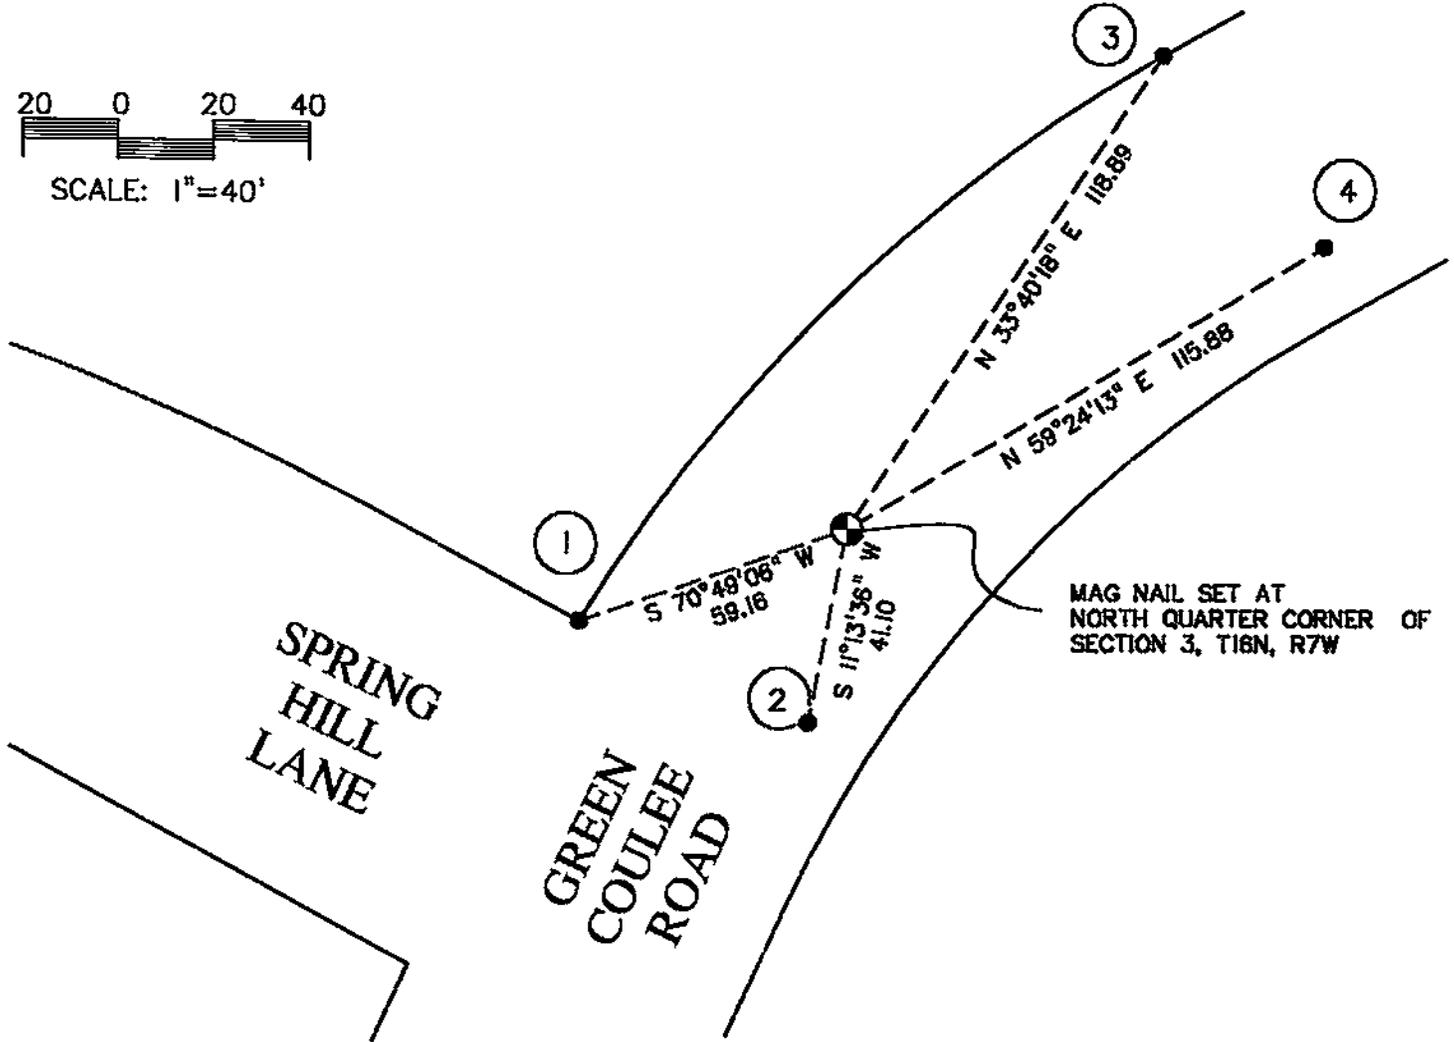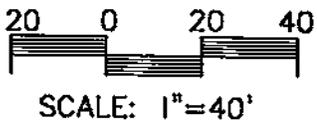

PLAN VIEW DRAWING OF REFERENCE TIES

MAP SHOWING DISTANCE AND DIRECTION TO OTHER PUBLIC LAND SURVEY CORNER USED FOR REESTABLISHING THE CORNER.

I, PAUL E. FAIRCHILD HEREBY CERTIFY THAT THE CORNER LOCATION SHOWN ON THIS RECORD WAS DETERMINED BY ME OR UNDER MY DIRECTION AND CONTROL AND THAT THIS U.S. PUBLIC LAND SURVEY MONUMENT IS CORRECT AND COMPLETE TO THE BEST OF MY KNOWLEDGE AND BELIEF.

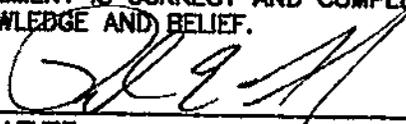
 SIGNATURE _____ DATE 12/27/07

