


## U. S. PUBLIC LAND SURVEY MONUMENT RECORD

SECTION 34 T 17 N, R 7 W, TOWN OF ONALASKA

LA CROSSE COUNTY

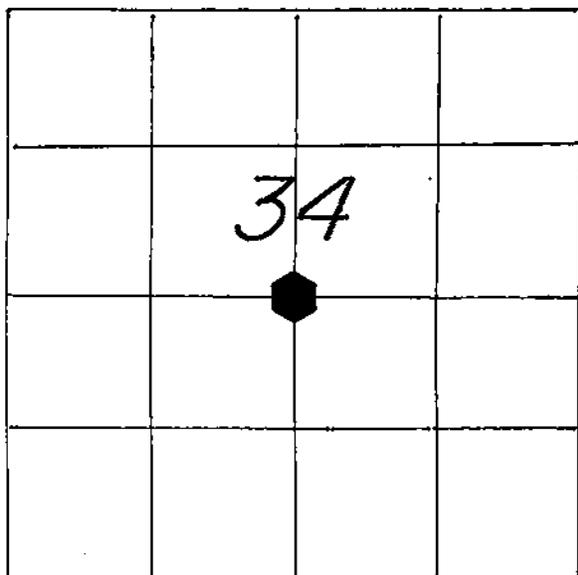

LOCATION OF LANDMARK

CREW: WILLIAM C. JUNG  
 PETER F. FOLLANSBEE  
 DATE: 4/10/2000.

WISCONSIN COORDINATE SYSTEM

North

East

Theta Angle

Horiz. Order

Vert. Order

TYPE OF LANDMARK

**BERNTSEN TOP IN EXISTING IRON PIPE.**

BEARINGS ARE REFERENCED TO

Describe any record evidence, monument evidence, testimonial evidence or any other material evidence you considered and whether the monument was found or restored through acceptance of an obliterated evidence location.

Charlie Pierce said that when he was a small boy, maybe 70 years ago or so, his father showed a stone to Charlie and his brother. His father told the boys that it was the corner. Joe Murphy found this stone at the occupied corner and replaced it with an iron pipe. This was used as the corner in several subsequent surveys.

I accepted this corner as the Center 1/4 corner. It does not appear to be at the


true corner, but I believe that it was set in an unrecorded survey many years in the past. Describe or show any material discrepancy between the location of the restored corner and that of the corner previously restored or reestablished. \*\*\*\*\*

**NONE KNOWN.**

\*\*\*\*\* We have found other unrecorded stones in T17N-R7W. Also, almost all of the county surveyor records have been lost.

RECORD OF DURABLE WITNESS MONUMENTS  
MAGNETIC

NO	DESCRIPTION	BEARING	DISTANCE
1	EXISTING IRON PIPE WEST OF A FENCE	NORTH ±	115.64 FT.
2	SET A NAIL IN S.W.-SIDE OF A 17-1/2" BASSWOOD	S 66° E	20.95 FT.
3	SET A NAIL IN N.W.-SIDE OF A 14" OAK	S 13° W	38.01 FT.
4	SET A NAIL IN N.W.-SIDE OF A 22" OAK	S 30° W	28.81 FT.

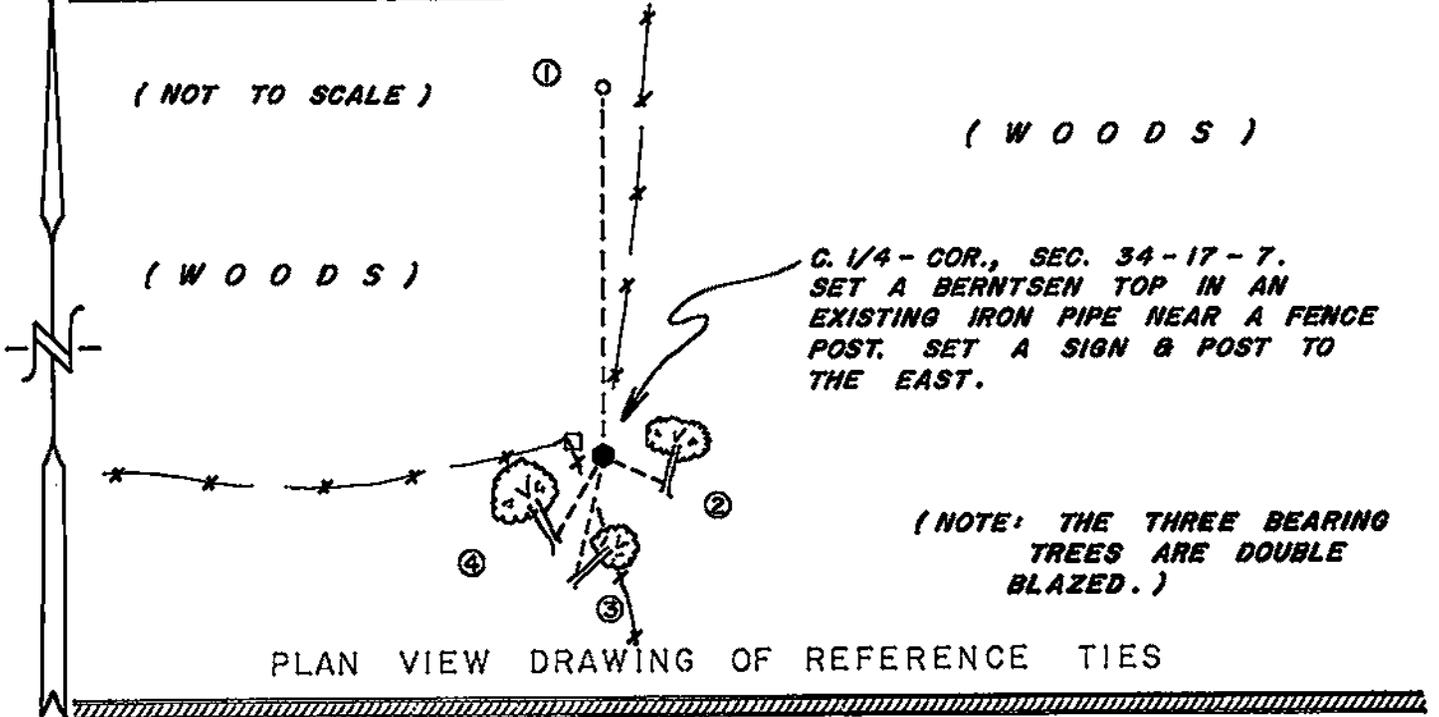


MAP SHOWING DISTANCE AND DIRECTION TO OTHER PUBLIC LAND SURVEY CORNERS USED FOR REESTABLISHING THE CORNER

I did not make any section measurements at this time. Tom Granum of Davy Engr. however did measure up much of the section. With this and other recorded survey data, we were able to analyze the position of this corner. Based on its history and location, we both agreed that the pipe should be accepted as the corner.

I, WILLIAM C. JUNG, COUNTY SURVEYOR  
HEREBY CERTIFY THAT THE CORNER LOCATION SHOWN ON THIS RECORD  
WAS DETERMINED BY ME OR UNDER MY DIRECTION AND CONTROL AND  
THAT THIS U. S. PUBLIC LAND SURVEY MONUMENT RECORD IS CORRECT  
AND COMPLETE TO THE BEST OF MY KNOWLEDGE AND BELIEF.

William C. Jung 6/13/00  
Signature Date

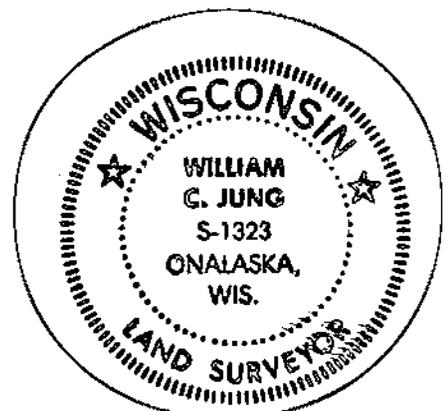

Seal