

#65

21708120000

William C. Jung, County Surveyor
LA CROSSE COUNTY, WISCONSIN

Administrative Center
400 4th Street North • La Crosse, Wisconsin 54601-3200



To Whom It May Concern:

On October 30, 2003, I removed the Berntsen marker at the Southeast Corner of Section 12, T17N-R8W, due to pending construction. While removing the marker, we dug up remnants of an old wood post. On October 19, 2004, we returned to the site and found construction continuing. On both dates we conducted further ground control traverses. On October 20, 2004 we ran a GPS mission on this control. All of this data is on file in County Surveyor work file #280. On August 29, 2006 we again returned to the site and found that the corner could not be set as it now falls within a house. The 1983(91) SPC's on this corner are:

715,333.197
1,634,025.571




William C. Jung
County Surveyor
9/12/06

U. S. PUBLIC LAND SURVEY MONUMENT RECORD

SECTION 18 T 17 N, R 7 W, TOWN OF ONALASKA

LA CROSSE COUNTY

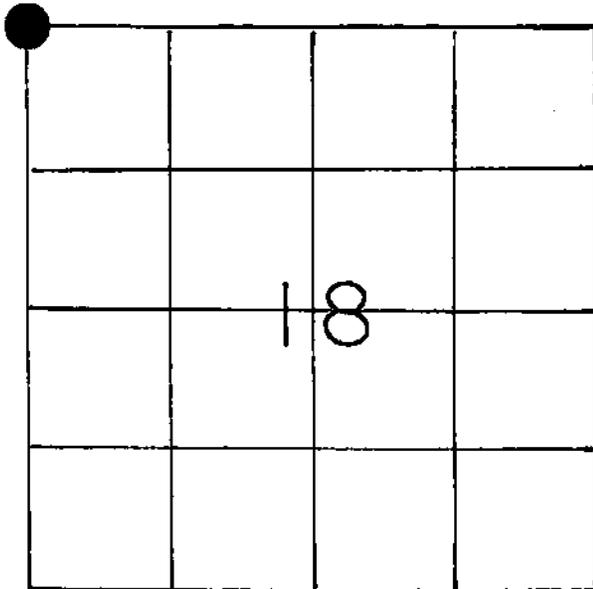

LOCATION OF LANDMARK

Crew: WILLIAM C. JUNG
 RON HAYDEN
 PETER F. FOLLANSBEE

Date: 6/29/1988

Describe any record evidence, monument evidence, testimonial evidence or any other material evidence you considered and whether the monument was found or restored through acceptance of an obliterated evidence location.

I found an iron pipe at the corner and set a 14" Berntsen top in the pipe. The pipe had been used as the corner in previous surveys. I accepted the pipe as the best available evidence of the original government corner position.

Describe or show any material discrepancy between the location of the restored corner and that of the corner previously restored or reestablished.

None known.

WISCONSIN COORDINATE SYSTEM

North

East

Theta Angle

Horiz. Order

Vert. Order


TYPE OF LANDMARK

SET BERNTSEN TOP IN EX. 1 1/2" I.P.

BEARINGS ARE REFERENCED TO

RECORD OF DURABLE WITNESS MONUMENTS

NO	DESCRIPTION	MAGNETIC	
		BEARING	DISTANCE
1	Set 1" I.P. Flush & Centered Betw. P.P.	S 81° E	106.66 Ft.
2	Set P.K. Nail in 11" Jack Oak (Dbl. Blz)	N 39° W	26.77 Ft.
3	Set P.K. Nail in 6" Black Oak (Unblazed)	N 11° W	81.04 Ft.
4	SE-Corner of Power Pedestal (Trem. Elt)	N 06° W	3.10 Ft.

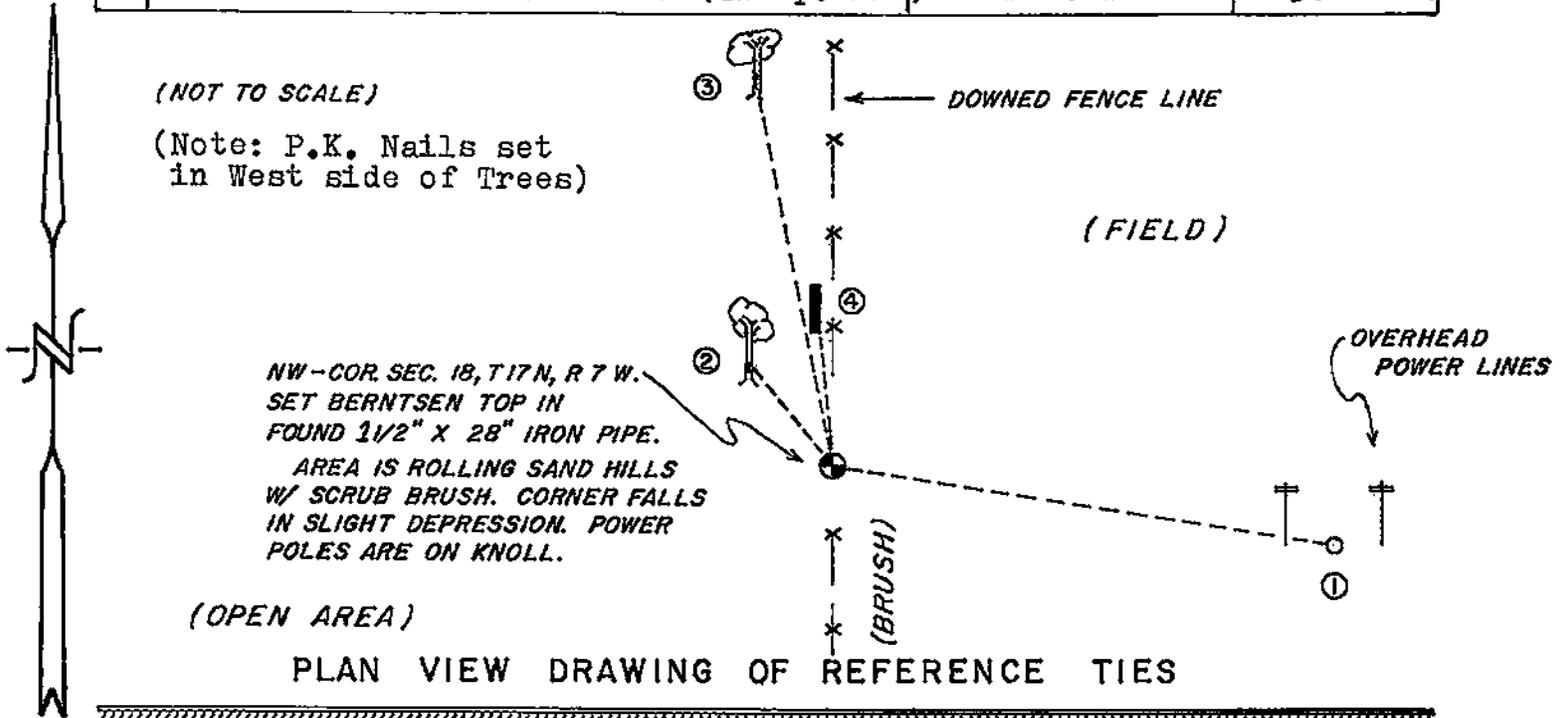

MAP SHOWING DISTANCE AND DIRECTION TO OTHER PUBLIC LAND SURVEY CORNERS USED FOR REESTABLISHING THE CORNER

No measurements were made by me at this time, although previous measurements made by others confirm the corner location.

I, William C. Jung, Deputy County Surveyor
HEREBY CERTIFY THAT THE CORNER LOCATION SHOWN ON THIS RECORD
WAS DETERMINED BY ME OR UNDER MY DIRECTION AND CONTROL AND
THAT THIS U. S. PUBLIC LAND SURVEY MONUMENT RECORD IS CORRECT
AND COMPLETE TO THE BEST OF MY KNOWLEDGE AND BELIEF.

William C. Jung
Signature

August 5, 1988
Date



Seal