


U. S. PUBLIC LAND SURVEY MONUMENT RECORD

SECTION 7 T 17 N, R 7 W, TOWN OF HOLLAND/VILL. OF HOLMEN
 LA CROSSE COUNTY

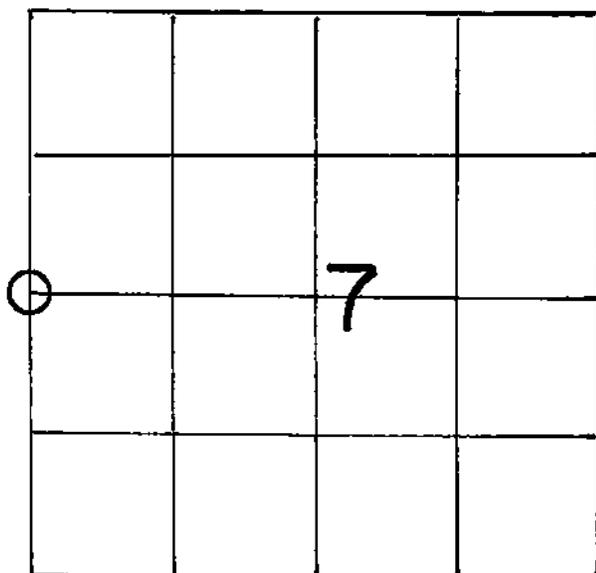

LOCATION OF LANDMARK

WISCONSIN COORDINATE SYSTEM
North
East
Theta Angle
Horiz. Order
Vert. Order
TYPE OF LANDMARK
Set 1 5/8" x 6' Iron Pipe.
BEARINGS ARE REFERENCED TO

Crew: WILLIAM C. JUNG
 PETER F. FOLLANSBEE

Date: 7/26/1993

Describe any record evidence, monument evidence, testimonial evidence or any other material evidence you considered and whether the monument was found or restored through acceptance of an obliterated evidence location.

I found an iron pipe at the old occupied corner that had been used as the corner in many previous surveys. I accepted this point as the best available evidence of the original government corner position. Because of the sand and nearby steep embankment, I replaced the existing pipe with a longer pipe.


Describe or show any material discrepancy between the location of the restored corner and that of the corner previously restored or reestablished.

None Known

RECORD OF DURABLE WITNESS MONUMENTS

MAGNETIC

NO	DESCRIPTION	BEARING	DISTANCE
1	Ex. P.K. Nail NE-side NE-trunk quadruple Oak(9")	N 73° W	21.18 Ft.
2	Set P.K. Nail in NE-side 3½" Oak	N 56° W	19.08 Ft.
3	Set P.K. Nail in NE-side 5" Oak	N 45° W	4.35 Ft.
4	Set P.K. Nail in NE-side 4" Oak	N 11° W	18.35 Ft.

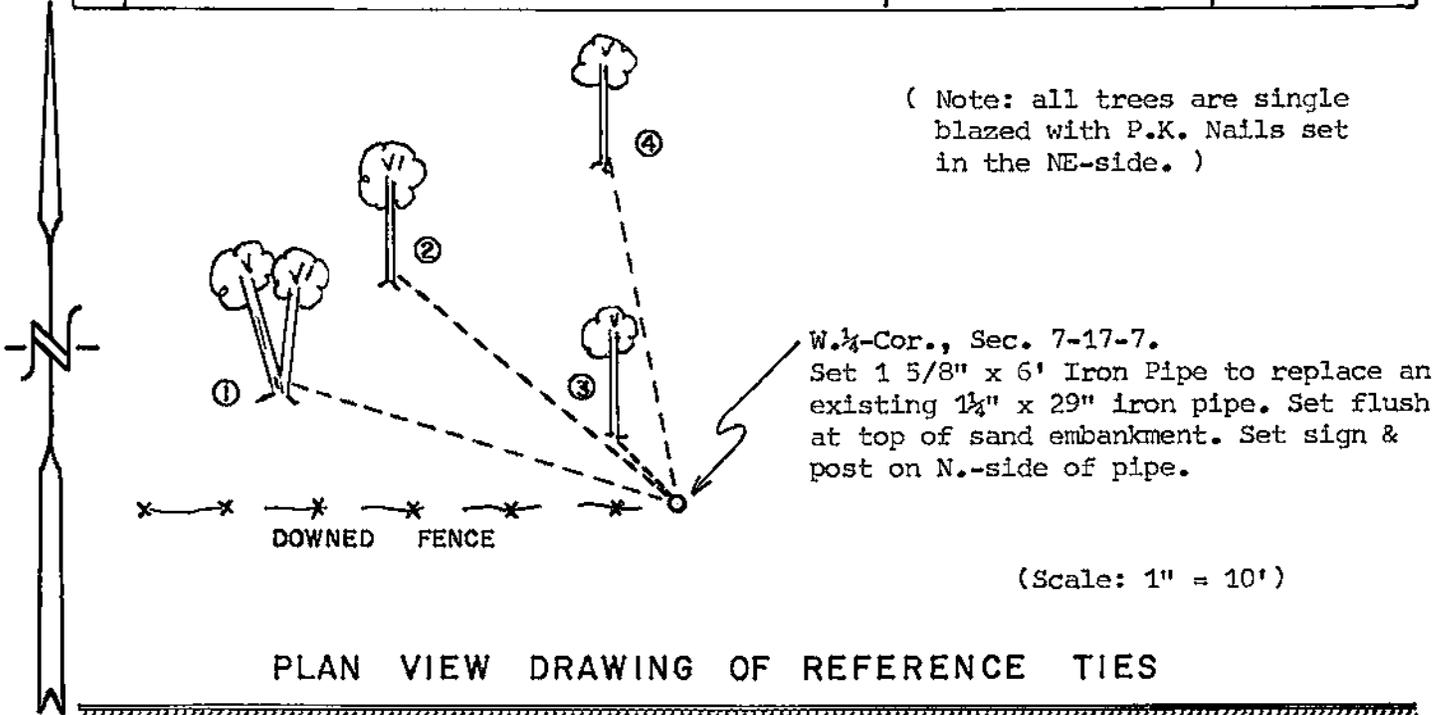


MAP SHOWING DISTANCE AND DIRECTION TO OTHER PUBLIC LAND SURVEY CORNERS USED FOR REESTABLISHING THE CORNER

No section measurements made by me at this time. Position confirmed by previous survey measurement.

I, William C. Jung, County Surveyor
 HEREBY CERTIFY THAT THE CORNER LOCATION SHOWN ON THIS RECORD WAS DETERMINED BY ME OR UNDER MY DIRECTION AND CONTROL AND THAT THIS U. S. PUBLIC LAND SURVEY MONUMENT RECORD IS CORRECT AND COMPLETE TO THE BEST OF MY KNOWLEDGE AND BELIEF.

William C. Jung 1/13/94
 Signature Date

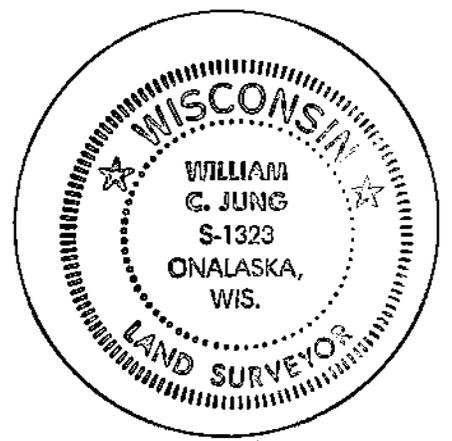

Seal