


21708130000

## U. S. PUBLIC LAND SURVEY MONUMENT RECORD

SECTION 19 T 17 N, R 7 W, TOWN OF Onalaska

LA CROSSE COUNTY

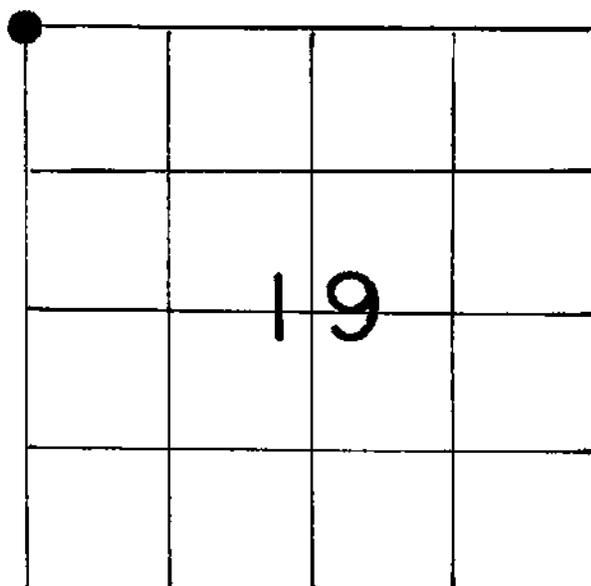

LOCATION OF LANDMARK

Crew: WILLIAM C. JUNG  
PETER F. FOLLANSBEE

Date: 12/05/1988

Describe any record evidence, monument evidence, testimonial evidence or any other material evidence you considered and whether the monument was found or restored through acceptance of an obliterated evidence location.

I set the corner on line between the West 1/4 Corner of Section 18 and the Southwest Corner of Section 19, and 43.11' South of Watts' reference pipe. This fits the occupied line coming from the West and Watts' section line coming from the East. Given the field evidence, this also fits the distances best North-South on the old government town line. I searched the area at great length but found no other evidence of the corner. I set a brass capped Lunde, down 18", out in a field.

Describe or show any material discrepancy between the location of the restored corner and that of the corner previously restored or reestablished.

I probably do not agree with Watts in East-West direction. My corner will fall approximately 2' East of his.

WISCONSIN COORDINATE SYSTEM

North

East

Theta Angle

Horiz. Order

Vert. Order

TYPE OF LANDMARK

SET BRASS CAP LUNDE MARKER


BEARINGS ARE REFERENCED TO

ASSUMED NORTH

**RECORD OF DURABLE WITNESS MONUMENTS  
MAGNETIC**

NO	DESCRIPTION	BEARING	DISTANCE
1	Set P.K. Nail in SW-side of 33" Cottonw'd	N 40 W	92.23 Ft.
2	Set P.K. Nail in SW-side of 7" Hickory(?)	N 53 W	86.53 Ft.
3	Set P.K. Nail in SW-side of 29" Cottonw'd	N 63 W	70.51 Ft.
4	Dist. to center of 45" Cottonw'd(No P.K.)	N 33 W	48 Ft. ±

(all trees are unblazed)

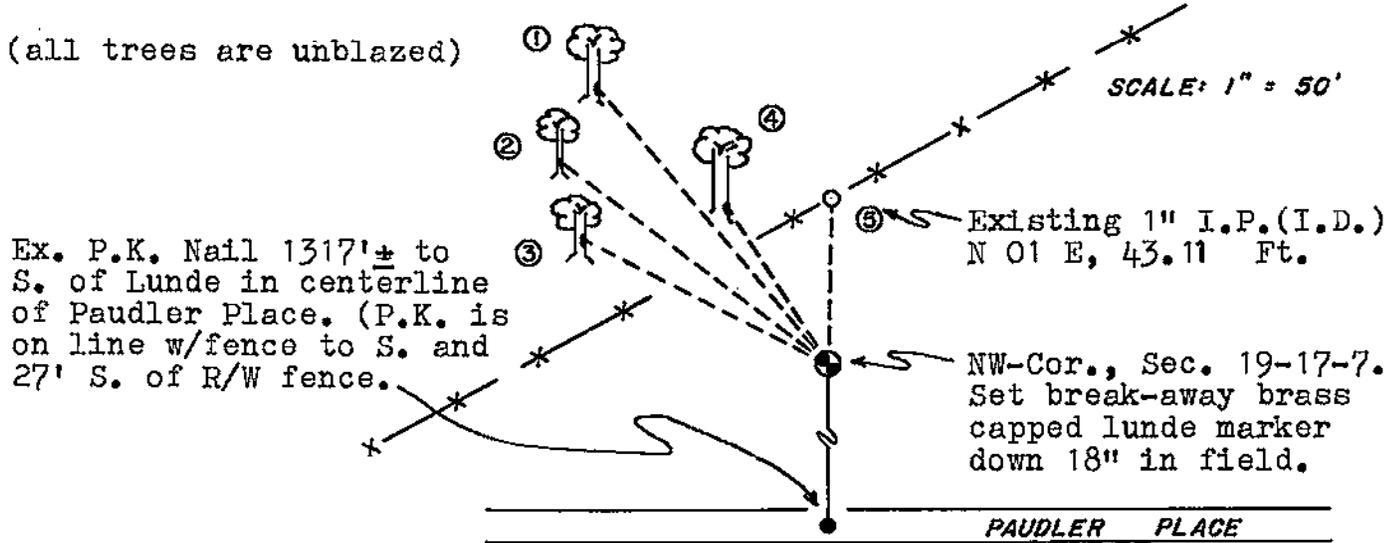


PLAN VIEW DRAWING OF REFERENCE TIES

**MAP SHOWING DISTANCE AND DIRECTION TO OTHER PUBLIC LAND SURVEY CORNERS USED FOR REESTABLISHING THE CORNER**

(not to scale)

(as per Terry Kerwin's measurements)

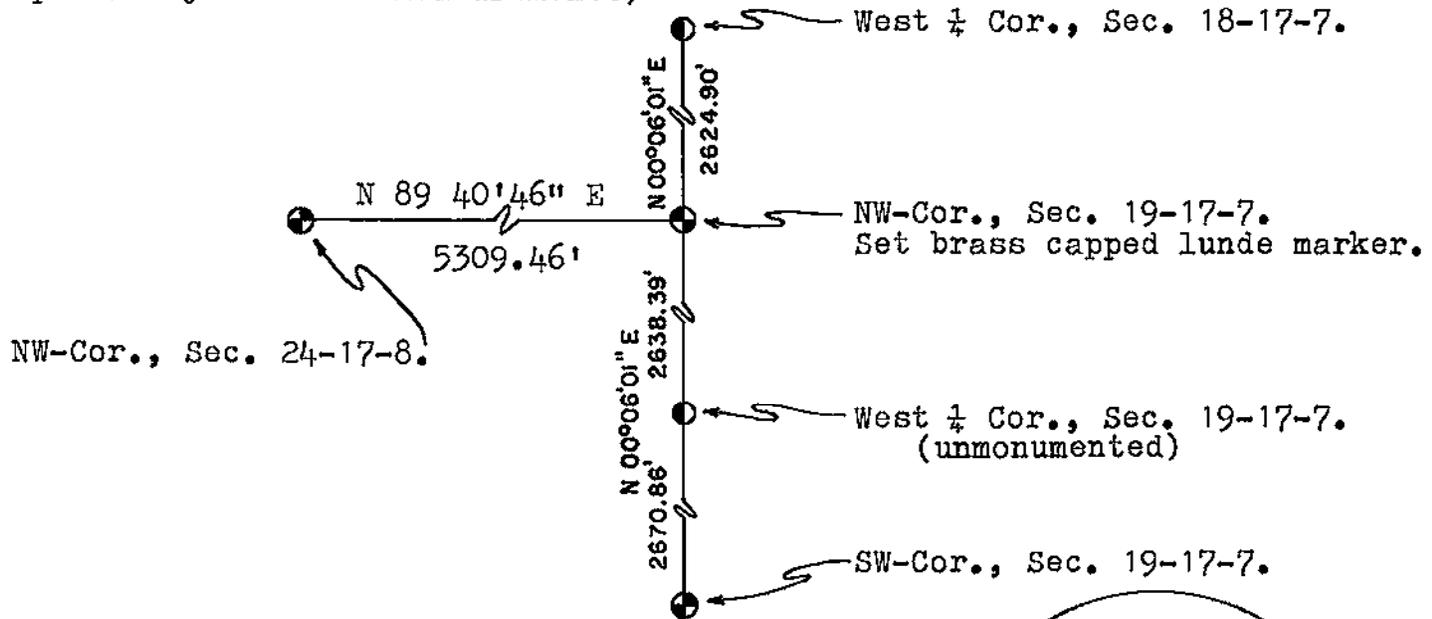

I, William C. Jung, Deputy County Surveyor  
HEREBY CERTIFY THAT THE CORNER LOCATION SHOWN ON THIS RECORD WAS DETERMINED BY ME OR UNDER MY DIRECTION AND CONTROL AND THAT THIS U. S. PUBLIC LAND SURVEY MONUMENT RECORD IS CORRECT AND COMPLETE TO THE BEST OF MY KNOWLEDGE AND BELIEF.

William C. Jung 1/17/89  
Signature Date



Seal